

MOUNTAIN-PLAINS CONSORTIUM

MPC 20-423 | D. Turner, J. van de Lindt, and B. Senior

Reducing Flood
Vulnerability of
Communities with Limited
Road Access by Optimizing
Bridge Elevation



A University Transportation Center sponsored by the U.S. Department of Transportation serving the Mountain-Plains Region. Consortium members:

Colorado State University
North Dakota State University
South Dakota State University

University of Colorado Denver
University of Denver
University of Utah

Utah State University
University of Wyoming

Reducing Flood Vulnerability of Communities with Limited Road Access by Optimizing Bridge Elevation

David Turner

John W. van de Lindt

Bolivar Senior

Civil & Environmental Engineering

Colorado State University

Fort Collins, CO

October 2020

Acknowledgements

I would like to thank Dr. van de Lindt and Dr. Senior for giving me the opportunity to work on this project. This thesis would not have been possible without the help and guidance of my advisor and co-advisor. Thank you to my thesis committee member, Dr. Atadero, for your time and support, which played an essential role in the success of this project and my master's degree.

Bob Jarrett is appreciated for his time and for helping me understand the hydrology aspect of my thesis. The author is also thankful to Steven Griffin for providing the construction drawings and helping define a criterion for elevation adjustments.

The utmost appreciation is given to Mohammad Amini. I would not have made it without his help and support. Last but not least, I would like to thank my parents for their encouragement throughout this project.

Disclaimer

The contents of this report reflect the views of the authors, who are responsible for the facts and accuracy of the data presented herein. The contents do not necessarily reflect the official views of the Mountain Plains Consortium. This report does not constitute a standard, specification, or regulation. Any information contained herein should be used at the users own risk.

NDSU does not discriminate in its programs and activities on the basis of age, color, gender expression/identity, genetic information, marital status, national origin, participation in lawful off-campus activity, physical or mental disability, pregnancy, public assistance status, race, religion, sex, sexual orientation, spousal relationship to current employee, or veteran status, as applicable. Direct inquiries to: Vice Provost, Title IX/ADA Coordinator, Old Main 201, 701-231-7708, ndsuoaaa@ndsuo.edu.

ABSTRACT

On September 11-17, 2013, Colorado suffered devastating and widespread flash flooding over 150 miles from Colorado Springs north to Fort Collins, impacting 24 counties. The flood damaged several bridges and over 400 miles of state roads. As a result of the transportation damage, residents of Drake, Colorado, were isolated and had to be evacuated via helicopter. This thesis aims to determine the failure risk associated with the inundation of bridge superstructures.

A linear network of eight bridges near Drake, Colorado, was selected for analysis, which includes three unique structural configurations. Flood analysis was performed using the design equations presented by Kerényi et al. (2009), which follows the same equation format listed in AASHTO. Fragilities were developed for the most critical internal and external composite girders for each bridge. The results obtained from fragility analysis were then used to determine the elevation adjustments needed to reach a target beta value of 3.5. Based on the analysis conducted in this thesis, it was found that the forces associated with bridge deck inundation, more specifically, in fast-moving mountain rivers is substantial and must be considered in design. Currently, bridge superstructures are designed based on the 100-year flood, which in the case of the bridges in this study, would not have resulted in any inundation of the bridge deck at the time of construction based on the knowledge at that time. To counter this, bridge superstructures should be designed based on the 500-year flood, which would incorporate inundation forces in the initial design. The methodology presented in this thesis can be used to assess and improve the flood vulnerability for any communities' bridge network.

TABLE OF CONTENTS

1. INTRODUCTION.....	1
1.1 Literature Review	5
2. FRAGILITY MODELING	11
2.1 Fragility Analysis	11
2.2 Limit States.....	12
2.3 Resistance Statistics.....	13
2.4 Hydraulic Modeling.....	14
2.5 Flood Frequency Analysis.....	18
2.6 Finite Element Modeling.....	21
2.7 Procedure.....	25
3. RESULTS AND DISCUSSION	27
3.1 Bridge C-15-AM results	27
3.2 Bridge C-15-AL results	36
3.3 Bridge C-15-O results.....	44
3.4 Bridge C-15-U results.....	51
3.5 Bridge C-15-Y results.....	58
3.6 Bridge C-15-C results.....	64
3.7 Bridge C-15-AN results.....	69
3.8 Bridge C-16-DI Results	75
4. CONCLUSIONS, CONTRIBUTIONS AND RECOMMENDATIONS	82
REFERENCES.....	85
APPENDIX A. CONSTRUCTION DRAWINGS	87
APPENDIX B. LOGNORMAL PARAMETERS FOR NEGATIVE MOMENT FRAGILITIES..	143

LIST OF TABLES

Table 1.1	Estimate of September 2013 peak discharge return interval (Generated from Jacobs, 2014)	2
Table 1.2	Reliability index and probability of failure values	10
Table 2.1	Statistical information for the variables used in the monte carlo simulation	13
Table 2.2	Log Pearson type III distribution fitted parameters used for the hazard probabilities.....	19

LIST OF FIGURES

Figure 1.1	Precipitable water data from the weather balloon in Denver as collected from 1948-2012 ..3	
Figure 1.2	Topography the Big Thompson Canyon with elevations ranging from 8100-7150 feet located slightly downstream from Estes Park at bridge C-15-AM	4
Figure 1.3	Plan view of the Big Thompson canyon with bridges and other key features labeled.....	4
Figure 1.4	Scaled six-girder bridge deck used in the development of the force coefficients with the dimensions and forces labeled (Kerenyi et al. 2009)	6
Figure 1.5	Drag coefficient vs. inundation ratio for the six-girder bridge (Kerenyi et al. 2009)	7
Figure 1.6	Lift coefficient vs. inundation ratio for the six-girder bridge (Kerenyi et al. 2009)	8
Figure 1.7	Moment coefficient vs. inundation ratio for the six-girder bridge (Kerenyi et al. 2009).....	8
Figure 1.8	An example of the applied net lift force on the bridge superstructures	15
Figure 1.9	Failure locations for the girders in this study.....	15
Figure 2.1	Example fragilities for illustration	12
Figure 2.2	Nominal moment capacity for an external girder for bridge C-15-Y.....	14
Figure 2.3	Cross section locations at a bridge (excerpted from Brunner, 2010)..	15
Figure 2.4	Geometric data plan view of HEC-RAS model for bridge C-15-AM.....	16
Figure 2.5	An example of the cross sections pulled from ArcMap with LiDAR data obtained from Colorado GeoData at bridge C-15-AM	17
Figure 2.6	The profile graph of the elevation data pulled from cross section 1 (the furthest right line on Figure 2.4.3).....	17
Figure 2.7	Applied negative moment for an external girder on bridge C-15-Y	20
Figure 2.8	Peak discharge profile for the Big Thompson River (Excerpted from Jacobs, 2014).....	21
Figure 2.9	Shell stresses for the modeling procedure check	22
Figure 2.10	Labeled example of SAP2000 elements used	23
Figure 2.11	Extruded view of bridge C-15-Y under the loading for $h^*=0.3$	24
Figure 2.12	Negative plastic moment capacity for an internal girder on bridge C-15-C	24
Figure 2.13	Flow chart of the procedure followed for calculating the beta values	26
Figure 3.1	Longitudinal view of C-15-AM (CDOT see Appendix A)	27
Figure 3.2	Cross sectional view of C-15-AM (CDOT see Appendix A)	27
Figure 3.3	Typical integral abutment layout (CDOT see Appendix A)	28
Figure 3.4	Cross sections generated in ArcMap for C-15-AM	29
Figure 3.5	HEC-RAS geometric plan view for C-15-AM.....	29
Figure 3.6	Plan rating curve for C-15-AM (CDOT see Appendix A).....	30
Figure 3.7	HEC-RAS generated rating curve for C-15-AM.....	30
Figure 3.8	SAP2000 model for C-15-AM.....	31
Figure 3.9	Plan view of C-15-AM (CDOT see Appendix A).....	31
Figure 3.10	Applied negative moment felt by girder G7 for C-15-AM	32
Figure 3.11	Negative nominal moment capacity for an external girder for C-15-AM.....	33
Figure 3.12	Fitted lognormal CDF function to the fragility values for C-15-AM.....	34
Figure 3.13	Hazard probabilities used to generate the probability of failure curve for C-15-AM	35
Figure 3.14	Probability of failure curve for C-15-AM.....	36
Figure 3.15	Longitudinal section of C-15-AL (CDOT see Appendix A).....	37
Figure 3.16	Cross sections generated in ArcMap for C-15-AL.....	37

Figure 3.17	HEC-RAS geometric plan view for C-15-AL.....	38
Figure 3.18	HEC-RAS rating curve for C-15-AL	39
Figure 3.19	SAP2000 model for C-15-AL	39
Figure 3.20	Plan view of the bridge deck for C-15-AL (CDOT see Appendix A)	40
Figure 3.21	Applied negative moment felt by girder G1 for C-15-AL	40
Figure 3.22	Negative nominal moment capacity for an external girder for C-15-AL.....	41
Figure 3.23	Fitted lognormal CDF function to the fragility values for C-15-AL.....	42
Figure 3.24	Hazard probabilities used to generate the probability of failure curve for C-15-AL	43
Figure 3.25	Probability of failure values for C-15-AL.....	43
Figure 3.26	Cross sections generated in ArcMap for C-15-O	44
Figure 3.27	HEC-RAS geometric plan view for C-15-O	45
Figure 3.28	Plan rating curve for C-15-O (CDOT see Appendix A)	46
Figure 3.29	HEC-RAS rating curve for C-15-O.....	46
Figure 3.30	SAP2000 model for C-15-O.....	47
Figure 3.31	Plan view of the bridge deck of C-15-O (CDOT see Appendix A)	47
Figure 3.32	Applied negative moment felt by G1 span 2 for C-15-O.....	48
Figure 3.33	Negative nominal moment capacity for an external girder for C-15-AL.....	49
Figure 3.34	Fitted lognormal CDF function to the fragility values for C-15-AM.....	49
Figure 3.35	Hazard probabilities used to generate the probability of failure curve for C-15-O.....	50
Figure 3.36	Probability of failure values for C-15-O	51
Figure 3.37	Cross sections generated in ArcMap for C-15-U	52
Figure 3.38	HEC-RAS geometric plan view for C-15-U	52
Figure 3.39	Plan rating curve for C-15-U (CDOT see Appendix A)	53
Figure 3.40	HEC-RAS rating curve for C-15-U.....	53
Figure 3.41	AP2000 model for C-15-U.....	54
Figure 3.42	Plan view of the bridge deck of C-15-U (CDOT see Appendix A)	54
Figure 3.43	Applied negative moment felt by G1 for C-15-U	55
Figure 3.44	Negative nominal moment capacity for an external girder for C-15-U	56
Figure 3.45	Fitted lognormal CDF function to the fragility values for C-15-U	56
Figure 3.46	Hazard probabilities used to generate the probability of failure curve for C-15-U.....	57
Figure 3.47	Probability of failure values for C-15-U	57
Figure 3.48	Cross sections generated in ArcMap for C-15-Y	58
Figure 3.49	HES-RAS geometric plan view for C-15-Y.....	59
Figure 3.50	Plan rating curve for C-15-Y (CDOT see Appendix A)	60
Figure 3.51	HEC-RAS rating curve for C-15-Y.....	60
Figure 3.52	SAP2000 model for C-15-Y.....	61
Figure 3.53	Plan view of the bridge deck of C-15-Y (CDOT see Appendix A)	61
Figure 3.54	Applied negative moment felt by G1/4 for C-15-Y	61
Figure 3.55	Negative nominal moment capacity for an external girder for C-15-Y	62
Figure 3.56	Fitted lognormal CDF function to the fragility values for C-15-Y	62
Figure 3.57	Hazard probabilities used to generate the probability of failure curve for C-15-Y.....	63
Figure 3.58	Probability of failure values for C-15-Y	63
Figure 3.59	Cross sections generated in ArcMap for C-15- C	64
Figure 3.60	HEC-RAS geometric plan view for C-15- C	65

Figure 3.61	HEC-RAS rating curve for C-15- C.....	65
Figure 3.62	SAP2000 model for C-15- C.....	66
Figure 3.63	Plan view of the bridge deck of C-15- C (CDOT see Appendix A)	66
Figure 3.64	Applied negative moment felt by G6 for C-15- C	67
Figure 3.65	Negative nominal moment capacity for an external girder for C-15- C	67
Figure 3.66	Fitted lognormal CDF function to the fragility values for C-15- C	68
Figure 3.67	Hazard probabilities used to generate the probability of failure curve for C-15- C.....	68
Figure 3.68	Probability of failure values for C-15- C	69
Figure 3.69	Cross sections generated in ArcMap for C-15- AN	70
Figure 3.70	HEC-RAS geometric plan view for C-15- AN	70
Figure 3.71	Plan rating curve for C-15- AN (CDOT see Appendix A).....	71
Figure 3.72	HEC-RAS rating curve for C-15- AN.....	71
Figure 3.73	SAP2000 model for C-15- AN.....	72
Figure 3.74	Plan view of the bridge deck of C-15- AN (CDOT see Appendix A)	72
Figure 3.75	Applied negative moment felt by G1 for C-15- AN	73
Figure 3.76	Negative nominal moment capacity for an external girder for C-15- AN	73
Figure 3.77	Fitted lognormal CDF function to the fragility values for C-15- AN	74
Figure 3.78	Hazard probabilities used to generate the probability of failure curve for C-15- AN.....	74
Figure 3.79	Probability of failure values for C-15- AN	75
Figure 3.80	Cross sections generated in ArcMap for C-16-DI.....	76
Figure 3.81	HEC-RAS rating curve for C-16-DI	76
Figure 3.82	Plan rating curve for C-16-DI (CDOT see Appendix A)	77
Figure 3.83	HEC-RAS rating curve for C-16-DI	77
Figure 3.84	SAP2000 model for C-16-DI	78
Figure 3.85	Plan view of the bridge deck of C-16-DI (CDOT see Appendix A).....	78
Figure 3.86	Applied negative moment felt by G6 span 2 for C-16-DI.....	79
Figure 3.87	Negative nominal moment capacity for an external girder for C-16-DI.....	79
Figure 3.88	Fitted lognormal CDF function to the fragility values for C-16-DI.....	80
Figure 3.89	Hazard probabilities used to generate the probability of failure curve for C-16-DI	80
Figure 3.90	Probability of failure values for C-16-DI.....	81
Figure 4.1	100 year flood beta values for all bridges	82
Figure 4.2	500 year flood beta values for all bridges	83

LIST OF SYMBOLS

A_{ps}	Area of prestressing steel
A_s	Area of mild steel
C_D	Drag coefficient
C_L	Lift coefficient
C_M	Moment coefficient
F_B	Buoyancy force
f'_c	Compressive strength of concrete
F_D	Drag force
F_L	Lift force
f_{ps}	yield stress of prestressing steel
f_y	yield stress of mild steel
g	gravity
h^*	Inundation ratio
M_{CG}	Moment about the center of gravity
R_n	Nominal capacity of a member
s	Deck thickness
W	Width of the bridge deck
V	Velocity
V_{dis}	Displaced volume of water
ρ	Density of water
ϕ	Resistance factor that takes into account material strength variability
γ	Load factor that takes into account the uncertainties in the load
$\Phi(\cdot)$	Standard normal cumulative distribution function
λ_R	Logarithmic mean of capacity R
ξ_R	Logarithmic standard deviation of capacity R

1. INTRODUCTION

During September 11–17, 2013, Colorado suffered devastating and widespread flash flooding, which spread 150 miles from Colorado Springs north to Fort Collins, impacting 24 counties. The flooding resulted in considerable erosion, realigning of stream channels, transport of rock and debris, failures of dams and impact to several residential and commercial structures (Jacobs, 2014). High-velocity floodwater resulted in 10 lives lost (Jacobs, 2014) and more than 18,000 people evacuated (Ulccellini, 2014). Approximately 19,000 homes and commercial buildings were damaged and more than 1,500 destroyed (Ulccellini, 2014). Also, an estimated 485 miles of roads and 50 bridges were damaged or destroyed in the impacted counties (Ulccellini, 2014).

The focus of this thesis is on the community of Drake, Colorado, located in Larimer County with a population of a little more than 1,000 people. Drake is located in the Big Thompson Canyon west of Loveland, Colorado. This flood isolated the community due to copious road and bridge damage along US 34 and County Road 43. As a result of the damage, the residents had to be evacuated via helicopter. This scenario led to the current research, focusing on what would be required to make the bridges along US 34 from Estes Park to the mouth of the canyon more resistant to flood damage, thereby improving the resiliency of Drake. The concept and approach used herein is focused on a specific community but could be applied to other similar small communities that rely on bridges in a series system.

The most recent flood frequency analysis for the Big Thompson River was completed in August 2014 by Jacobs Engineering Group. Based on the drainage basin characteristics, rainfall amounts and intensities measured during the storm, the discharge estimates provided by Jacobs are greater than expected (Jacobs, 2014). This post assessment by Jacobs and field observations by Bob Jarrett led to the conclusion that dam failures, which include woody debris dams, road-embankments, beaver dams, stock ponds, and landslides played a large role in the September 2013 flood (Jacobs, 2014). This assessment was verified by post-flood aerial imagery. The images showed evidence of dam failures, mostly from debris flow, but there were also signs of releasing of groundwater caused by landslides (Jacobs, 2014).

The Intergovernmental Panel on Climate Change (IPCC) found that the intensity of rain events, specifically the proportion of total precipitation that falls during lower probability events, has increased, and it is plausible that the proportion will continue to rise in the future (Solomon et al. 2007). The IPCC concluded that higher precipitation intensity could also increase the risk of flooding (Parry et al. 2007). In 1981, effective regulatory flow rates documented by the Federal Emergency Management Agency (FEMA) in the 2013 Flood Insurance Study (FIS) were developed (Jacobs, 2014). These discharges were used for Larimer County to designate the 100-year floodplain and informed bridge construction decisions. A 100-year event is described as having a 1 in 100 or 1% chance of occurring in any given year. The most recent hydrologic evaluation of the Big Thompson watershed, completed in August 2014, produced larger discharges for the 100- and 500-year flood on the order of 1,400 to 8,000 cubic feet per second (cfs) respectively (Jacobs, 2014). However, for the 10- and 50-year storms, the discharges were lower than the FIS values. Over a span of 33 years, the discharge values for the lower probability events increased by 13.5% for the 100-year flood discharge and 46.7% for the 500-year discharge. If this trend continues to increase, it will have catastrophic effects on the current infrastructure.

An analysis by Wright et al. (2012) found that approximately one-fourth of the more than 500,000 bridges in the National Bridge Database are currently deficient and therefore are more vulnerable to climate change than other bridges (Wright et al., 2012). The total cost for adjusting bridges in response to the threats from climate change throughout the course of the 21st century vary from approximately \$140 billion to \$250 billion (Wright et al., 2012). The large range of cost is attributed to the emissions scenario and assumptions about adaptation. Only rainfall amounts were allowed to change in the analysis. Consequently, no land use changes were altered, and all other hydrologic conditions were assumed to

remain unchanged (Wright et al., 2012). There were several assumptions made in the estimate, which leads to the numbers provided being quite conservative. Nonetheless, the estimate provides an implication of the potential effect of climate change to bridges in the United States.

This region of Colorado is no stranger to destructive flash floods. The 1976 Big Thompson Canyon flood resulted in discharge values at the mouth of the canyon on the order of a 500-year flood event. In comparison, the 2013 flood resulted in discharge values at the mouth of the canyon around the 100-year flood event. However, the 2013 flood did result in discharge values close to a 500-year flood in some locations along the Big Thompson, as shown below in Table 1.1. The fact that two low probability flood events occurred within 37 years of one another demonstrates the importance of having infrastructure that can withstand the forces associated with floods.

Table 1.1 Estimate of September 2013 peak discharge return interval (Generated from Jacobs, 2014)

Location	Estimated Discharge (cfs)	Annual Change Peak Discharge (cfs)					Estimated Recurrence Interval (yr)
		10%	4%	2%	1%	0.2%	
Lake Estes	5,330	850	1,980	3,420	5,550	13,370	≈100
Big Thompson at Loveland Heights	9,300	940	2,180	3,750	6,060	14,520	100 to 500
Big Thompson above Drake	12,500	960	2,280	3,960	6,450	15,690	100 to 500
Big Thompson below Drake	14,800	2,120	4,540	7,500	11,800	26,990	100 to 500
Big Thompson at Mouth of Canyon	15,500	3,040	6,250	10,050	15,450	34,000	≈100
North Fort Big Thompson 4.5 miles above Drake	18,400	1,100	2,090	3,200	4,640	9,500	> 500
North Fork Big Thompson at Drake	5,900	1,540	2,870	4,340	6,240	12,600	≈100

The total sum of the flood-related damages is approximately \$2.9 billion (Aguilar, J., 2014). The majority of structure losses were uninsured due to damage being done outside of designated flood zones. Flood zones are denoted as areas that become inundated by a 100-year flood. Historically, the portion of homeowners who purchase flood insurance outside of designated flood zones is small. The total sum includes damage done to housing, infrastructure and economic sectors. Due to the scale of the flooding, the United States Department of Housing and Urban Development (HUD) issued notice of a \$62,800,000 allocation of federal recovery funds to the State of Colorado in December 2013 (Disaster Recovery, n.d.). These funds were allocated to assist recovery in the most impacted counties. FEMA designated 11 counties as Presidential Disaster Areas, which were to receive the funds. Boulder, Larimer, and Weld County were three of the hardest hit counties and received 80% of the funds (Disaster Recovery, n.d.). Floods rank second behind hurricanes in insurance-based loss estimates with \$7.97 billion per year (Hydrologic Information Center - Flood Loss Data, 2015). Loss estimates exclude damage done by coastal flooding caused by tropical cyclones and the monetary values are adjusted for inflation.

This flash flood event in northern Colorado came together through a collection of ingredients. The ground was saturated with heavy rainfall, there was a deep moisture source, a slow-moving pressure system was present and there was instability and lift in the atmosphere. On September 9 and 10, radar showed that parts of the Front Range picked up over one inch of rain both afternoons and evenings. This saturation prevented any further infiltration by ensuing rainstorms. Moisture present in the atmosphere is measured by the observed precipitable water (PW) values. These values represent the depth of water in the atmosphere that could condense and fall as rain. Values between 1.2 and 1.4 inches during the peak of the heavy rainfall events exceeded the all-time maximum values for September, as illustrated by Figure 1.1 (Ulccellini, 2014). The atmospheric state involved an upper-level low pressure center above the Great Basin, which due to a large dome of high pressure over the Pacific Northwest and southwest Canada was blocked from moving east or north (Erdman, J. 2013). This setup allowed moist air to be transported northward and westward from the Gulf of Mexico and the tropical east Pacific Ocean (Ulccellini, 2014). The presence of a stationary cold front brought about the initial instability. The combination of the stagnate low pressure center and the cold front generated the upslope flow along the foothills (Bolinger, 2013). This lift, instability and moisture combination lead to the 1,000-year rainstorm event starting from the higher elevations east of the Continental Divide, across the foothills and into the Front Range. It should be noted that a 1,000-year rainstorm event doesn't directly correlate to a 1,000-year flood event.

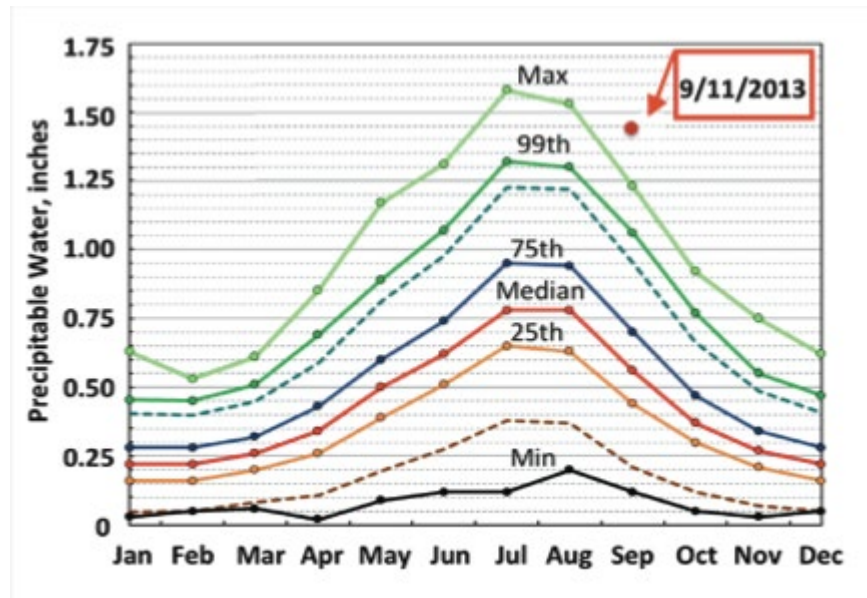


Figure 1.1 Precipitable water data from the weather balloon in Denver as collected from 1948-2012. The seasonal fluctuations are attributed to warm air being able to contain more water vapor (Excerpted from Colorado Climate Center, Bolinger, 2013).

The topography of the Drake is one of the most important factors as to why the community is so vulnerable to flooding. It is characterized by narrow valleys bordered by side slopes generally ranging from 10 to 80 percent (Figure 1.2). Rugged rock faces of even steeper slope occur at many locations along the canyon floors, which is most noticeable at the mouth of the canyon with near vertical faces. Soils are shallow, consisting of coarse material resulting from colluvial and alluvial processes (McCain et al., 1979). Soil grade varies from gravelly near the ridges to sandy gravel near stream levels. The Big Thompson River headwaters are located on the Continental Divide at an altitude of about 11,000 feet. The altitude of the area of interest from Estes Park to the mouth of the canyon ranges from 7,500 feet to 5,200 feet. Tributaries in the Big Thompson River basin west of Drake range in altitude from 7,000 feet to 9,000 feet with extremely steep gradients on the order of 700 feet per mile or a 13.2% slope (McCain et

al., 1979). The Big Thompson River streambed has gradients ranging from 31 feet per mile at Estes Park to 100 feet per mile at the mouth of the canyon, which is 0.6% to 1.8% slope. On the North Fork Big Thompson River, the average streambed gradient is 128 feet per mile in the reach between Glen Haven and Drake, which is a 2.4% slope (McCain et al., 1979). Combining the steep streambed with the lack of an escape for excessive flows leads to a community with high vulnerability to flooding.



Figure 1.2 Topography the Big Thompson Canyon with elevations ranging from 8100-7150 feet located slightly downstream from Estes Park at bridge C-15-AM. This was generated via ArcMap in combination with LiDAR data provided by Colorado GeoData.



Figure 1.3 Plan view of the Big Thompson canyon with bridges and other key features labeled

Figure 1.3 presents a plan view of Drake, Colorado, which is centralized at bridge C-15-Y, but the residents live along US 34 from Estes Park to the mouth of the canyon. The end goal of this research was to identify what elevations the most critical bridges would need to be raised to such that all eight bridges in the canyon along US 34 meet a target reliability criterion. While such an approach may not be cost effective or practical for an existing bridge network, it would prevent a future low probability flood from causing isolation of the residents of Drake, which serves as an example for future planning. Providing a uniform hazard for the bridges would ensure that the post flood construction be minimized and therefore not disrupt the flow of traffic due to closures. Cost would also be lowered due to the bridge components that would be undamaged. As shown from the figure, the residents only avenue of escape is via US 34 eastbound toward Loveland or westbound toward Estes Park. County road 43 running along the North

Fork Big Thompson River would potentially be an escape route; however, the damage suffered due to the September flood was catastrophic, which led to US 34 being the most flood resilient route available.

1.1 Literature Review

Bridges are vulnerable to water forces associated with extreme storms. These storms can cause mild to sometimes catastrophic damage to the bridge sub or superstructure. Many state departments of transportation have recognized this and ended numerous research efforts over the years to quantify said forces. This literature review will be divided into two sections: work related to flood forces on inundated bridge decks, and an overview on structural reliability.

Research into flood loads on bridge superstructures, more specifically bridge girders, was first conducted by Tainsh (1965). Tainsh (1965) analyzed the force on the girders of three and four girder bridges under the condition of partially submerged and totally submerged. The bridge deck elevation was adjusted such that the influence of the channel floor was negligible. Forces were calculated by measuring the pressure distribution on the girders located at the middle of the flume. Shear stresses along the surface of the bridge deck were not included. Testing was done on a scale model and the results were scaled up to the parent bridge using Froude similarity, with the assumption that the Reynolds number, R , was within the range of 4×10^4 to 5×10^5 .

Denson (1982) was the first to conduct an experimental study of the lift, drag, and moment coefficients on three different types of bridge decks under the condition of partially and fully submerged. Denson studied the force coefficients dependence on a bridge relative inundation depth, h/l , Froude number, $\frac{V}{\sqrt{gl}}$, and relative thickness of the bridge, s/l . Where V is the average upstream velocity, s is the total bridge thickness, g is gravity, h is the inundation ratio and l is the bridge length. The moment, drag and lift coefficients were evaluated using l^2 , s , and l respectfully. Even though several data sets were given, no evaluation of the physical meaning of the dependencies was presented in this study. Tainsh (1965) and Denson (1982) assumed the parameters were independent of the Reynolds number.

Naudashcer and Medlarz (1983) used a dynamometer to measure the drag acting on bridge girders. They analyzed effects of the elevation of the bridge, angle between the flow and the bridge, and the number and length of the girders. They observed that the flow through bridge girders generates an unsteady vortex formation that gives rise to a variation in the dynamic force acting on the bridge. A relationship between the drag coefficient, C_D , and the governing parameters was also presented.

Matsuda et al. (2001) determined that the value of the drag, lift, and moment coefficients was independent of the scale of the model. Three different bridge deck scale models were analyzed in a wind tunnel at different angles of attack in the low Reynolds number range of $1.1 \times 10^4 < R < 1.5 \times 10^6$. When comparing different angles of attack, there was variation in the coefficients; however, at the same angle of attack there was no variation in C_D , C_L and C_M between the different models.

Okajima et al. (1997) analyzed the effect of the blockage ratio on the drag coefficient for a rectangular bridge deck. The blockage ratio is defined as the ratio between the upstream area of the bridge deck that is inundated by the free surface stream and the total area of the free surface stream measured at a reference section located upstream of the bridge. They concluded that there is a linear relationship between the blockage ratio and the drag coefficient.

Tainsh (1965) and Denson (1982) investigated the effects of free surface flow on specific bridge deck structures. Whereas Malavasi and Guadagnini (2003) modeled the bridge deck as a rectangular cylinder in their study. Evidence was provided on the nature of the dependence of the time-averaged force

coefficients (lift, drag, and moment coefficients) on a normalized cylinder submersion, $h^* = (h - h_b) / s$ and the Froude number. Where h is the water depth upstream of the bridge deck h^* is the inundation ratio and h_b is the elevation of the low chord of the bridge girder relative to the channel floor. They deduced that the values of the mean force coefficients were much different when in free surface flow versus an unbounded domain. The presence of a free surface changed the coefficients by a factor of 2 or even lower than the values of an unbounded domain. They found that the worst situation for bridge stability occurs when the bridge's inundation ratio is slightly greater than 1.0, which is a common and realistic situation. The authors established drag coefficient values up to 3.4 and lift coefficient values up to -10.

Kerenyi et al. (2009) developed experimental tests and Computational Fluid Dynamics (CFD) models to develop force coefficients for different bridge deck geometries that can be used in design. The project was funded by the U.S. Department of Transportation and was conducted at the Federal Highway Administration (FHWA) labs in McLean, VA. They tested three different bridge types, which included a six-girder, three-girder and prototype streamlined deck shapes designed to reduce the force associated with inundation. The equations developed for the lift, drag and moment forces were used in the assessment of the bridges along US 34 in this thesis. Below are the design equations and the nomenclature used herein.

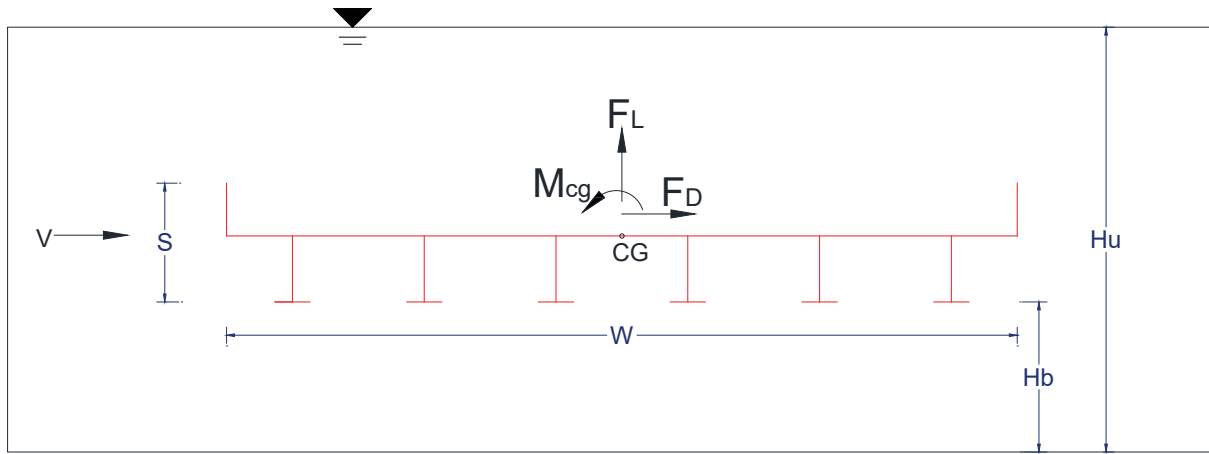


Figure 1.4 Scaled six-girder bridge deck used in the development of the force coefficients with the dimensions and forces labeled (Kerenyi et al. 2009)

$$\frac{F_L}{L} = 0.5 C_L \rho W V^2 \quad (1.1.1)$$

$$\frac{F_D}{L} = 0.5 C_D \rho s V^2 \quad (1.1.2)$$

$$\frac{M_{cg}}{L} = 0.5 C_M \rho W^2 V^2 \quad (1.1.3)$$

The forces are expressed as a force per length in the units of lb/ft and lb-ft/ft. Values of the coefficients are driven by the inundation ratio and the Froude number (F_r). For the experimental setup, all three models were tested in the same flume to minimize the experimental error. They were tested under four approach velocities ranging from 0.82 to 1.64 ft/s (0.25 to 0.5 m/s) and a constant flow depth, h_u , of 0.82 ft or 0.25 m. Under these settings, the F_r varied from 0.16 to 0.32. The bridge deck model was mounted on a bracket, which was then attached to a platform via four ball-bearing pendulums. The pendulums

movement was resisted by two pairs of flat springs in each direction. The tension in the springs was measured by strain gauges, which gave the forces associated with the drag and lift forces. Unevenly distributed forces on the bridge decks lead to moments about the center of gravity about the bridge deck. The values of the drag, lift and moment coefficient obtained by Kerenyi et al. (2009) are presented in the Figures 1.1, 1.3 and 1.4, respectively. For this research, the fitting equation that corresponded to a higher Froude number was used in developing the bridge forces. This is due to the bridges' hydraulic models Froude number output being greater than 0.32, which is the highest Froude number tested in the study.

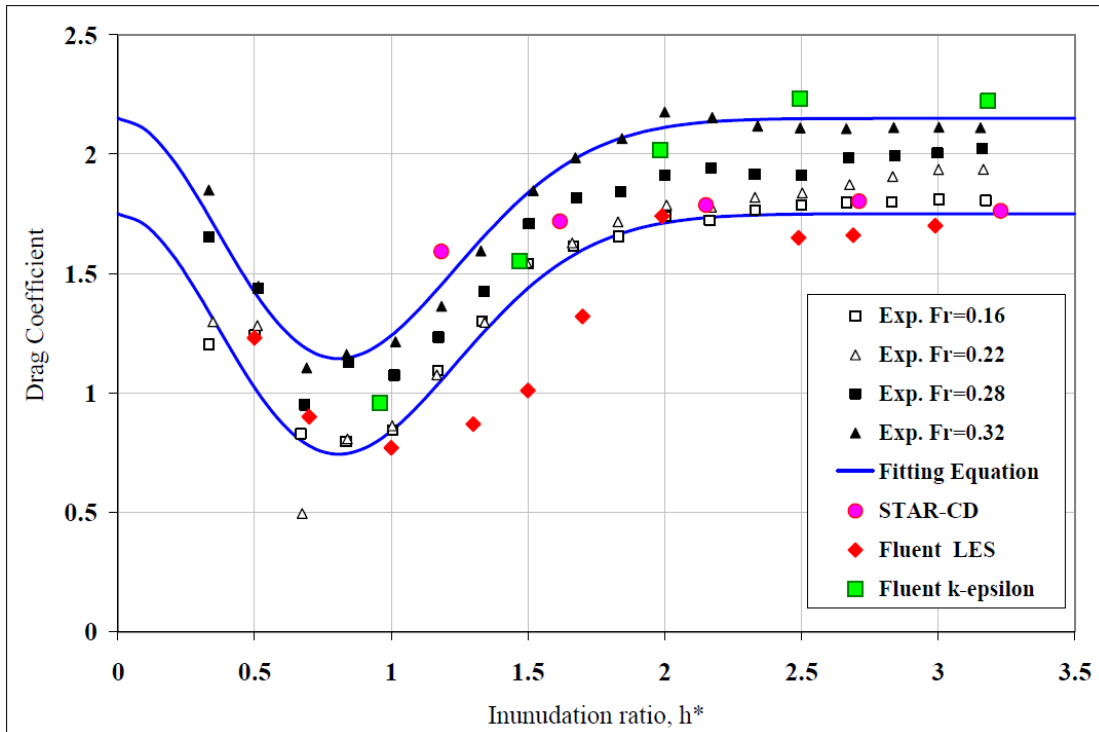


Figure 1.5 Drag coefficient vs. inundation ratio for the six-girder bridge (Kerenyi et al. 2009)

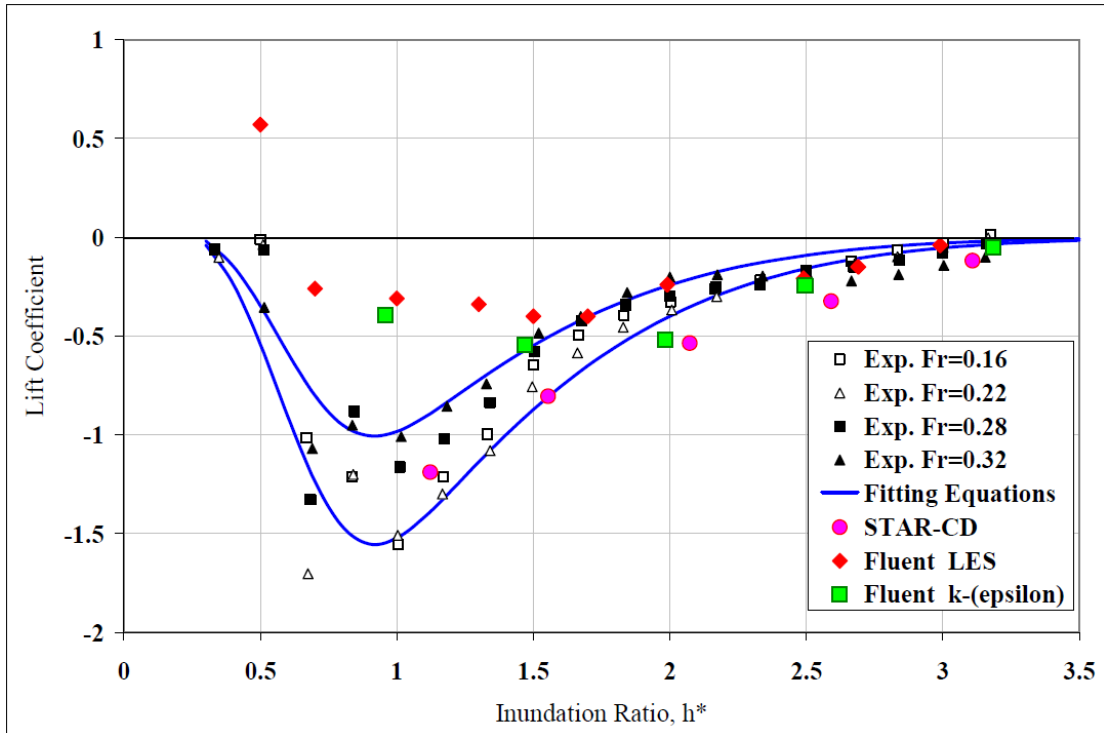


Figure 1.6 Lift coefficient vs. inundation ratio for the six-girder bridge (Kerenyi et al. 2009)

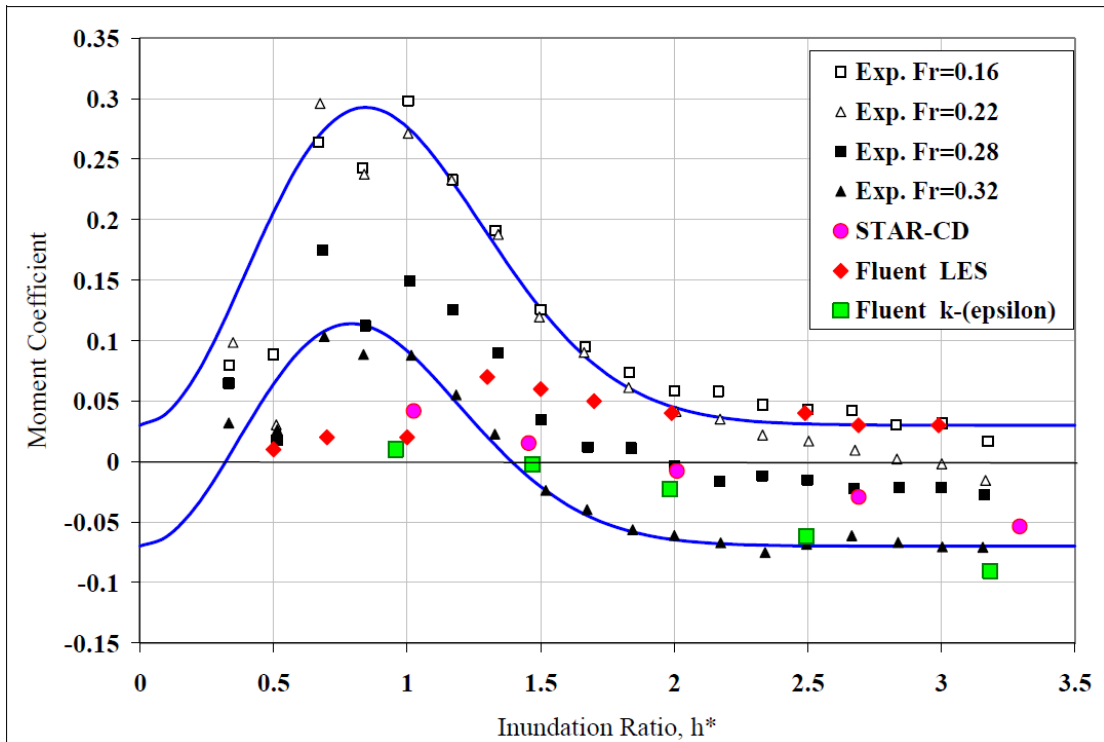


Figure 1.7 Moment coefficient vs. inundation ratio for the six-girder bridge (Kerenyi et al. 2009)

In the calculation of the integrated vertical force, F_L , its component associated with buoyancy force is excluded. The general equation for buoyancy force can be written as follows

$$F_B = Vol_{dis} \rho g \quad (1.1.4)$$

where Vol_{dis} is the volume of water displaced by the bridge, ρ is the density of water with a value of 1.92 slugs/ft³ and g is gravity with a value of 32.2 ft/s². Force balances were calibrated for zero lift under no-flow conditions. The hydrostatic buoyancy force F_{BH} is used to determine the appropriate displaced volume calculation for the correct buoyancy force acting on the bridge (Jenson, 2000). F_{BH} is calculated using a level free surface and is the force on the bridge in the hydrostatic state. Three methods were proposed by Jenson (2000) to calculate the displaced volume. The method adopted in this research involves using the water level at the upstream face, i.e. h^* , to calculate Vol_{dis} (Jenson 2000). When calculating the design lift force, first the value from equation 1.1.1 would be obtained for a specific h^* value, then the corresponding buoyancy force would be calculated via equation 1.1.4 and the values would be summed. Inundation ratio is readily available in the force calculations due to the analysis method used in this research. The main error in the Vol_{dis} value would come from flows at high Froude numbers when the water level at the upstream face is fluctuating.

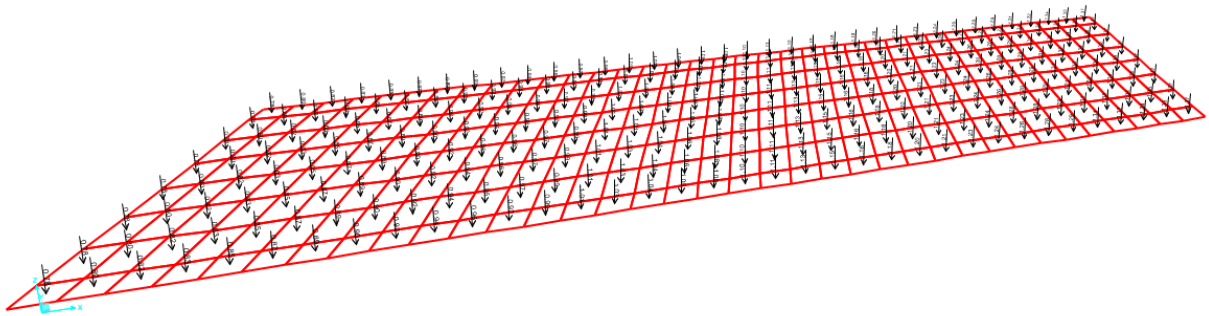


Figure 1.8 An example of the applied net lift force on the bridge superstructures

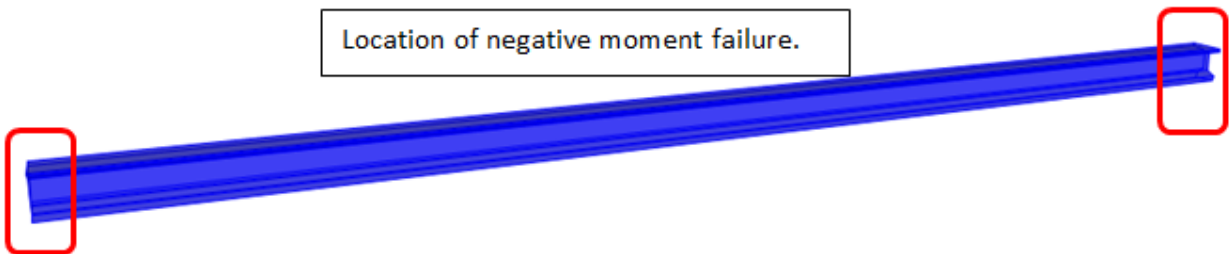


Figure 1.9 Failure locations for the girders in this study

Development of probability-based design began with the American National Standards Institute (ANSI) Standard A58 (Ellingwood et al. 1980). This was the first use of reliability theory to determine load and resistance factors for design of civil engineering structures and was widely accepted. However, Load and Resistance Factor Design (LRFD) wasn't introduced into bridge construction until the 1994 when The American Association of State Highway Transportation Officials (AASHTO) published the first edition of AASHTO LRFD Bridge Design Specification (AASHTO 1994). In LRFD, the safety performance requirement is expressed by the following equation (AASHTO LRFD-BDS 1994) where:

$$\phi R_n > \sum \gamma_i Q_i \quad (1.1.5)$$

R_n = nominal capacity of a member, connection, or a component; ϕ = resistance factor that takes into account the uncertainties in the material strength; Q_i = load effect such as moment, shear, or axial load; γ_i = load factor that takes into account the uncertainties in the load.

Reliability analysis starts with the formulation of a limit state function, $g(x)$, such that failure corresponds to $g(x) < 0$, where x =vector of basic variables (e.g. material properties, geometric properties, etc.). The form of the limit state function is often expressed as

$$g(x) = R - S \tag{1.1.6}$$

where R = structural resistance and S = load effect. Both can either be a random variable or a function of multiple random variables. The failure probability, p_f , can be calculated using any one of several numerical techniques (e.g. MCS, FORM, etc.). Lastly, the reliability index, β , can be determined by

$$\beta = \Phi^{-1} (1 - p_f) \tag{1.1.7}$$

where Φ^{-1} = the inverse of the standard normal distribution function. A target reliability index is selected in this study such that all structures have a uniform reliability index. For example, the target reliability for girder bridges in the AASHTO LRFD Bridge Design Specification is 3.5 (Nowak 1995). This research applies the same target reliability value of 3.5 when assessing the p_f of inundated bridge decks, which ensures that only two out of 10,000 design components will have the sum of the factored loads greater than the factored resistance during the design life of the bridge. An example of beta values and their corresponding p_f can be seen below in Table 1.2.

Table 1.2 Reliability index and probability of failure values

Reliability index	Probability of failure
0	0.5
1	0.159
2	0.0228
3	0.00135
4	0.00003167
5	0.0000002867

2. FRAGILITY MODELING

2.1 Fragility Analysis

Fragility modeling provides a structured outline for evaluating performance, including uncertainty, and reliability of a structural system subjected to a loading condition. The first step is to identify the conditions or limit states in which the structural system fails a certain performance objective, which can be either strength- or deformation-related (and a number of other states not discussed herein). The probability of a limit state or a function subjected to loading can be expressed as

$$P(LS) = \sum P(LS|D = x) P(D = x) \quad (2.1.1)$$

where D is a random demand on the system, e.g., inundation ratio, wind speed, or spectral acceleration, and $P(LS|D = x)$ is the conditional probability of demand equaling the limit state. The hazard is defined by the probability $P(D = x)$ and the fragility is defined as the conditional probability $P(LS|D = x)$. If the hazard is expressed as a continuous function of x , then the summation in Eq. (2.1.1) is replaced by the convolution integral of structural reliability theory (Rosowsky and Ellingwood, 2002).

Eq. (2.1.1) underscores the need to have structural fragilities for a fully coupled analysis. Rosowsky and Ellingwood (2002) state that the fragility provides a less informative measure of safety than a fully coupled risk analysis; however, there are numerous benefits from solely a fragility analysis. A fragility analysis is less complex than a fully coupled risk analysis and the hazard probability is not required. In addition, it is independent of location since only the structure and loading intensity are used in its development.

The fragility of a structural component or system is often modeled by a lognormal cumulative distribution function, CDF,

$$FR(x) = \Phi \left[\ln \left(\frac{x}{\lambda_R} \right) / \xi_R \right] \quad (2.1.2)$$

in which λ_R is the logarithmic mean of capacity, R , and ξ_R is the logarithmic standard deviation (Rosowsky and Ellingwood 2002).

When performing a risk analysis, hazard curves can be obtained from a number of sources or from a statistical analysis. For example, flood discharge values can be obtained from the insurance agency in the area of interest, or data regarding wind can be obtained from the National Weather Service (NWS). Figure 2.1 displays a set of fragilities based on a certain demand. In this study, the demand would be a range of inundation ratios from 0 to 1 with tick marks every 0.1 increment.

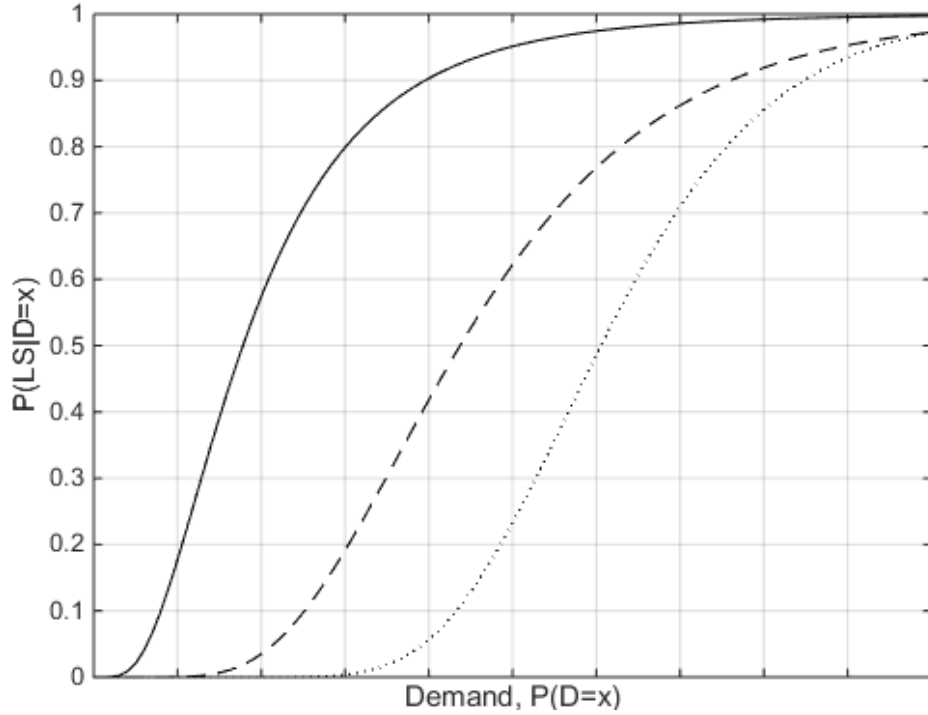


Figure 2.1 Example fragilities for illustration

2.2 Limit States

For this research, only the bridge superstructure was considered (i.e. the girders and bridge deck). The three flood-induced forces were applied to the SAP2000 bridge models to determine what mode of failure would govern. It was determined that the drag and moment forces were negligible and the lift force governed. Under this condition, the negative moment capacity of the girders was used for the strength limit state and the deflection was used for serviceability. The basic limit state function Eq. 1.1.6 is used for both cases. For negative moment, the resistance is replaced by the nominal moment capacity, M_n , of the girder and the load effect is replaced by the maximum negative moment from the SAP model. The equation used for the negative moment capacity for prestressed concrete girders was taken from AASHTO LRFD Bridge Design Specification 4th edition Eq. (5.7.3.2.2-1).

$$M_n = A_s f_s \left(d_s - \frac{a}{2} \right) + 0.85 f'_c (b - b_w) h_f \left(\frac{a}{2} - \frac{h_f}{2} \right) + A_{ps} f_{ps} \left(d_p - \frac{a}{2} \right) - A'_s f'_s \left(d'_s - \frac{a}{2} \right) \quad (2.2.1)$$

Where A_{ps} =area of prestressing steel, f_{ps} =average stress in prestressing steel, d_p =distance from extreme compression fiber to the centroid of prestressing tendons, A_s =area of mild tension steel, A'_s =area of mild compression steel, b =width of compression face member, b_w =width of web, a =depth of equivalent rectangular stress block, and h_f =compression flange depth. The presented equation in AASHTO was for positive moment capacity and was adjusted for negative moment.

The serviceability limit state was set as a displacement equal to the span length/100. Ghosn and Moses (1998) defined several limit states in the formulation of a methodology for bridge redundancy factors. Among them, a functionality limit state was set as span length/100. This is defined as the maximum perceptible displacement the public will accept. It is proposed on the basis of engineering judgement and is consistent with displacement levels used by engineers and researchers. The demand in Eq. 1.1.6 was set equal to a constant value of span length/100 and the load effect is equal to the respective displacement values pulled from the SAP model under varying lift forces.

2.3 Resistance Statistics

Moment capacity of prestressed girders and steel W sections are influenced by several variables. The steel component areas and yield strength were the most influential, i.e., the mild and prestressing steel. Compressive strength of the concrete was also an important factor. Table 2.1 shows the parameters used in the Monte Carlo simulation for generating a Weibull distribution of the nominal moment capacity, i.e., the resistance in the equation 1.6. In Monte Carlo simulation, a system is simulated a large number of times (e.g., 10,000) where each simulation is equally likely to occur, which is often denoted as a realization of the system. Several random numbers are generated between 0 and 1 which then pull values from the uncertain variables CDF function. This results in a large number of separate and independent values, each representing a probable outcome for the system. The final results are fitted to probability density function, PDF, which represents all the possible values the system can take. In this research, the system is equal to Eq. (2.2.1) and the resulting PDF is the nominal moment capacity of the girder. An example of a PDF generated via Monte Carlo simulation can be seen in Figure 2.2. The variables were either a normal or a lognormal distribution, which requires the input of two parameters: the mean and standard deviation. The mean used in the simulation was equal to the nominal area calculated via the construction drawings multiplied by a factor. For the standard deviation, the calculated mean would be multiplied by the coefficient of variation.

Table 2.1 Statistical information for the variables used in the monte carlo simulation

Variable	Distribution	Mean	Coefficient of variation	Reference
A_s	Normal	$0.9A_s$	0.015	Siriakson and Naaman (1980)
f_y	Lognormal	$1.13f_{yn}$	0.03	Nowak et al. (2008)
f_c	Lognormal	$1.2f_{cn}$	0.525625	Biondini et al. (2006)
A_{ps}	Normal	A_{ps}	0.0125	Naaman and Siriakson (1982)
f_{ps}	Normal	f_{ps}	0.025	Mirza et al. (1980)

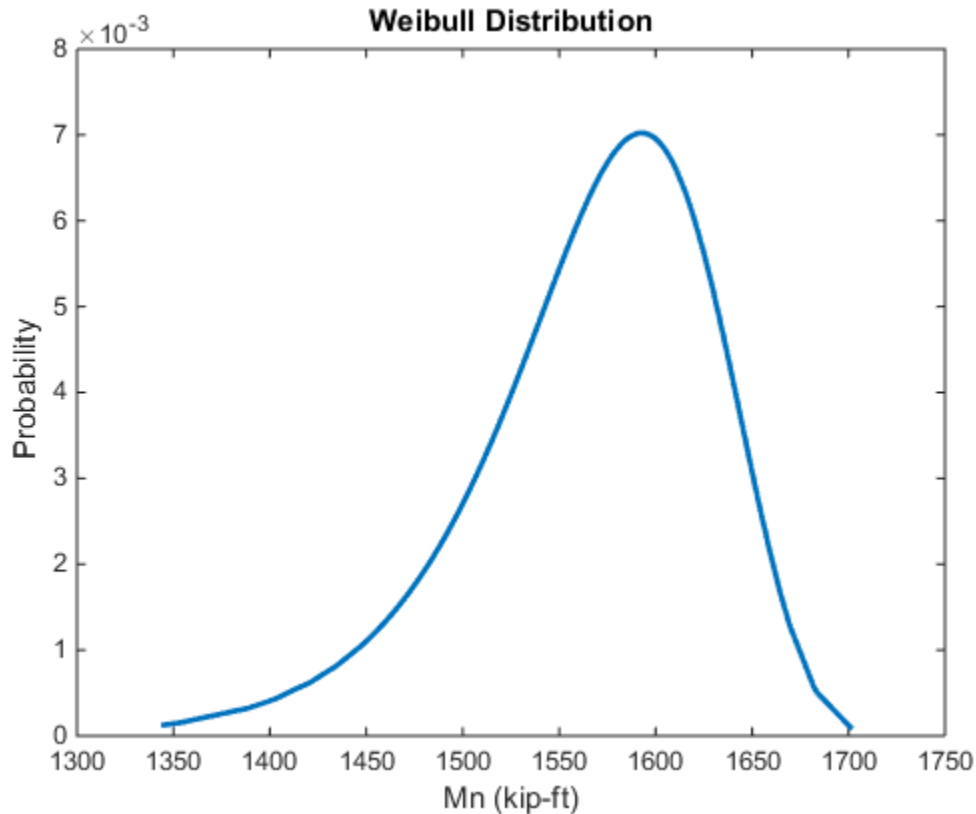


Figure 2.2 Nominal moment capacity for an external girder for bridge C-15-Y

2.4 Hydraulic Modeling

The U.S. Army Corps of Engineers River Analysis System (HEC-RAS) developed by the Hydrologic Engineering Center was used to generate a discharge-water height rating curves for the eight bridges along US 34. HEC-RAS is designed to perform one-dimensional hydraulic calculations for a full network of constructed and natural channels (Brunner (a), 2010). The steady flow water surface profile component was used to create the rating curves. The steady flow module is capable of modeling subcritical, supercritical, and mixed flow water regimes. For the computational procedure, the solution to the one-dimensional energy equation is used. Energy losses are calculated by friction (Manning’s equation) and the contraction/expansion coefficient multiplied by the change in velocity head (Brunner (a), 2010). Losses through a bridge are calculated based on the standard step method, i.e. the energy equation.

When developing a bridge rating curve, there are four unique cross sections needed to compute the energy losses due to the structure. Figure 2.3 displays a plan view of said cross sections. Cross section 1 is located a distance downstream from the structure where the flow has fully expanded. The HEC-RAS User’s Manual provides a table which provides an estimate of the expansion reach length based upon the degree of constriction, level of the flow, shape of the constriction, and the velocity of the flow. In the case of this research, changing the downstream parameters such as the location of cross section one and the expansion ratio had little to no effect on the rating curve at cross section four. Cross section 4 is located upstream where the flow lines are roughly parallel and the full cross section is effective and is also known as the approach section (Brunner (b), 2010). In general, flow contractions occur over shorter distances than flow expansions. There are regression equations and contraction ratio limits, which require an iterative process to correctly model the location of cross section 4. Due to backwater effects, the bridge discharge-water height rating curve should be generated at cross section 4. Cross section 2 should be

placed such that it represents the natural channel and floodplain of the modeled reach. The cross section is on the order of 10–30 feet downstream of the bridge opening for this research. It is placed enough distance downstream to allow for some flow expansion due to piers, or pressurized flow, coming out of the bridge (Brunner (b), 2010). Cross section 3 is similar to cross section two, except on the upstream face of the bridge. It is placed at the toe of the upstream embankment allowing for abrupt acceleration and contraction of the flow (Brunner (b), 2010).

Both cross sections 2 and 3 should include ineffective flow areas such that lengths AB and CD in Figure 2.3 are not included in the active flow area. The ineffective flow area option is used to keep the active flow in the area of the bridge opening until the elevations associated with the ineffective flow areas are exceeded by the computed water elevation (Brunner (b), 2010). The station locations should be placed to allow for the expansion and contraction of the flow that occurs at the bridge. A rule of thumb is to assume a 1:1 contraction and expansion rate in the immediate vicinity of the bridge (Brunner (b), 2010). For example, if cross section 2 is 15 feet downstream from the bridge face, the ineffective flow areas should be placed 15 feet wider than the location of B and C on Figure 2.3. The same is true for cross section 3. The elevation used for the ineffective flow area at cross section 3 should be equal to the top of the road or curb (Brunner (b), 2010). For the downstream side, the elevation used should be equal to the average elevation between the low chord and the top of the road or curb (Brunner (b), 2010). Using the ineffective area option allows the overbank areas to become effective once the ineffective area elevations are overtopped. Figure 2.4 shows an example of the geometric data view in HEC-RAS with the four cross sections specified in Figure 2.5. It is important to note that bridge wing walls were not included in the HEC-RAS models. Bob Jarrett, an expert in paleoflood and flood hydrology, stated that this modeling assumption was reasonable because debris and erosion around bridges can introduce errors and uncertainty. The modeling results also confirmed this by being similar in magnitude to the published rating curve on the construction drawings.

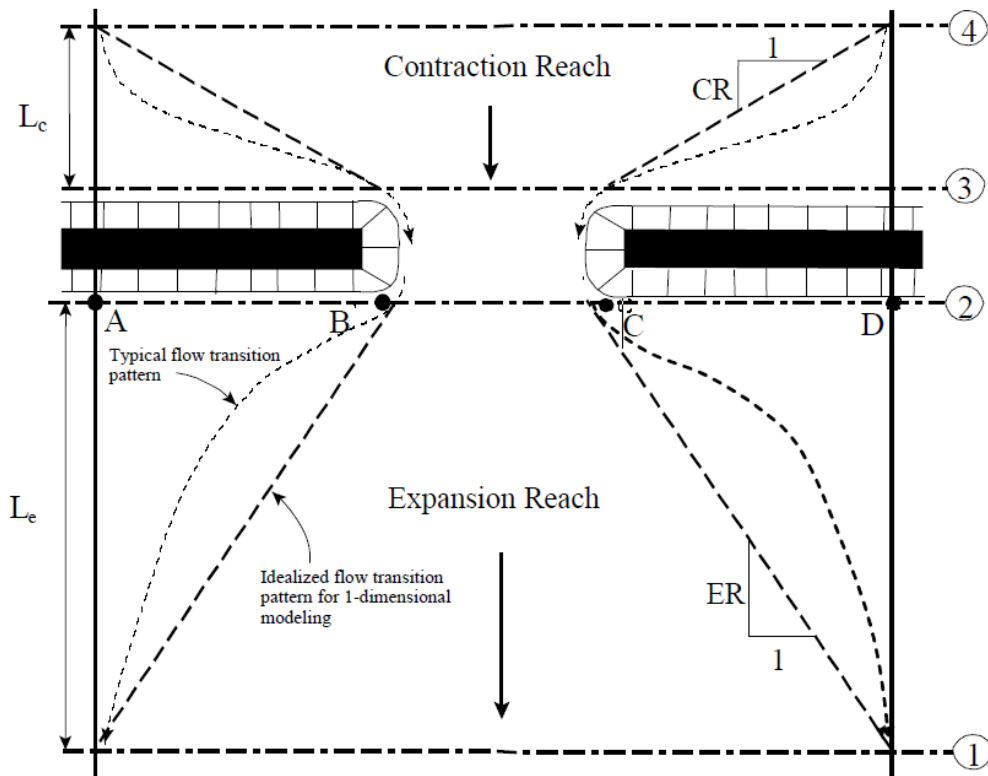


Figure 2.3 Cross section locations at a bridge (excerpted from Brunner, 2010)

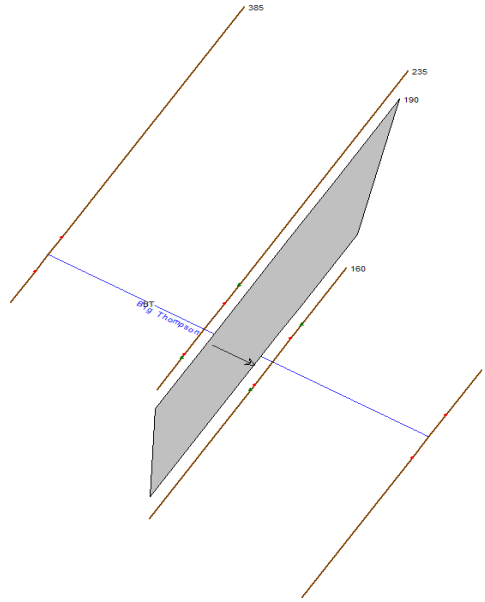


Figure 2.4 Geometric data plan view of HEC-RAS model for bridge C-15-AM

When developing the rating curves for the eight bridges along US 34, six of them had rating curves available from the construction drawings. In most cases, the plan curves didn't include an overtopping discharge value that was needed in determining the flow rates associated with an inundation ratio between 0 and 1. The plan curves simply gave a good measure of the accuracy of the generated rating curves via HEC-RAS. Some difference is expected due to the September 2013 flood altering the channel and the large sediment transportation. Nonetheless, the generated curves were similar in magnitude to the plan's curves which validated the models.

For generating the cross sectional elevations, post-flood LiDAR data was used. LiDAR, which stands for Light Detection and Ranging, is a remote sensing method that uses light in the form of a pulsed laser to measure variable distances to the Earth. A pulse of near-infrared laser light is fired at the ground via an aircraft-borne laser (Bradbury et al. 2005). The laser pulse spreads as it descends forming a circular footprint at the ground level. The reflection and the timing of the return pulse is used to derive a measure of the elevation. These measurements are combined with data on the position and altitude of the aircraft by a global positioning system (GPS) and an inertial navigation unit, which measures the roll, pitch, and yaw enabling the position and elevation of each point to be identified (Bradbury et al. 2005). When scanning an area with high levels of vegetation, the ground elevation values are usually interpolated through the known ground points. LiDAR radiation doesn't transmit through a structure such as a leaf, but it will transmit through holes in the structure (Bradbury et al. 2005). The footprint size of each pulse is usually on the order of < 1 meter with a pulse rate of a 100 kHz (Bradbury et al. 2005). This high sampling rate allows sampling densities of up to 10–20 footprints per square meter (Bradbury et al. 2005). For this research, there were only two bridge locations with copious vegetation. To counter this, field observations were supplemented with the LiDAR data to generate the HEC-RAS cross sections.

Figure 2.5 displays an example of the procedure followed to generate the cross sections necessary to input into HEC-RAS. The locations needed for cross sections 1 and 4 required an iterative process to make sure the expansion and contraction reach lengths were correct as specified in the HEC-RAS User's Manual. Figure 2.6 displays the raw data elevation graph that can be exported into excel for conversion into feet and elevation adjustments if warranted by the field investigation.

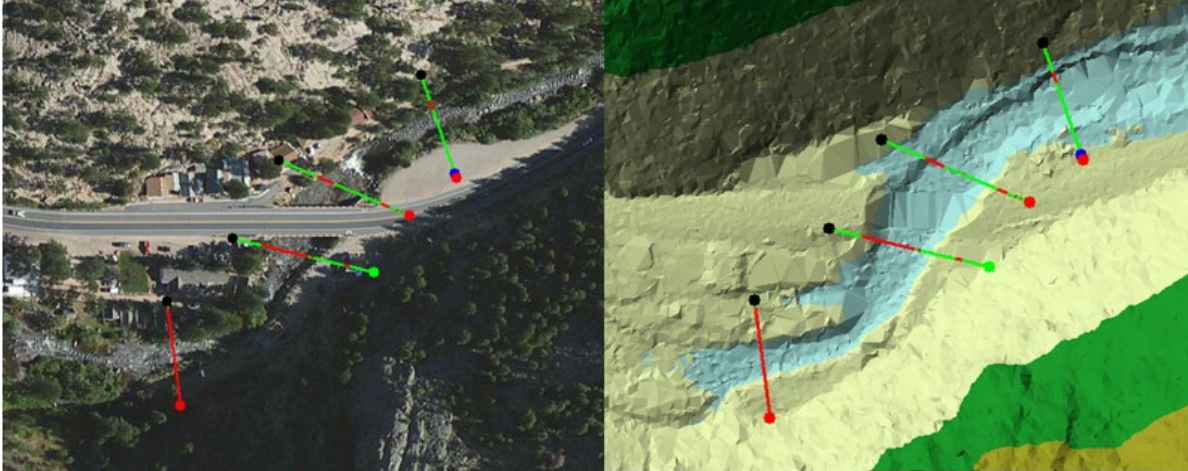


Figure 2.5 An example of the cross sections pulled from ArcMap with LiDAR data obtained from Colorado GeoData at bridge C-15-AM

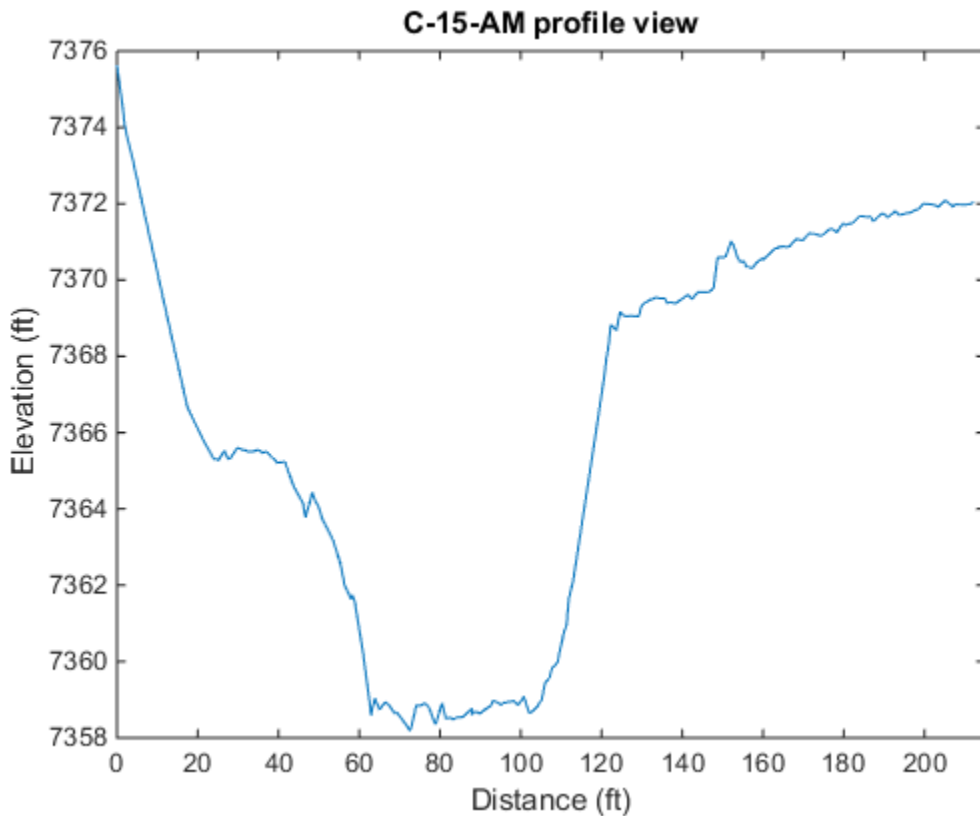


Figure 2.6 The profile graph of the elevation data pulled from cross section 1 (the furthest right line on Figure 2.5)

Field measurements were needed to supplement the LiDAR data. Steven Griffin from CDOT supplied the construction plans and hydraulic information for the eight US 34 bridges. His consulting defined the criteria for the field measurements. The criteria for elevation adjustments were as follows: if there was significant aggradation in the streambed, CDOT would excavate the channel to adhere to the elevations listed in the construction drawings; if there was degradation greater than 1–2 feet, CDOT would fill the streambed to the construction drawings elevation to meet bridge scour concerns. The data was collected by measuring

the height difference between the low chord of the bridge and the channel bottom every four feet on the upstream and downstream side. These measurements were compared to data on the construction drawings to determine if any aggradation/degradation had occurred. Comparing the numbers to the construction drawings converted the field measurements into elevation data, which could be directly compared to the LiDAR data shown in Figure 2.5. If any adjustments were warranted to the channel bottom, then the LiDAR data would be altered accordingly. It was assumed that the channel would have similar aggradation/degradation along the strip from cross section 1 to 4. For example, if two feet of aggradation was measured, then all four cross sections would uniformly be adjusted by -2 feet.

2.5 Flood Frequency Analysis

The flood frequency analysis was necessary in determining the hazard associated with the developed rating curves' discharge values. In August 2014, CDOT and the Colorado Water Conservation Board (CWCB) funded a report titled "*Hydrologic Evaluation of the Big Thompson Watershed*," which was compiled by Jacobs Engineering Group, Muller Engineering Company, Parsons Brinckerhoff, and Ayres Associates. The most recent flood frequency analysis prior to this report was published in 1981. These flow rates were put into question after the devastating September 2013 flood.

The final predictive model that gave the discharge estimates for the Big Thompson River, North Fork Big Thompson River, and Buckhorn Creek involved several steps. Peak discharge estimates for the September flood were made, an updated flood frequency analysis was performed, a rainfall/runoff model was developed for the September 2013 event, and the National Oceanic and Atmospheric Administration (NOAA) rainfall for a number of return periods was used to develop the final values (Jacobs, 2014).

Estimates of peak discharges based on field observations were undertaken by Bob Jarrett of Applied Weather Associates (AWA). Over a long career with USGS, Bob has developed techniques for making peak discharge estimates based on paleoflood evidence and high water mark observations. The discharge estimates provided by Bob Jarrett and other available estimates were compared to current regulatory discharges gage the severity of the September flood (Jacobs, 2014). This information is documented in a memo titled *CDOT/CWCB Hydrology Investigation Phase One-2013 Flood Peak Flow Determinations*, dated January 21, 2014 (Jacobs, 2014).

Flood frequency analyses (FFA) were conducted to supplement the hydrologic evaluation of the Big Thompson River (Jacobs, 2014). The analyses followed methods described in the document "*Guidelines for Determining Flood Flow Frequency*" published by the USGS on September 1981 (Jacobs, 2014). This document is referred to as *Bulletin 17B*. FFA by Bulletin 17B involves inputting the highest peak flow discharge at gage stations for every year and a regional skew coefficient. CDOT and CWCB analyzed 24 gage stations along the northern front range with gage records ranging from 9 to 89 years (Jacobs, 2014). These records were then analyzed using a log-Pearson Type III distribution as recommended in Bulletin 17B. Values for the 2, 5, 10, 50, 100, and 500-year floods were then produced at a location for each reach. Based on the results, the 2013 flood was slightly larger than a 100-year event at the mouth of the Big Thompson Canyon and on the North Fork Big Thompson at Drake (Jacobs, 2014).

A hydrologic analysis was performed on the Big Thompson watershed to evaluate and try to replicate the September flood event. The September 2013 flood event was modeled using the U.S. Army Corps of Engineers Hydrologic Engineering Center's Hydrologic Modeling System (HEC-HMS) to calculate the peak runoff experienced during the flood within the three reaches (Jacobs, 2014). Topographic data used was 10 meter Digital Elevation Data (DEM) shaded relief and Digital Raster Graphic (DRG) dataset, which is essentially LiDAR data (Jacobs, 2014). The topographic data imported via HEC-GeoHMS is used to develop watershed boundaries and flow paths (Jacobs, 2014). In total, the watershed is approximately 460 square miles. The first step in the model calibration process was to calibrate the

rainfall data from 2013 to ground measurements (Jacobs, 2014). The second step involved calibrating the model to the estimated 2013 peak discharges with the help of information on the stage storage-discharge relationship for Lake Estes (Jacobs, 2014).

Once the rainfall-runoff model was calibrated to represent the September 2013 flood, the model was used to predict peak discharges based on NOAA rainfall (Jacobs, 2014). The NOAA Atlas 14, Volume 8 was used to determine point precipitation frequency estimates for the basin (Jacobs, 2014). Isopluvials, or lines of equal precipitation, for 24-hour precipitation depths from NOAA were used to divide The Big Thompson watershed into four rainage zones to account for the variability of precipitation (Jacobs, 2014). The rainage depths were then applied to the standard 24-hour SCS Type II rainfall distribution and incorporated into the HEC-HMS model to evaluate peak discharges for the predictive storms (Jacobs, 2014). The revised predictive model results were compared to the FFA at the mouth of the canyon and the expected unit discharges to check accuracy (Jacobs, 2014). Figure 2.5 shows the final output from the predictive model. The dashed lines represent the previous 1981 regulatory discharge values and the solid lines represent the updated values. The 100 and 500-year values are significantly larger in most locations along the stream, most noticeably at the confluence with North Fork Big Thompson, which is at bridge C-15-Y.

The eight bridges of interest start from slightly downstream of Lake Estes to the mouth of the canyon. The log Pearson type III distribution was used as recommended by Bulletin 17B for the FFA. To fit the three parameters to the distribution, the statistical program R was utilized. From the figure, values would be pulled from the solid lines for the 10, 50, 100, 500-year return intervals at the location of each bridge. Nonlinear least squares was used in R to minimize the square distance between the log Pearson type III survival function and the known four return intervals. Table 2.2 shows the resulting fitted parameters used in the generation of the hazard probabilities. The bridges are listed in location order starting from near Lake Estes (C-15-AM) to just before the mouth of the canyon (C-16-DI).

Table 2.2 Log Pearson type III distribution fitted parameters used for the hazard probabilities

Bridge	C-15-AM	C-15-AL	C-15-O	C-15-U	C-15-Y	C-15-C	C-15-AN	C-16-DI
Iterations	26	26	24	25	30	24	28	31
Shape	5.864	5.855	5.852	5.876	7.457	7.014	7.721	7.766
Location	2.169	2.164	2.158	2.169	2.956	2.272	2.551	2.550
Threshold	2.732	2.726	2.726	2.743	3.595	3.115	3.458	3.456

When running a Monte Carlo simulation, there must be a distribution for the resistance and the load or demand. The resistance statistics discussed in chapter 2.3 explain how variability in the resistance was modled. Variability in the demand was handled a little differently. The published report for the updated FFA gave discharge estimates for different return intervals. However, there is uncertainty associated with the provided discharges due to high and low-outliers, mixed-population sources of flooding, effects of long-term variability on flood estimates, and several other factors (Jacobs, 2014). The rule of thumb is that hydrologic uncertainty associated with estimates is within the range of 15 to 25 percent (Jacobs, 2014). The report estimates that uncertainty can be as high as +/- 20% (Jacobs, 2014). After consulting with Bob Jarrettt, a good way to account for the variability in the demand is to use a normal distribution for the discharge value expected and a standard deviation of 0.20 * the expected discharge. For example, say a discharge value of 10,000 cfs resulted in an $h^*=0.5$. When running the Monte Carlo simulation, 100,000 values between 0 and 1 would be generated and different possible discharge values associated with that 10,000 cfs would be pulled from the PDF function for the discharge. Those discharge values would then be converted into an h^* value and any number less than 0 or greater than 1 would be thrown

out. This results in many possible h^* values arising from the initial 10,000 cfs assumption. There would then be several different h^* values that would be plugged into the Mu graph on Figure 2.5.1, which is a fitted polynomial line to the resulting negative moment values from the SAP2000 model. Next, the numerous Mu values would be fit to a Weibull distribution. Finally, using the resistance and the demand distribution would allow a Monte Carlo simulation to generate several possible values for each and determine how many times the member would fail. The fail counter would be divided by the total number of simulations, which results in a probability of failure value at a specific inundation ratio.

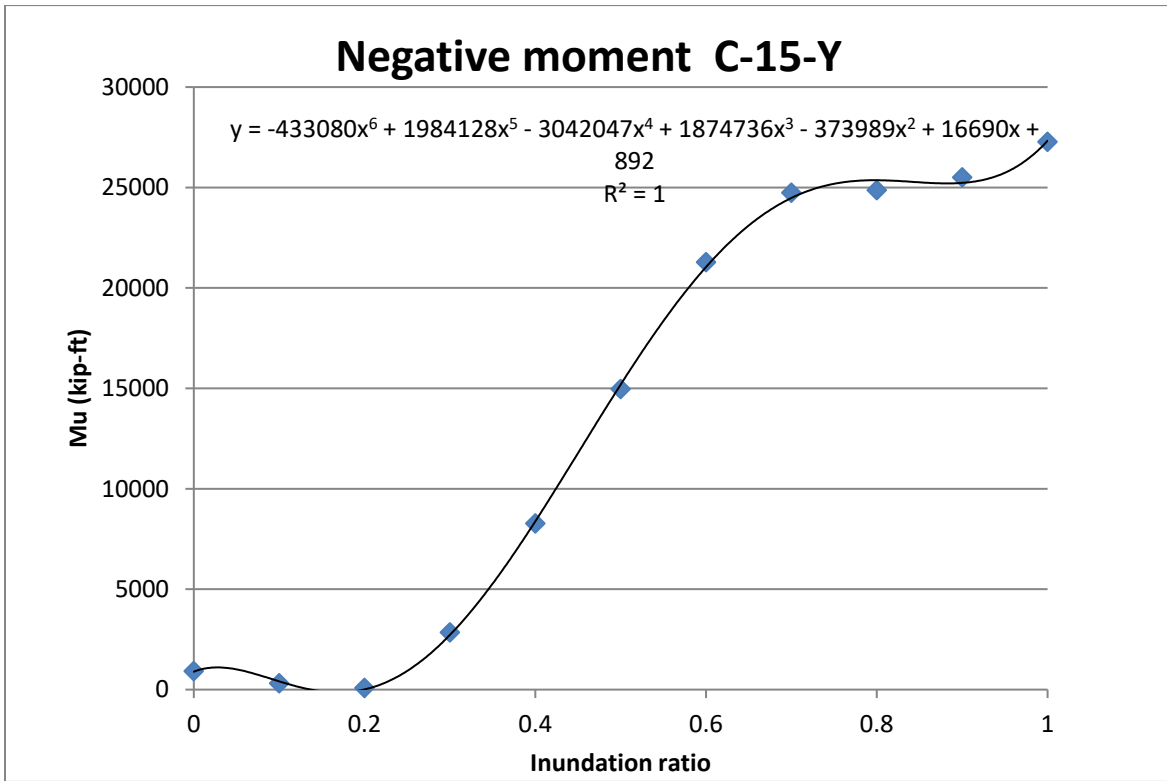


Figure 2.7 Applied negative moment for an external girder on bridge C-15-Y

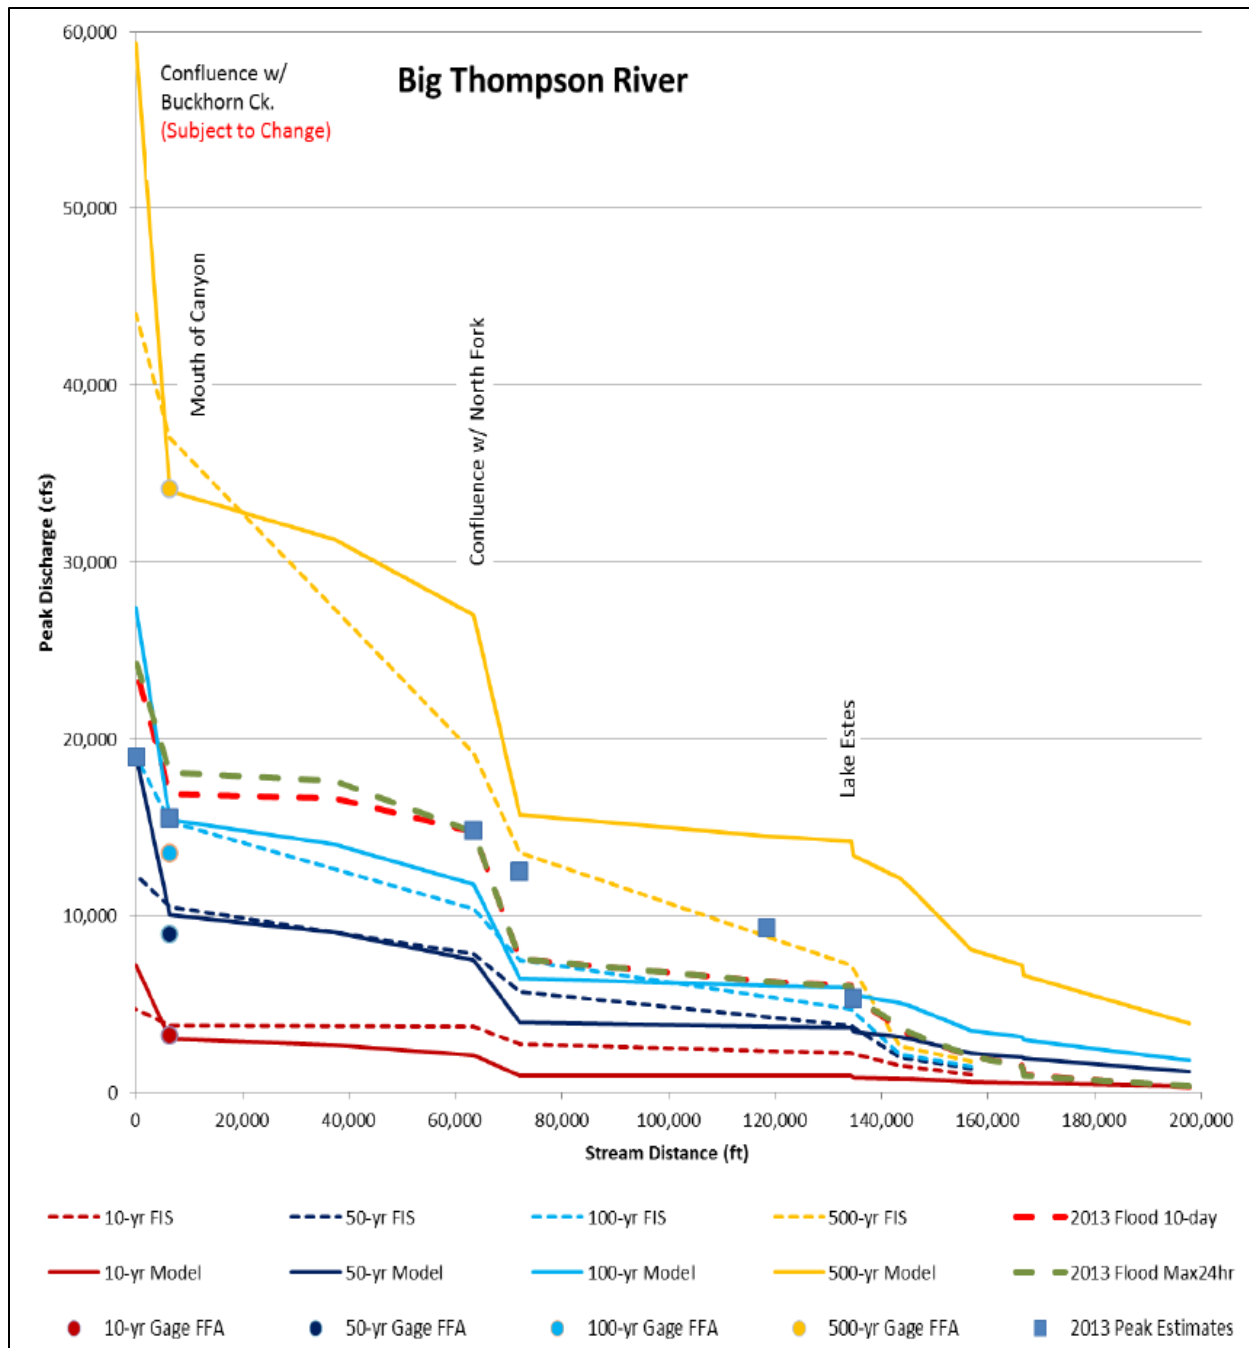


Figure 2.8 Peak discharge profile for the Big Thompson River (Excerpted from Jacobs, 2014)

2.6 Finite Element Modeling

SAP2000 was the finite element program used for modeling of the bridge superstructures. The deck was modeled using quadrilateral shell elements with 6 degrees of freedom (DOF) at each node, and the girders and diaphragms were modeled as frame elements with 6 DOF at each node. To properly model the composite action, the shell and frame elements were each modeled at their respective center of gravity and connected via rigid links. All bridges in this study were integral abutment bridges, which equates to fixed supports at the abutments. The barriers' stiffness was not included in the analysis.

To verify the approach for modeling a composite beam, a test section was modeled as a fixed-fixed condition with a 10' beam and a 6'x10'x0.5' slab. A shell load was applied equating to a distributed load of 22 kips per foot (k/ft). The maximum positive moment was calculated by the equation $\frac{w*L^2}{24}$ where w is the distributed load. Next, the max midspan moment from the beam was subtracted off to determine the moment carried by the slab. This resulted in the slab picking up 354 k-in of the total 1100 k-in. Last, the shell stress was calculated by the flexure stress formula $\sigma = \frac{M*y}{I}$, where y is the distance to the neutral axis, I is the second moment of area about the neutral axis x, and M is the moment about the neutral axis. With the values of y=3.594", I=221 in⁴, and M=354 k-in for the top of the slab, the resulting stress calculated equals 5.76 kips per square inch (ksi). Figure 2.9 displays the SAP2000 results for the slab stresses. The model gave a stress value of 5.96 ksi, which is a 3.4% error, and was thought to be an acceptable result. Therefore, the same procedure for composite beam modeling was followed for the eight bridges in this study.

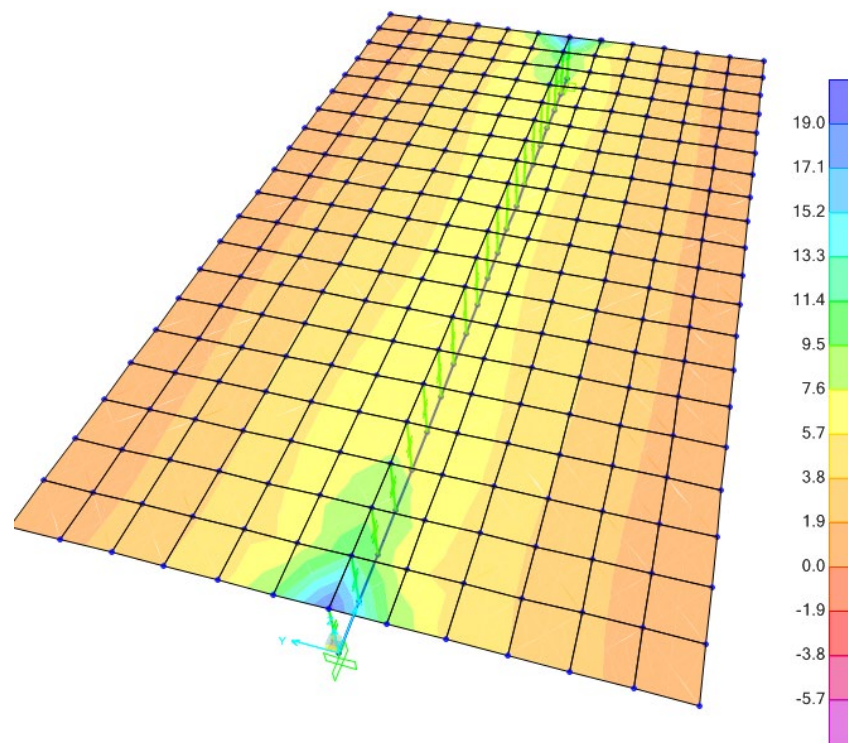


Figure 2.9 Shell stresses for the modeling procedure check

Variation in elevation between the abutments and piers was accounted for as was the bridge skew. For cases where the upstream and downstream elevations were different, the upstream elevation was applied to the downstream side. Some bridges had partial-depth precast concrete deck panels between girders, which varied from 3" to 4". The panels act as a form to support the wet concrete of the cast in place deck. This expedites the construction process due to avoiding any formwork. Installation of the formwork takes the most time for constructing a reinforced concrete deck (Culmo, 2009). Instead of modeling two separate shell elements, the area of the panels were converted into an area for the lower strength cast in place deck using the modular ratio. This resulted in an additional 0.31" of deck thickness in the model, which took into account the added stiffness the panels had on the overall system.

The rigid links acted as shear studs in the model transferring the load and moment from the slab to the girders. Due to this behavior, the placement and number of links were directly related to the shear stud spacing in the construction plans, which resulted in a 3' or 4' spacing in the model. The link location also dictated the location of the shell elements nodal location. The X and Y grid location for the nodes on the girders and the slab had to line up to ensure that the load was transferred without an additional moment from eccentric loading.

Once the grid and the material properties were input for a bridge, the modeling followed these steps: the frame elements were drawn and special joints were added at the locations of rigid links; the diaphragms were drawn with a pin-pin connection; the joint restraints were assigned (fixed for abutments, roller for bearing plates, and pin for bolted connection); the prestressing tendon was added as a tendon element with the force equaling the jacking force after all losses as stated in the construction plans; the shell elements were drawn and divided based on grid marks at link locations; and rigid links were drawn connecting the shell with the frame elements. Next, the meshing of the shell elements was selected such that the shell length/width aspect ratio was less than 5 as per AASHTO-LRFD recommendations. Finally, the loading was applied as a uniform shell load based on the total lift force for each respective inundation ratio.

Figure 2.10 displays the elements utilized in SAP2000. The shell elements will be meshed once the analysis is run. Also, note that the frame, tendon, and shell elements are drawn at their respective elevation. Figure 2.11 is an extruded view of the same bridge as Figure 2.10 post analysis. C-15-Y is a rectangular composite prestressed box girder bridge.

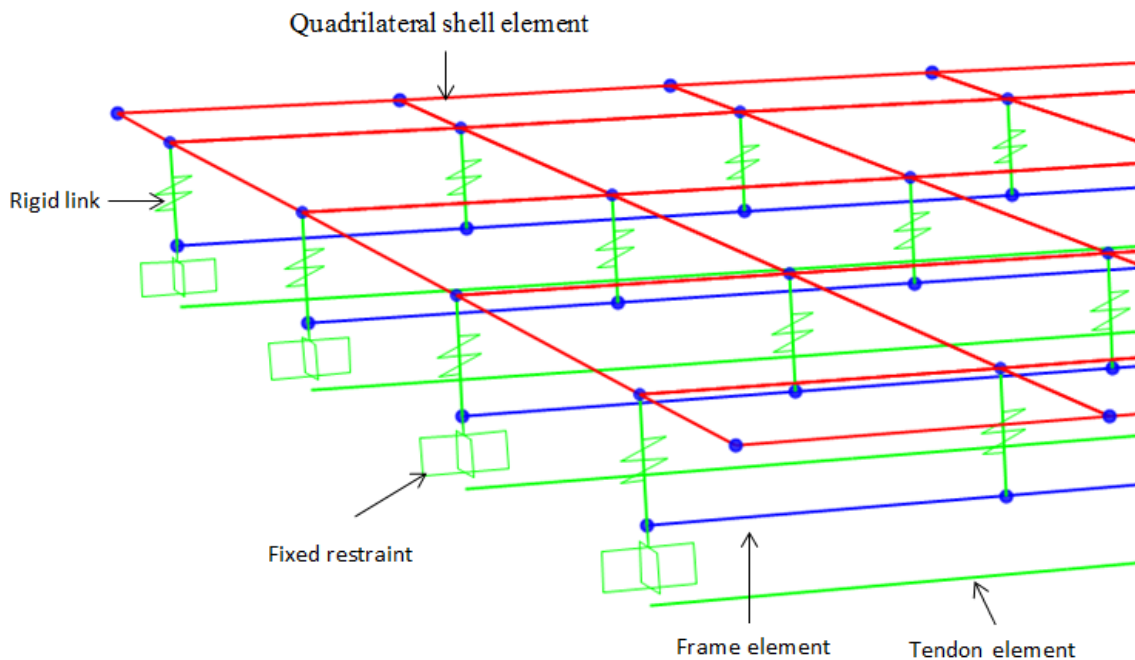


Figure 2.10 Labeled example of SAP2000 elements used

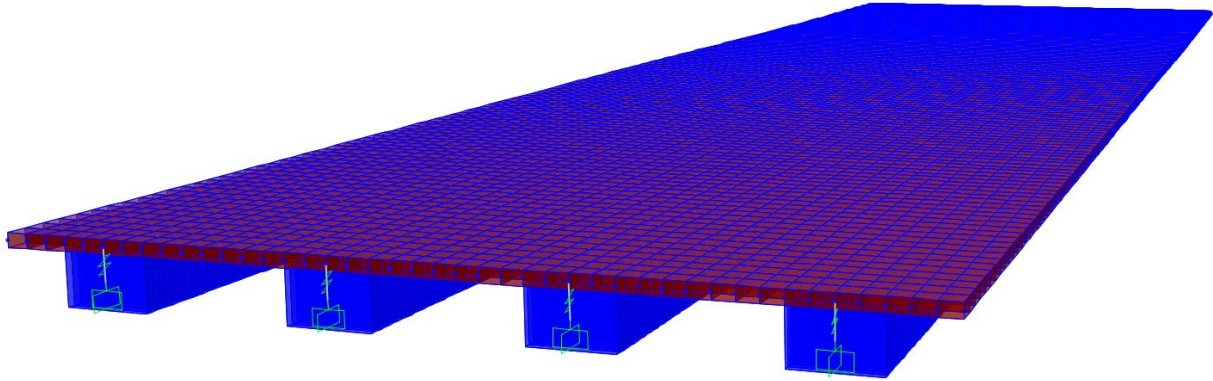


Figure 2.11 Extruded view of bridge C-15-Y under the loading for $h^*=0.3$

All models were analyzed as static linear-elastic. Ghosn and Moses (1998) stated for the definition of the member failure limit state, an elastic analysis of the structural system should be performed to be consistent with evaluation techniques at the time. A linear-elastic analysis results in more conservative force results, however the deflections tend to be underestimated, but were deemed appropriate for this research. For example, the steel girder bridge C-15-C under a loading corresponding to $h^*=0.3$ resulted in a negative moment of 2,515 k-ft with a stress of 59 ksi. The member is still in the linear-elastic range, but the applied negative moment is much greater than the plastic moment capacity of 1,580 k-ft as shown in Figure 2.12. When generating the probabilities of failure, an applied moment of 1,600 k-ft or 20,000 k-ft would both be treated as failed. Therefore, a less robust approach, linear-elastic was adopted for this research.

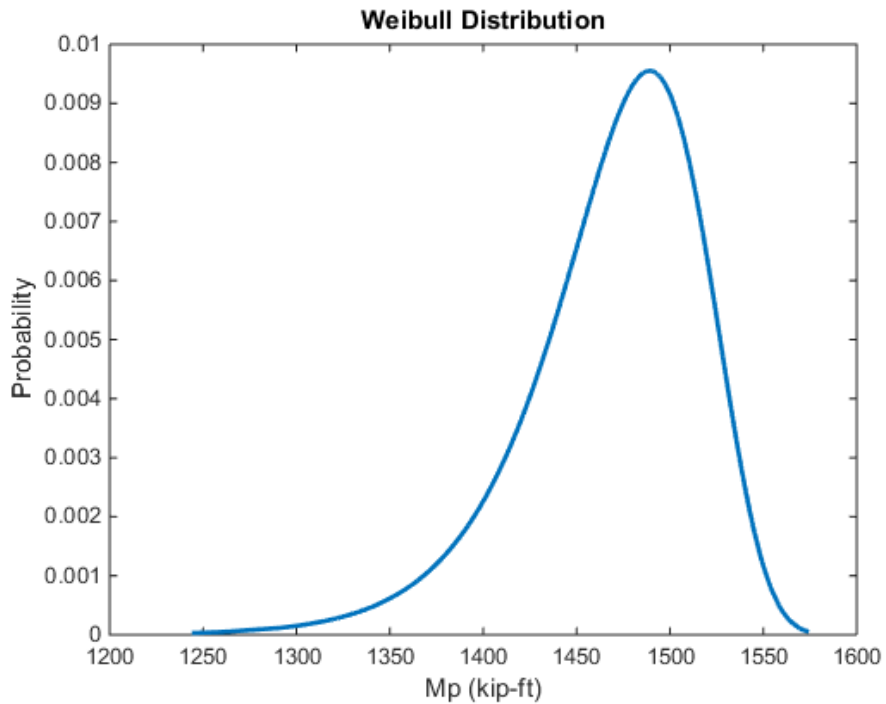


Figure 2.12 Negative plastic moment capacity for an internal girder on bridge C-15-C

Also, out of all of the bridges analyzed, only four had deflection beta values less than 3.5. Of those four, the beta values corresponding to negative moment was 0.14-0.42 less than the deflection values. For this reason, the negative moment criterion was deemed the most critical. Once the bridges are adjusted for the more critical ultimate strength capacity, then the deflection criterion will be met.

2.7 Procedure

Figure 2.13 presents a flow chart displaying the steps followed for the analysis of the bridges. The flowchart is organized such that the log Pearson type III parameters and construction drawings were already obtained. The analysis and results chapter will summarize the values obtained for each respective bridge following the procedure in Figure 2.13.

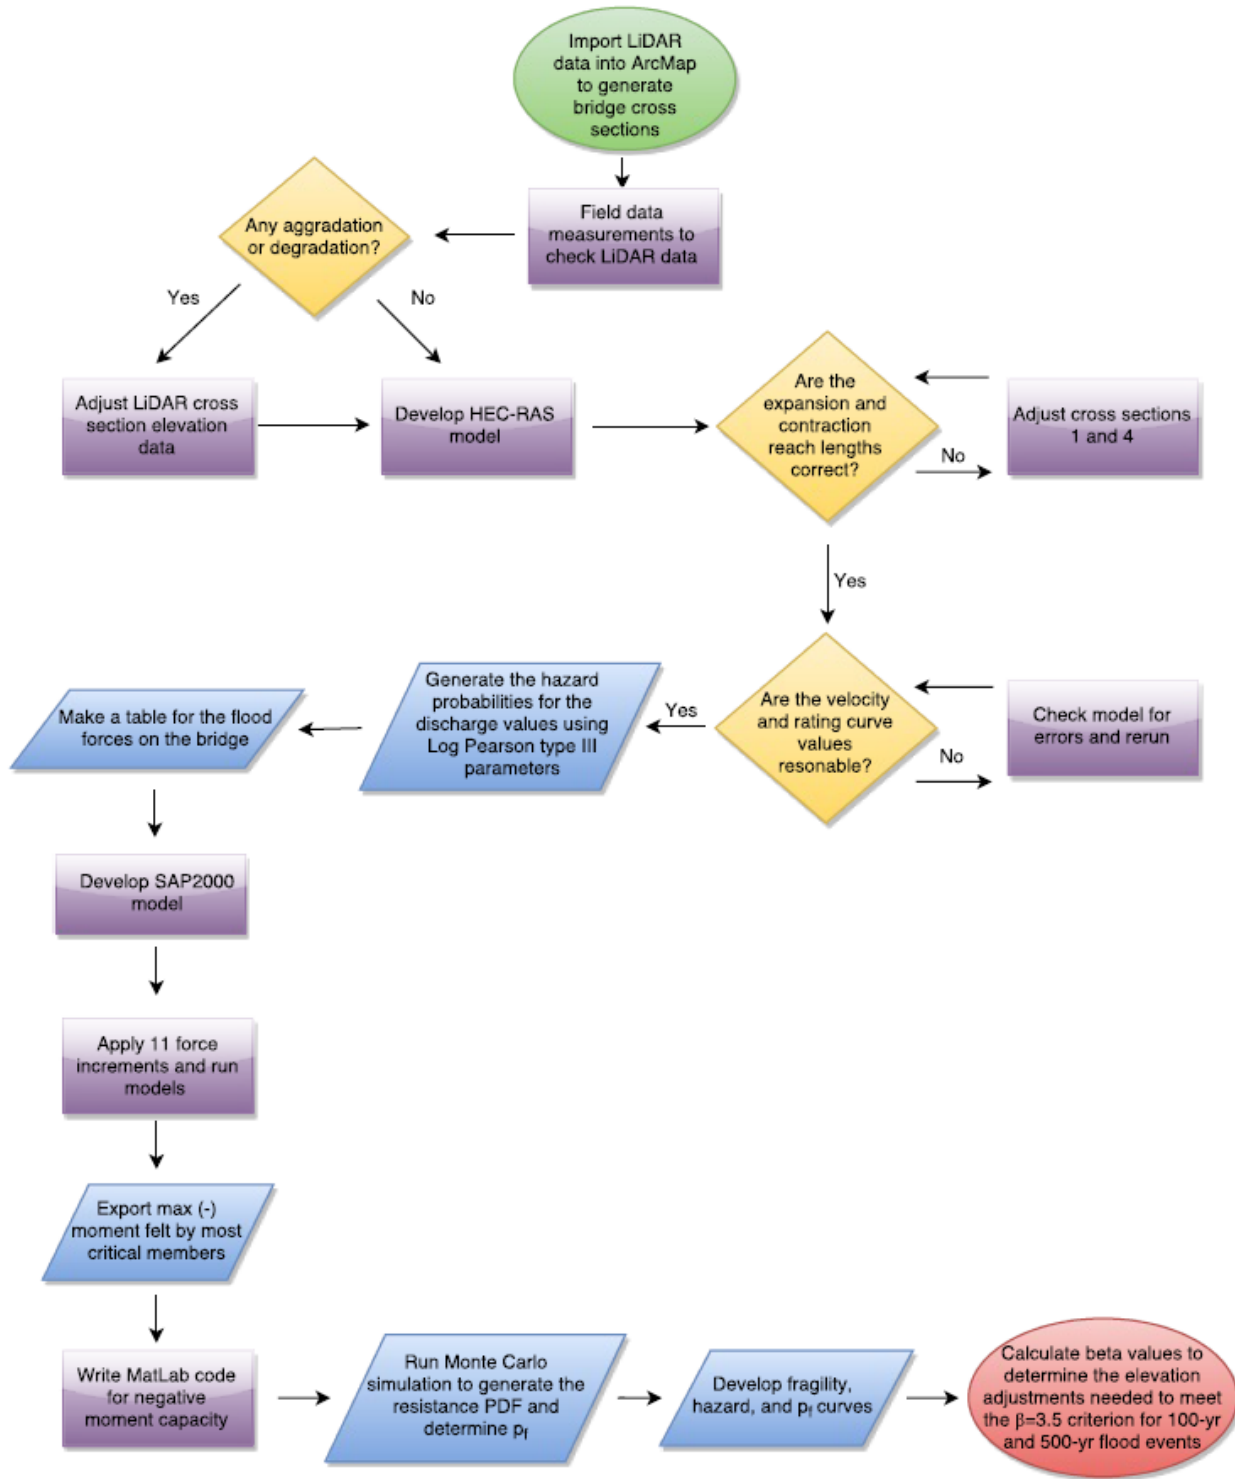


Figure 2.13 Flow chart of the procedure followed for calculating the beta values

3. RESULTS AND DISCUSSION

The methodology for developing fragilities for the bridge superstructure under flood-induced loads was thoroughly explained in the previous chapter. This chapter will go through the full procedure for each bridge and a discussion of the results. The discussion will start with the furthest upstream bridge C-15-AM and work downstream following the list in Table 2.1.1.

3.1 Bridge C-15-AM results

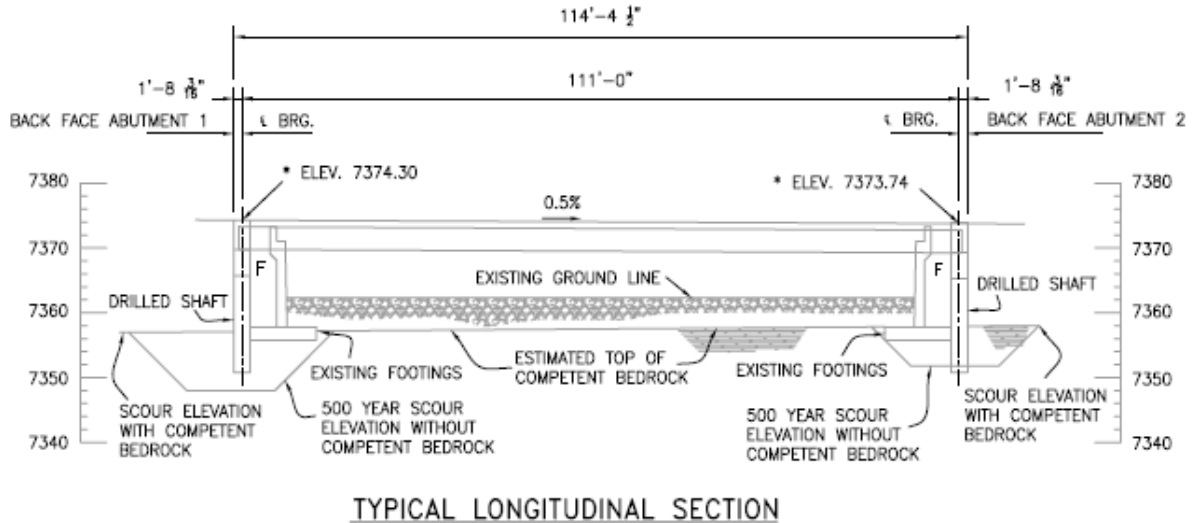


Figure 3.1 Longitudinal view of C-15-AM (CDOT see Appendix A)

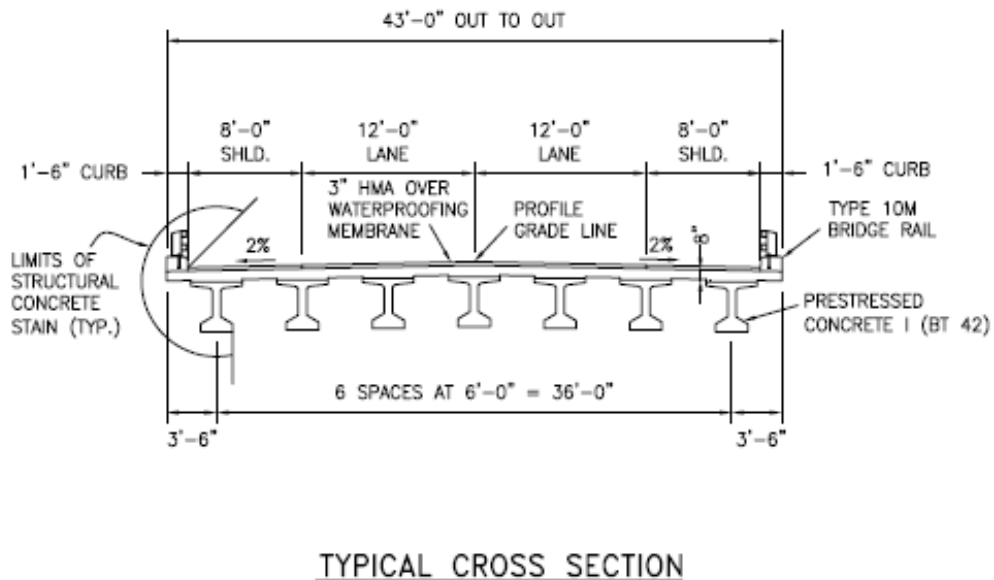


Figure 3.2 Cross sectional view of C-15-AM (CDOT see Appendix A)

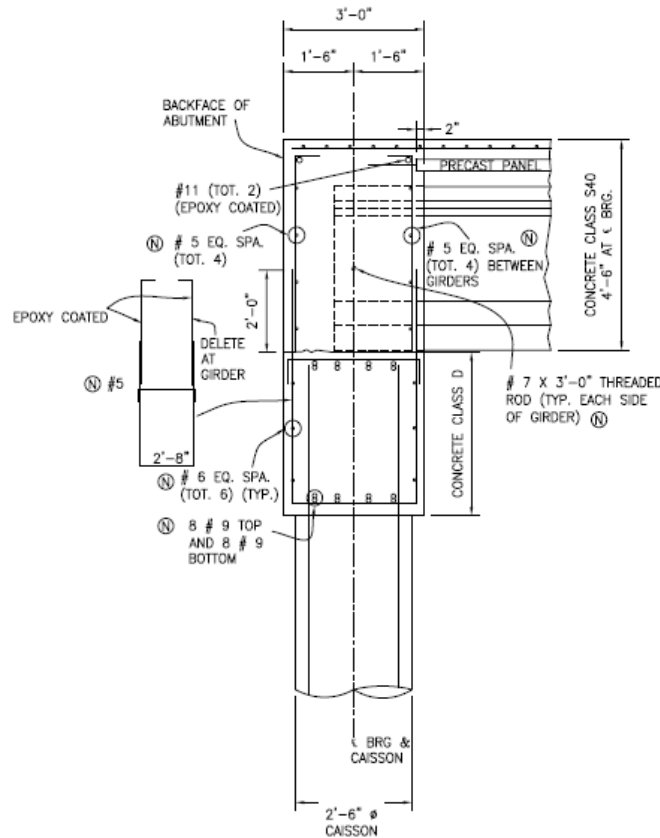


Figure 3.3 Typical integral abutment layout (CDOT see Appendix A)

Figures 3.1 and 3.2 are typical construction drawings for the bridges analyzed in this study. The bridges include prestressed bulb tee (most common), prestressed box girder, and steel I beams. A full list of the construction drawings are provided in Appendix A. Figure 3.3 shows the structural configuration of an integral abutment bridge. The girders are embedded two feet into the cast in place concrete, which leads to a fixed condition.

C-15-AM had 1-2 ft of aggradation in the channel. The LiDAR raw data was adjusted such that the channel elevations were the same as the construction plans. Damage due to the September flood was minimal at this location. There was minor erosion behind the wingwall at abutment 2, abrasion and scaling on abutment 2 and a crack in the asphalt at abutment 1.



Figure 3.4 Cross sections generated in ArcMap for C-15-AM

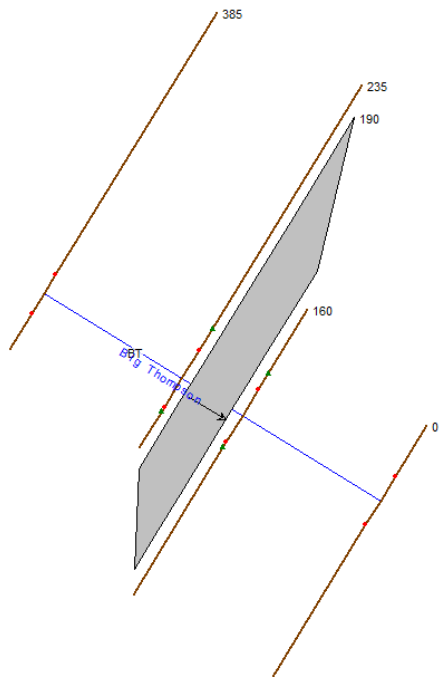


Figure 3.5 HEC-RAS geometric plan view for C-15-AM

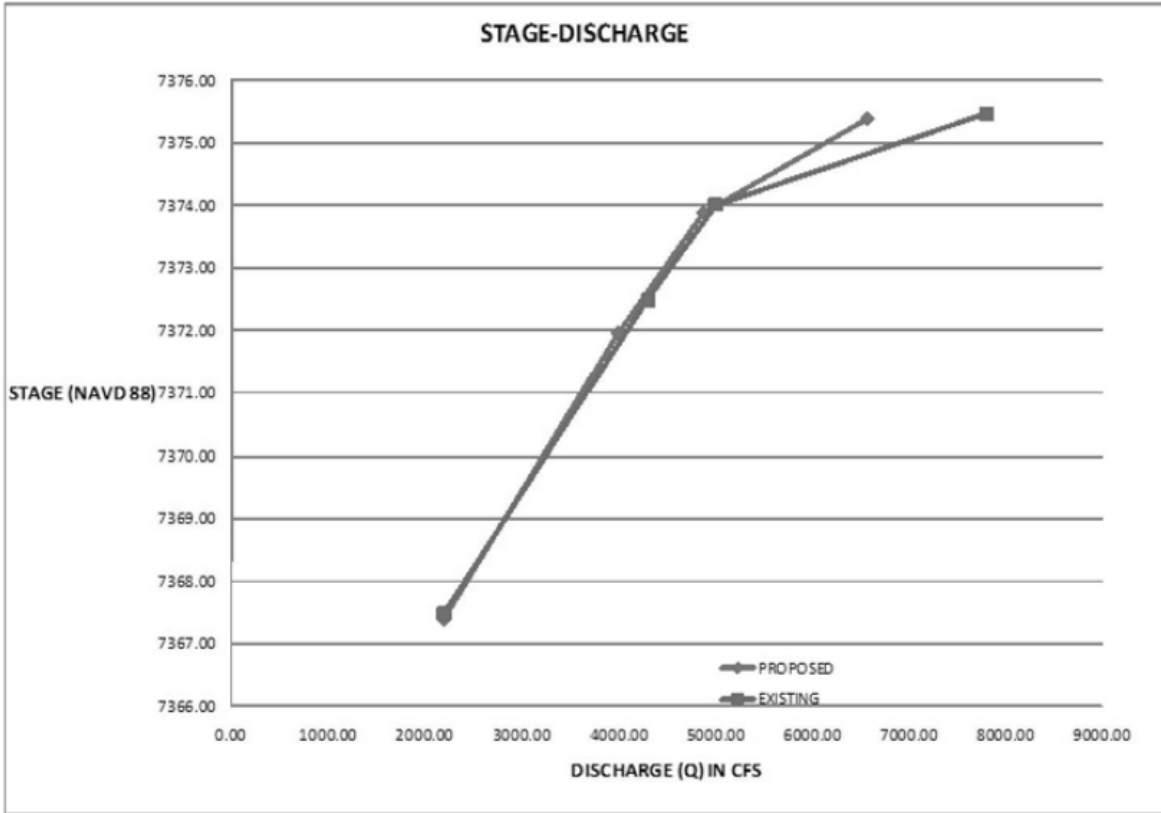


Figure 1.6 Plan rating curve for C-15-AM (CDOT see Appendix A)

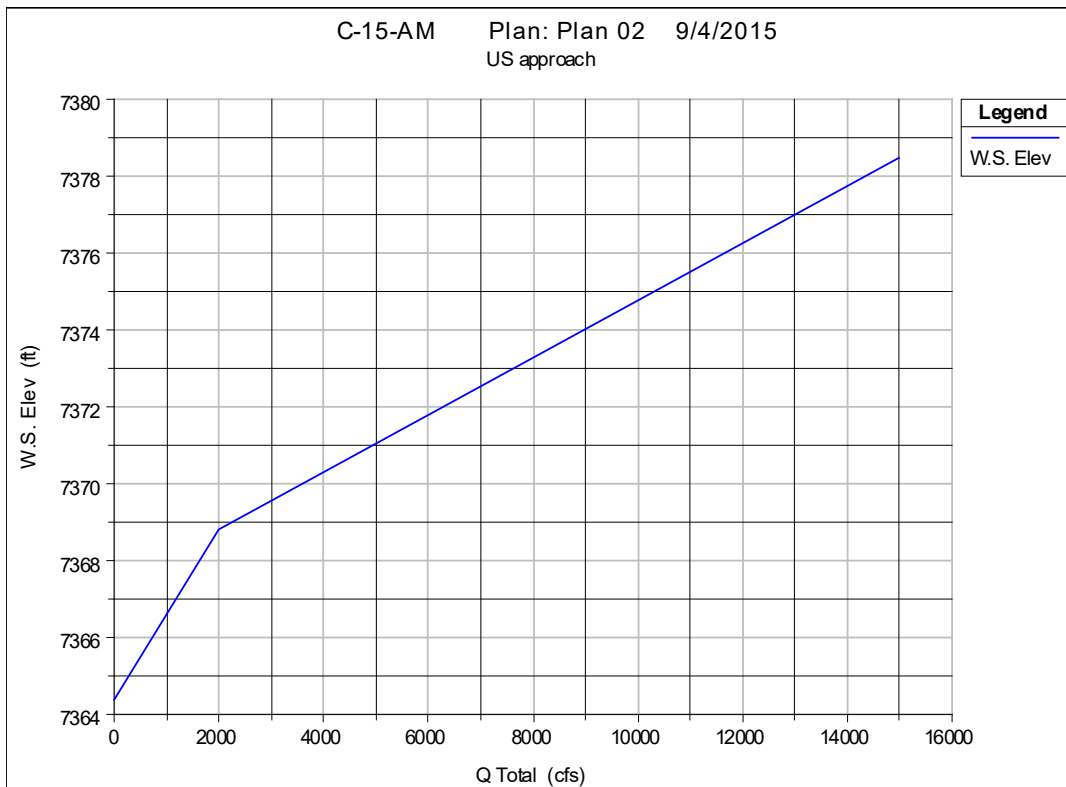


Figure 3.7 HEC-RAS generated rating curve for C-15-AM

A comparison of the actual configuration and the HEC-RAS model can be seen in Figures 3.7 and 3.8. Using the required four cross sections for generating a rating curve at a bridge was sufficient enough to capture the interaction between the natural stream and the bridge. Figure 3.1.6 and 3.1.7 are the rating curves from the construction plans and the HEC-RAS model. The contact and overtopping discharge for the plans is 2,500 and 5,200 cfs respectively. In comparison, the HEC-RAS curves' values are 1,900 and 9,200 cfs. The velocity values for the model are 2 ft/s higher in magnitude. The model shows close agreement with the construction plans and slight differences are expected.

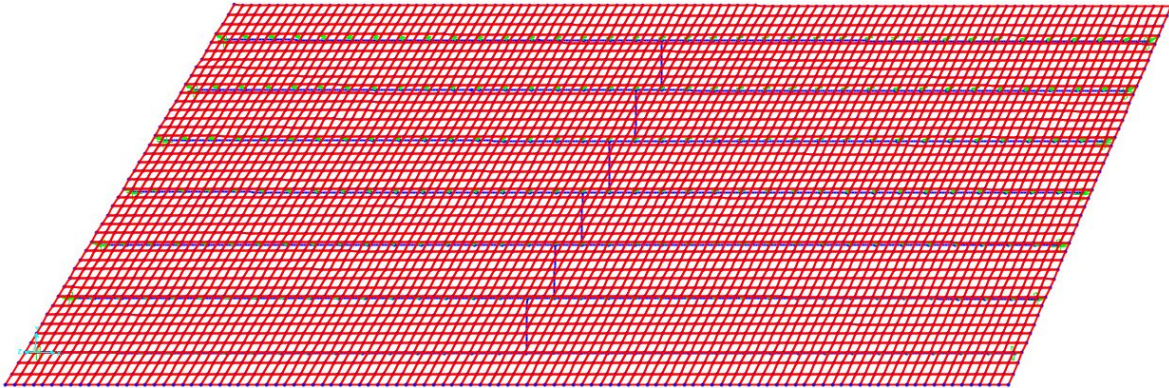


Figure 3.8 SAP2000 model for C-15-AM

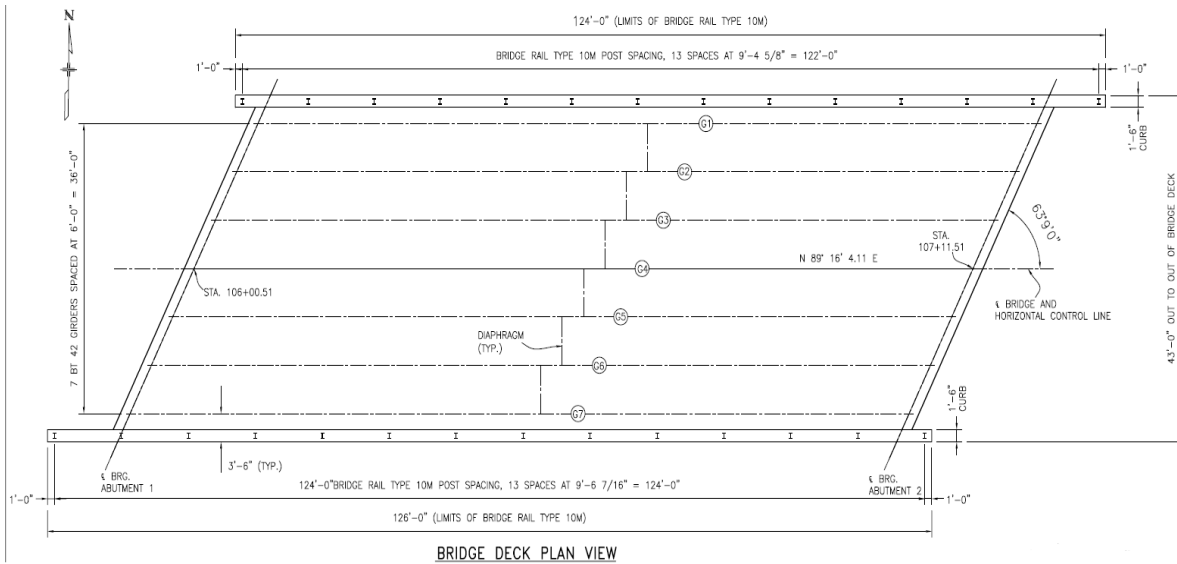


Figure 3.9 Plan view of C-15-AM (CDOT see Appendix A)

Figure 3.8 is a plan view of the SAP2000 prestressed bulb tee bridge C-15-AM. The girders are labeled starting with the northern-most girder, G1, down to the southern-most girder, G7. For the fragility analysis, the most critical external and internal girder was selected. In the case of this bridge, G7 and G2 were the most critical. It should be noted that beta values for the internal girder were always equal to or slightly greater than the external girders for every bridge in this study. Therefore, once the external criterion is met, the internal criterion is also satisfied.

Figure 3.9 is a plan view taken from the construction drawings for bridge C-15-AM. The SAP model compares well with the construction plans. The skew angle is 63.15° on the plans versus 63.17° on the model. Also, the length of the bridge, girder spacing, and the diaphragm locations are identical to the actual bridge. These similarities allow the model to transfer the loads and behave in the same manner as the constructed bridge.

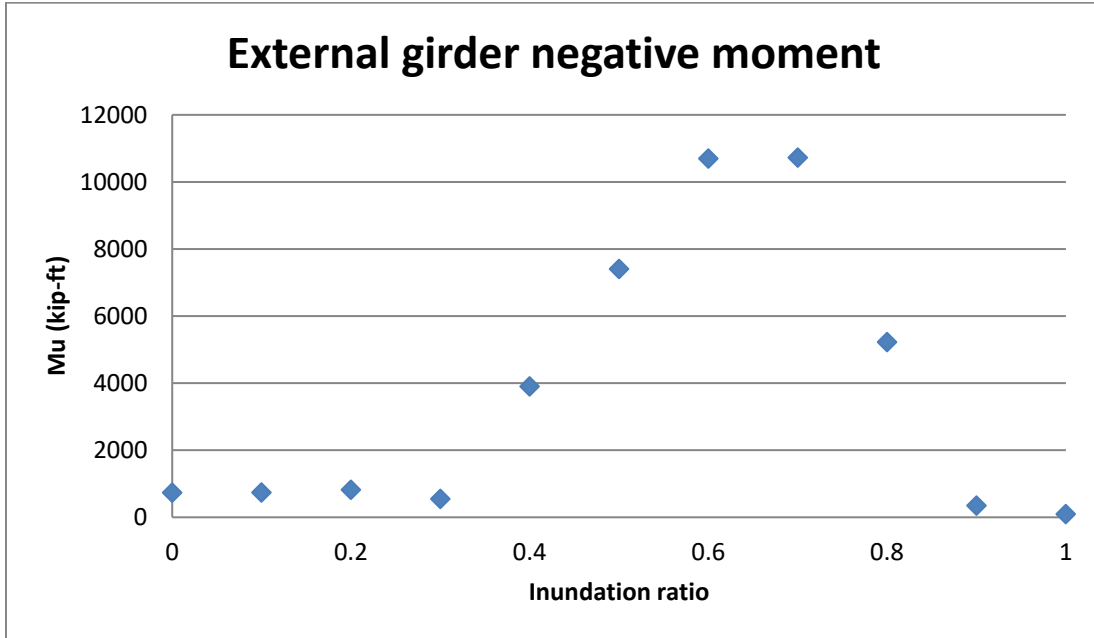


Figure 3.10 Applied negative moment felt by girder G7 for C-15-AM

Figure 3.10 displays the SAP2000 results for bridge C-15-AM. The reason for the decrease in magnitude after $h^*=0.7$ is attributed to the sharp increase in positive buoyancy force at $h^*=0.8$. At that value, the bridge deck is inundated, and the displaced volume increases from 5,660 to 8,700 ft^3/ft . Another reason for the decline is due to the shape of the lift coefficient. It peaks at $h^*=0.8$ and slightly decreases at $h^*=0.9$ and $h^*=1.0$, which can be seen on Figure 1.2. For this bridge, a polynomial best fit line did not result in a good fit to the Mu values. To counter this, a for loop was used to determine where each unique h^* value fell. For example, if the simulated h^* value was 0.235, then the resulting Mu value would be linearly interpolated from the data points on Figure 3.10.

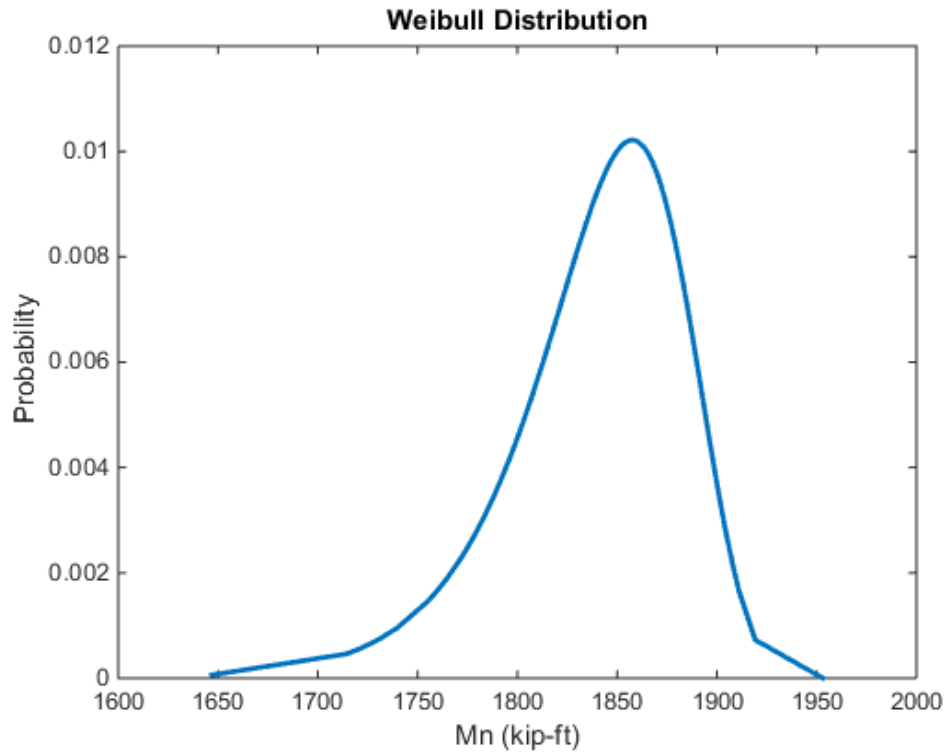


Figure 3.11 Negative nominal moment capacity for an external girder for C-15-AM

Figure 3.11 is a Weibull-fitted PDF function to the Monte Carlo simulation for the negative moment capacity. A goodness of fit test was performed to determine how well the fitted distribution matched the Monte Carlo simulation values. The normalized root mean square error was used where a value of negative infinity is a bad fit and a value of 1 is a perfect fit. The fitted parameters resulted in a value of 0.9146 — a very good fit for the data.

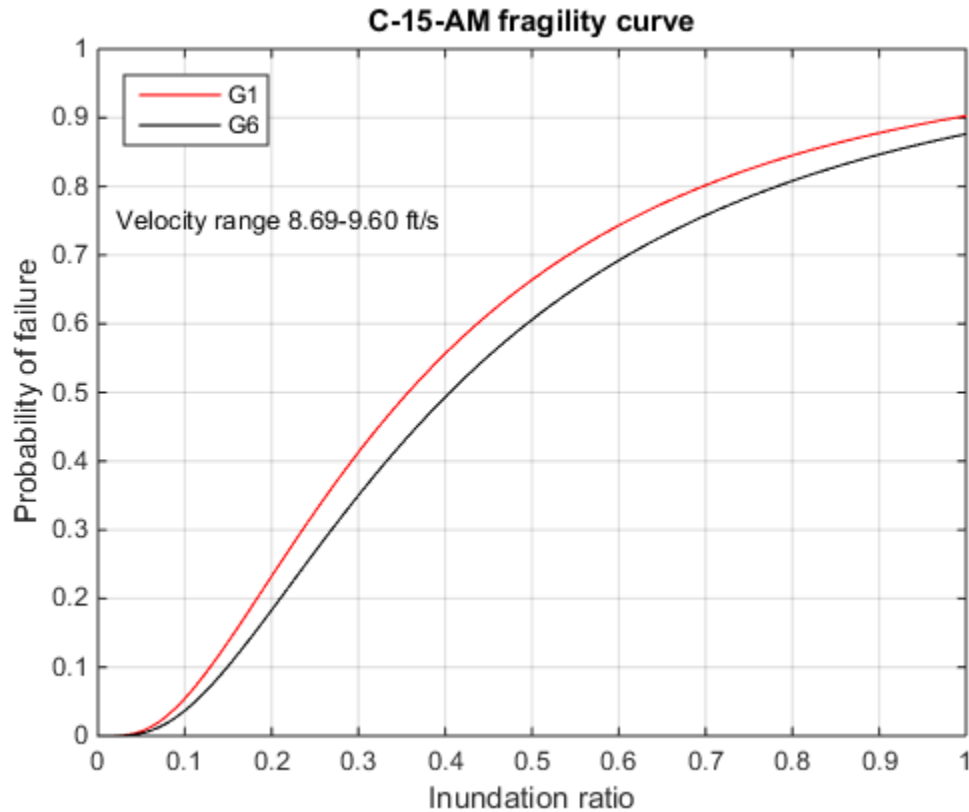


Figure 3.12 Fitted lognormal CDF function to the fragility values for C-15-AM

Utilizing the resistance and the demand distributions, a Monte Carlo simulation was then run to determine the fragility values for this specific bridge configuration. Fragilities do not incorporate hazard probabilities, which are very convenient for designers and stakeholders since they are, in theory, independent of location. If this bridge was built in any other location with the hazard probabilities and stage-discharge relationship known, then the bridge could be built to satisfy any target beta value. However, in the case for all bridges in this study, the fragility curves are a function of the velocity in the channel. Equations 1.1, 1.2, and 1.3 have a velocity squared term, which significantly affects the magnitude of the flood forces on bridge superstructures. If this bridge was built in the plains with shallow channel slopes, then the velocity values would obviously be less. This phenomenon limits the fragility curves in this study to steep fast-moving mountain streams or rivers. The fragility curve could be applied to a slower stream, but it would be overly conservative. Notice the velocity range on Figure 3.12. The range corresponds to the velocity at $h^*=0$ to $h^*=1$. Also, note that the two curves are for the most critical external and internal girder. The shape is the same, but the external girder is a scaled-up version of the internal girder due to the lower capacity of the external composite girder.

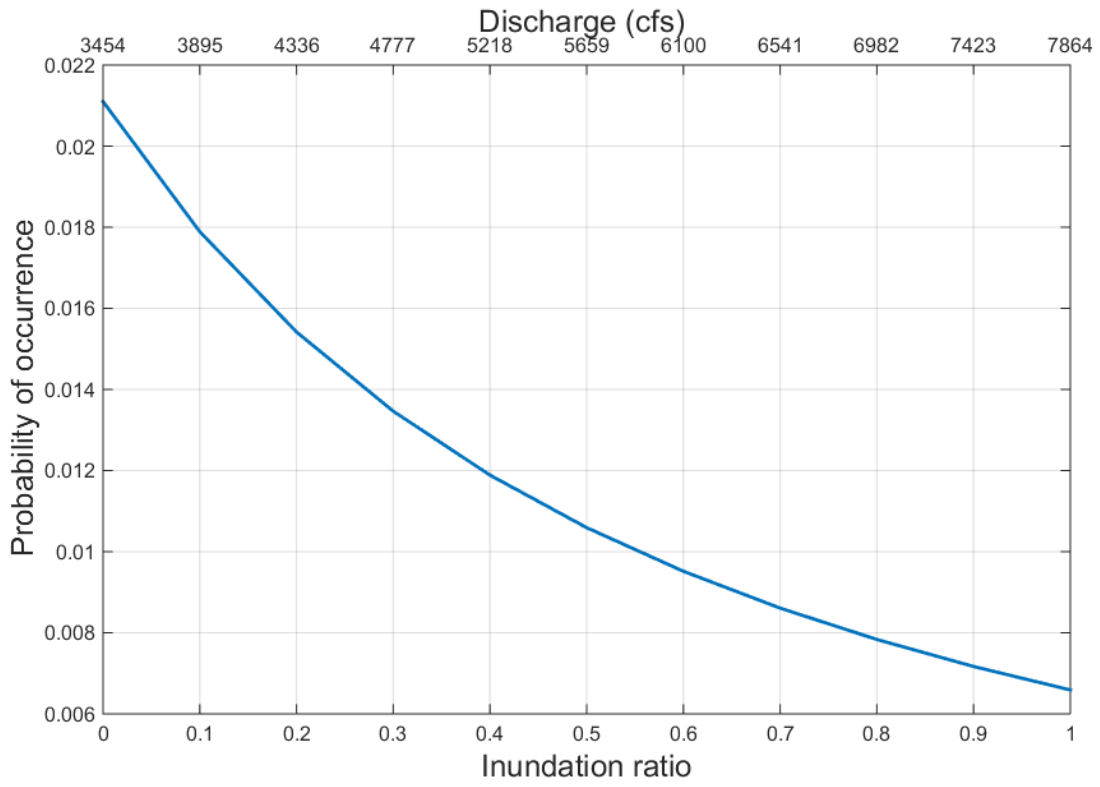


Figure 3.13 Hazard probabilities used to generate the probability of failure curve for C-15-AM

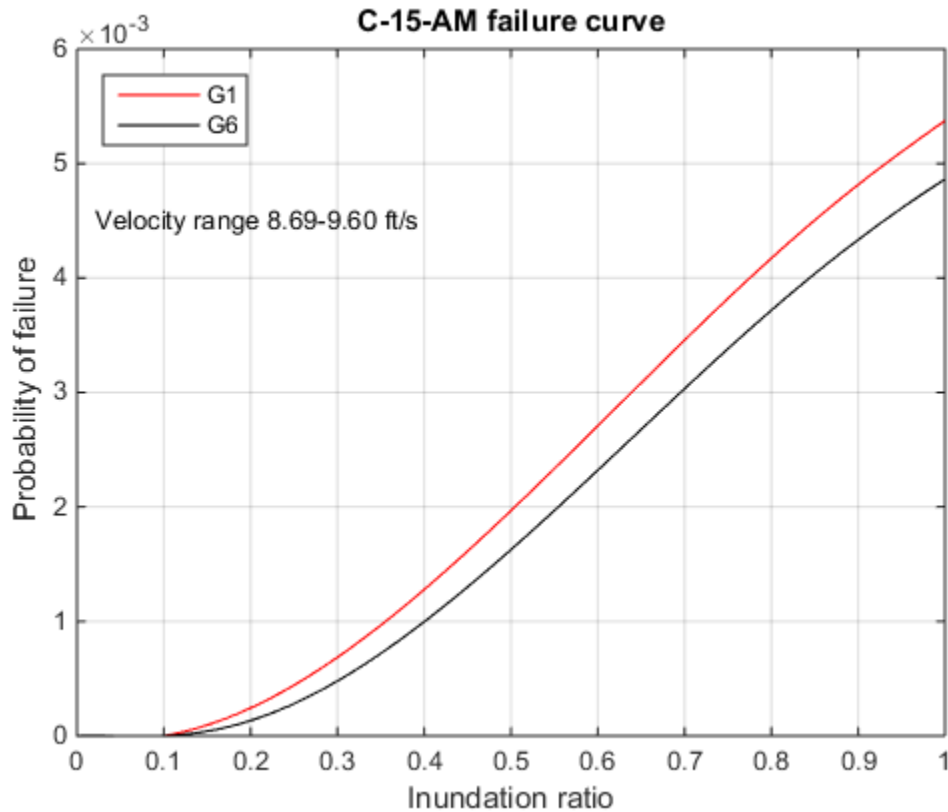


Figure 3.14 Probability of failure curve for C-15-AM

Due to the hazard being a continuous function of x , defined herein as the inundation ratio, the convolution integral was used to generate the probability of failure curve listed in Figure 3.14. The fragility values from Figure 3.12 were convolved with the hazard probabilities from Figure 3.13 to get the failure values. The value at $h^*=1$ was then used in equation 1.7 to calculate the reliability index. For this bridge, the reliability indices are 2.55 and 2.59 for the external and internal girders. To reach the target beta value of 3.5 for the 100-year flood, the bridge would have to be raised two feet. For the 500-year flood, the bridge would have to be raised 12.5 feet, which is likely infeasible. These values are calculated assuming the same stage-discharge relationship as the original bridge elevation.

3.2 Bridge C-15-AL results

The adjacent bridge downstream from C-15-AM is bridge C-15-AL. The length, number of girders, and structural configuration is the same as bridge C-15-AM minus a few differences, including are the skew angle and slope of the bridge. Figure 3.15 displays the difference in slope and Figure 3.16 shows the opposite skew relative to C-15-AM.

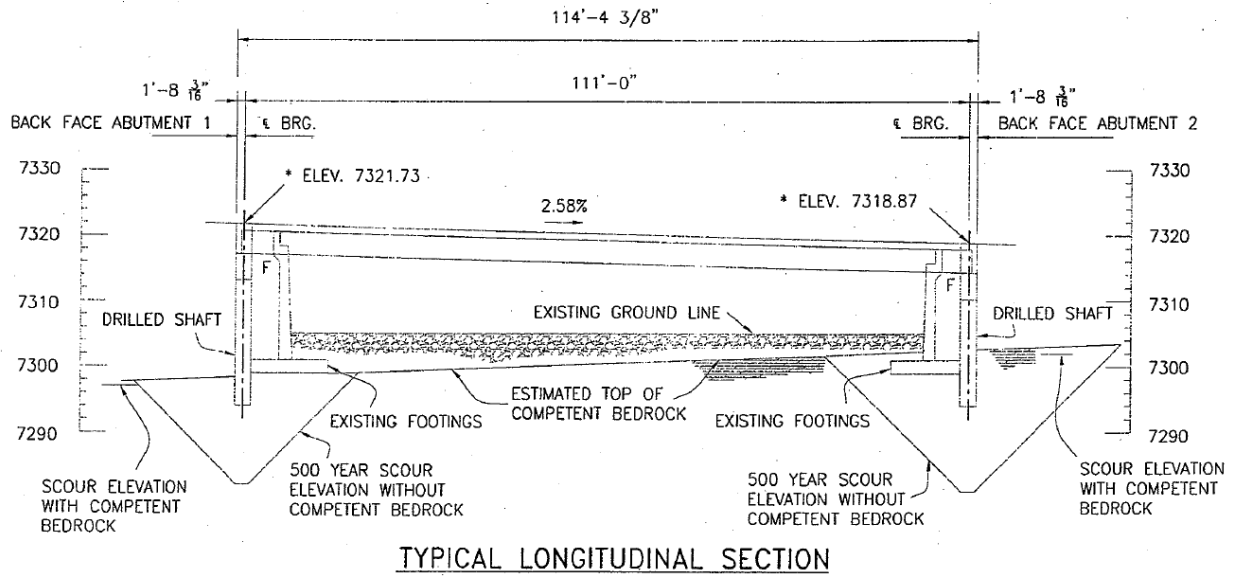


Figure 3.15 Longitudinal section of C-15-AL (CDOT see Appendix A)

The LiDAR data showed two feet of aggradation, but the field measurements showed two feet of degradation at abutment 1 and no change at abutment 2. Due to scour concerns, it was assumed that CDOT would adjust the channel bottom such that it would match the construction drawings. The LiDAR data was adjusted to reflect that assumption. No rating curve was provided for this bridge, so the bridge hydraulic information from C-15-AM was used to help gauge the accuracy of the developed HEC-RAS model for C-15-AL. The bridge geometry and distance between the low chord and the channel bottom were similar enough to deem this acceptable. The generated rating curve was not altered to match the plan curve due to the differences in the channel geometry where bridge C-15-AL had a higher level of meandering. The damage suffered at this bridge was limited to a crack in the asphalt.



Figure 3.16 Cross sections generated in ArcMap for C-15-AL

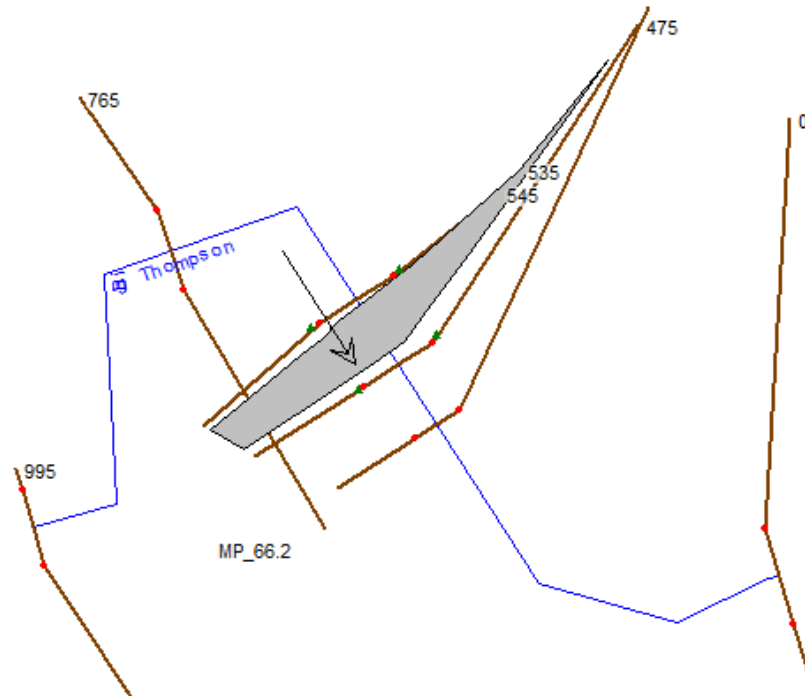


Figure 3.17 HEC-RAS geometric plan view for C-15-AL

Figure 3.16 is an aerial view of the cross sections exported from ArcMap for the HEC-RAS model. The LiDAR data layer is turned off to give a good view of the vegetation and shape of the channel. An extra cross section up and downstream was used for this reach to account for the meandering of the reach. In most cases, deleting the furthest upstream and downstream cross sections had minimal effects on the produced rating curve. For this bridge the extra cross sections resulted in a more reasonable rating curve when compared to the curve for bridge C-15-AM. Figure 3.17 is the geometric data view for the cross sections inputted into HEC-RAS. It should be noted that the blue reach lines have no factor in the model output. If the reach was drawn as a straight line, the rating curve yielded would be identical to the one in Figure 3.18.

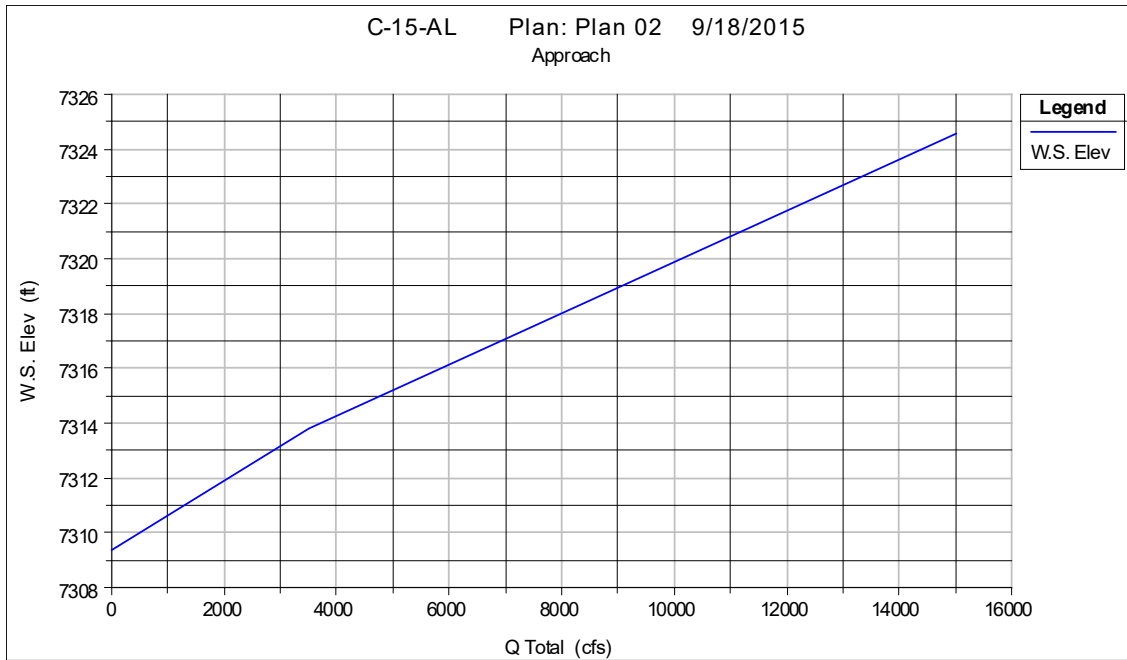


Figure 3.18 HEC-RAS rating curve for C-15-AL

The rating curve in Figure 3.18 gave reasonable values when compared to the contact and overtopping discharge values for bridge C-15-AM. The low chord and top of curve elevations are 7314.05' and 7319.30', which yields discharge values of 3789 and 9400 cfs. This compares well to the values for C-15-AM of 3454 and 7866 cfs. The velocity values range from 11.27 to 10.03 ft/s. The decrease in velocity can be attributed to the high friction losses from the furthest upstream cross section to the approach section in Figure 3.19. There is a shallow transition from the top of the right bank to the road. This gradual slope engages more of the floodplain for the increased discharge values associated with overtopping of the bridge.

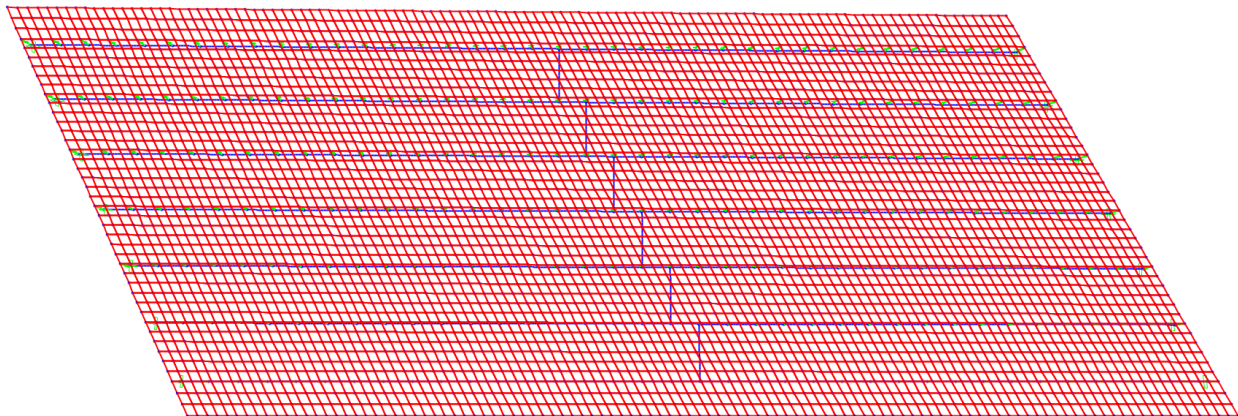


Figure 3.19 SAP2000 model for C-15-AL

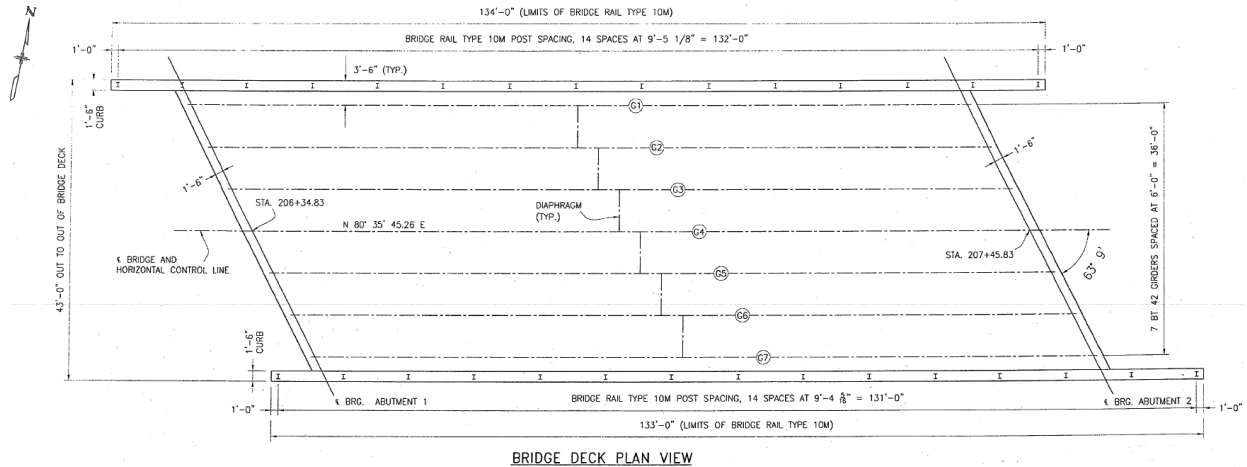


Figure 3.20 Plan view of the bridge deck for C-15-AL (CDOT see Appendix A)

Figure 3.20 and 3.21 are plan view comparisons of the FE model and the construction plans. The skew for the model is 63.17°, which compares well with the plans' skew of 63.15°. There are seven prestressed bulb tee 42 (BT 42) girders with a span of 108' and diaphragms located mid span. The slab was modeled with a thickness of 8.31" with an extra 0.31" to account for the higher strength prestressed panels. The model has same slope, skew, girder and shear stud spacing as the actual bridge, which allows the model to transfer the loads and behave in the same manner as the constructed bridge.

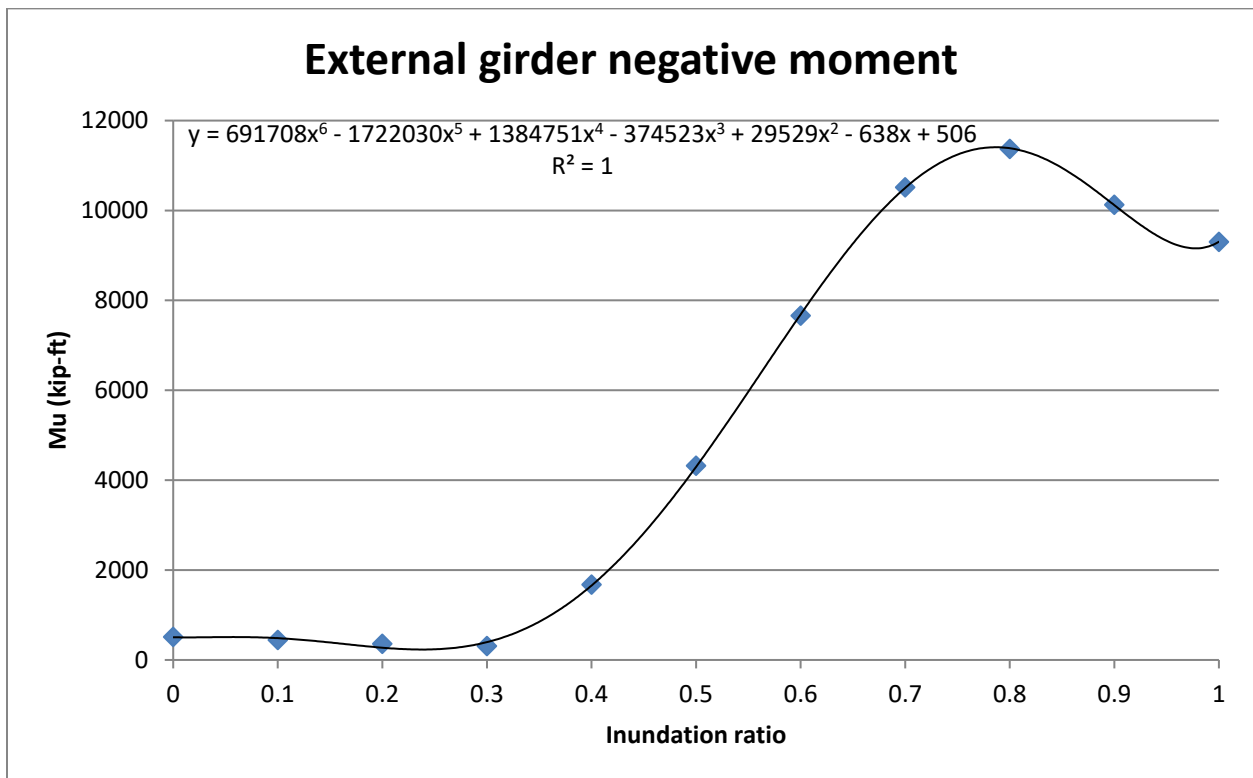


Figure 3.21 Applied negative moment felt by girder G1 for C-15-AL

Figure 3.22 presents the negative moment felt at each inundation ratio due to the lift force for the critical external member G1. The reason for the slight drop in moment from $h^*=0$ to $h^*=0.3$ is because the net lift force is positive due to the small lift coefficient relative to the positive buoyancy force. The slight dip occurring after $h^*=0.8$ is attributed to the volume of the slab being included in the buoyancy force which lowers the applied load.

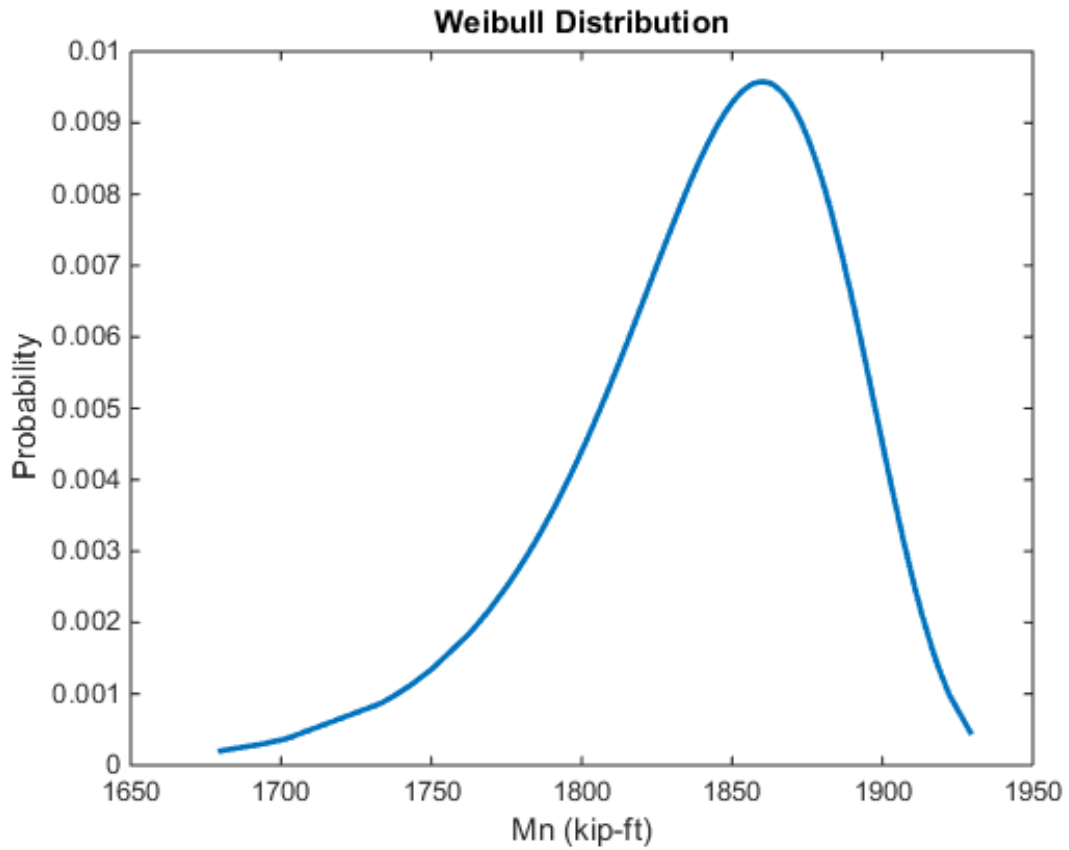


Figure 3.22 Negative nominal moment capacity for an external girder for C-15-AL

Figure 3.23 displays the resulting fitted Weibull PDF to the Monte Carlo simulation for the negative moment capacity. The normalized mean square error test resulted in a value of 0.8927, which is a good fit.

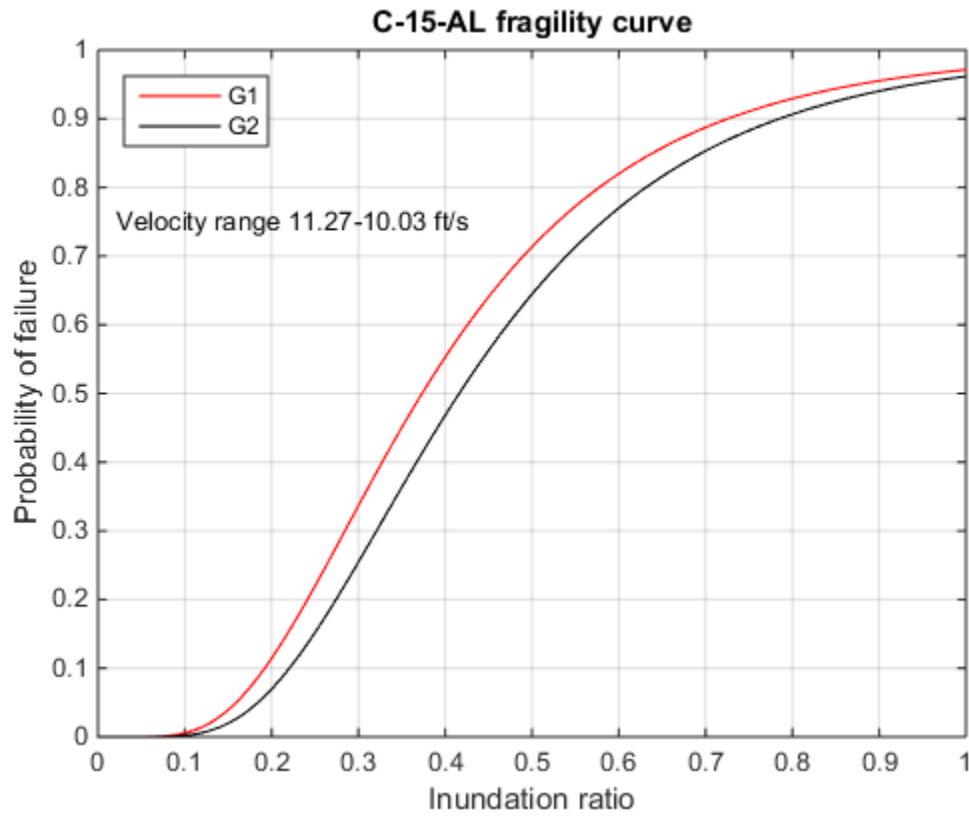


Figure 3.23 Fitted lognormal CDF function to the fragility values for C-15-AL

Figure 3.24 displays the fragility curve for C-15-AL under the velocity range of 11.27 to 10.03 ft/s. The shape and magnitudes are similar to C-15-AM, which is expected due to the similarities in structural configuration and location along the Big Thompson River.

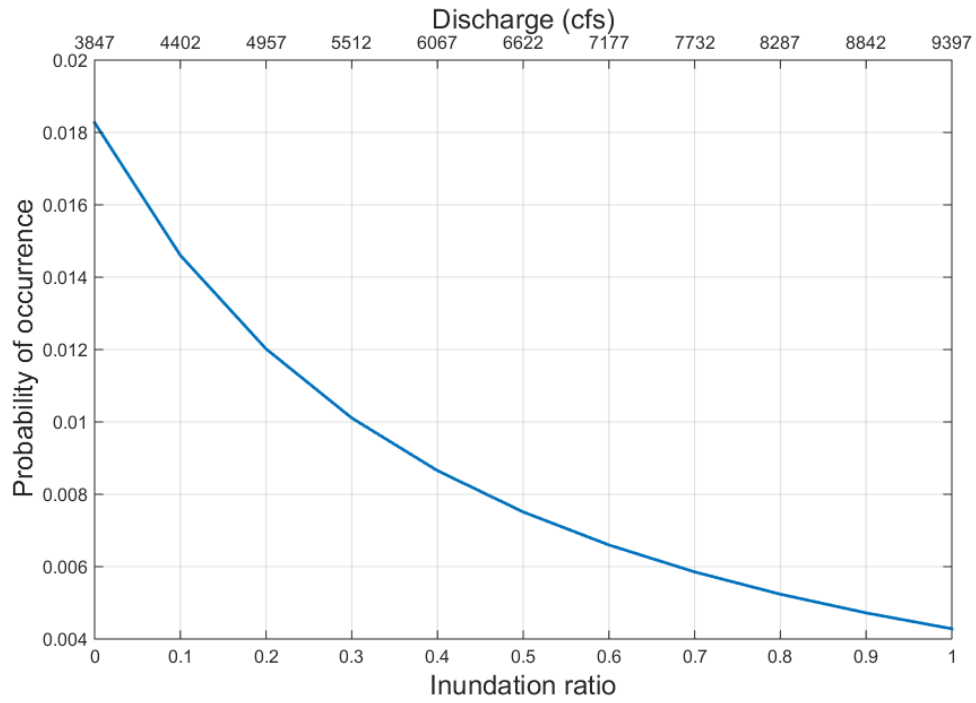


Figure 3.24 Hazard probabilities used to generate the probability of failure curve for C-15-AL

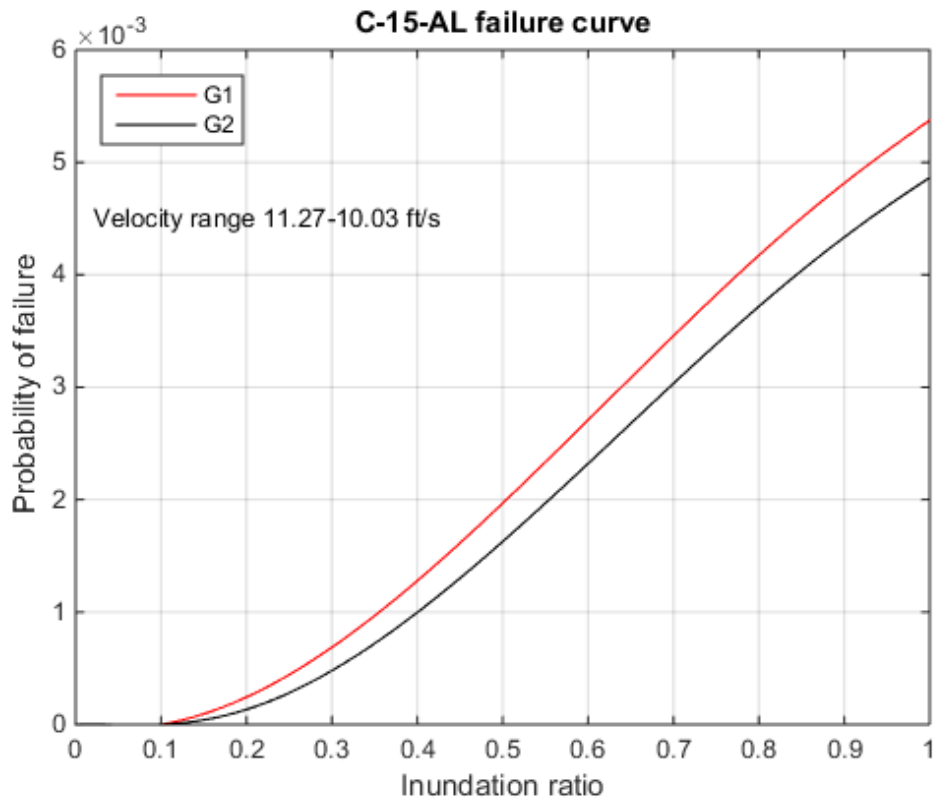


Figure 3.25 Probability of failure values for C-15-AL

The beta values are 2.67 and 2.70 for the external and internal girders. To satisfy the target beta value criterion for the 100 and 500 year flood event, the bridge would need to be raised by 1' and 9' respectively. These values are very similar to C-15-AM, which is to be expected.

3.3 Bridge C-15-O results

C-15-O is a 2 span prestressed box girder bridge located 2.65 miles downstream from C-15-AL. The floodplain has limited vegetation and the river approaches with little meandering. This leads to higher velocity values when compared to the previous bridges. Field measurements determined that there was 1.5' of degradation at the bridge exit, which led to altering the LiDAR data to reflect the post flood repairs by CDOT.

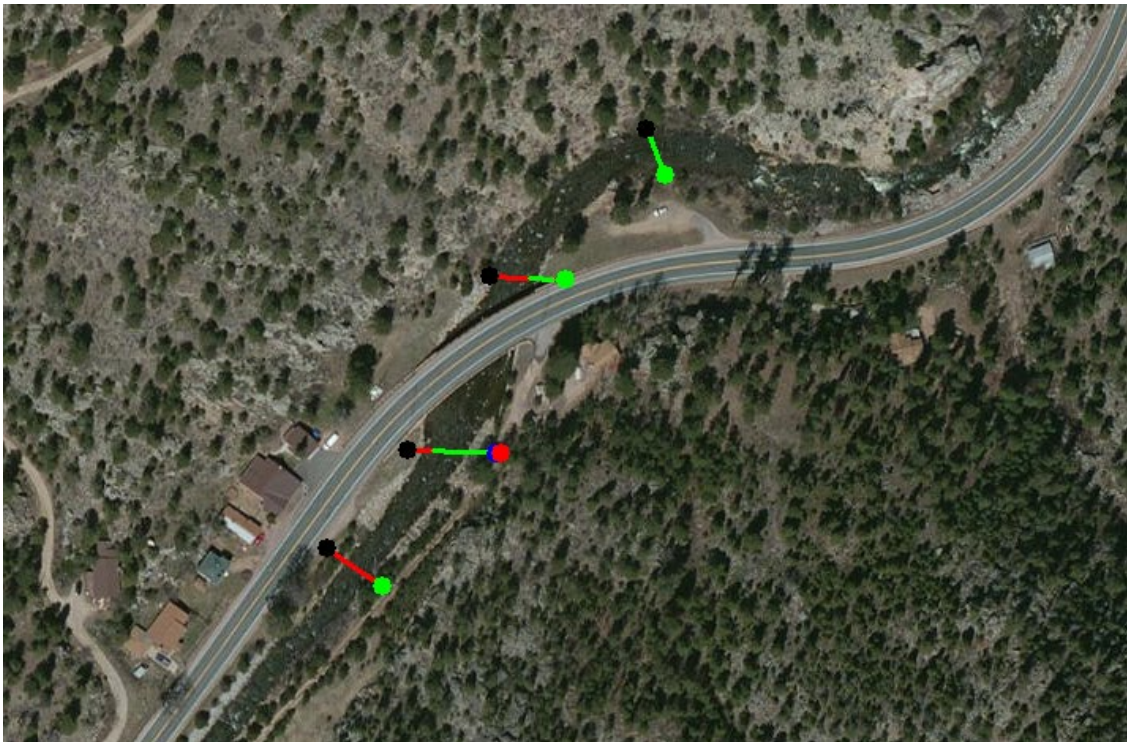


Figure 3.2 Cross sections generated in ArcMap for C-15-O

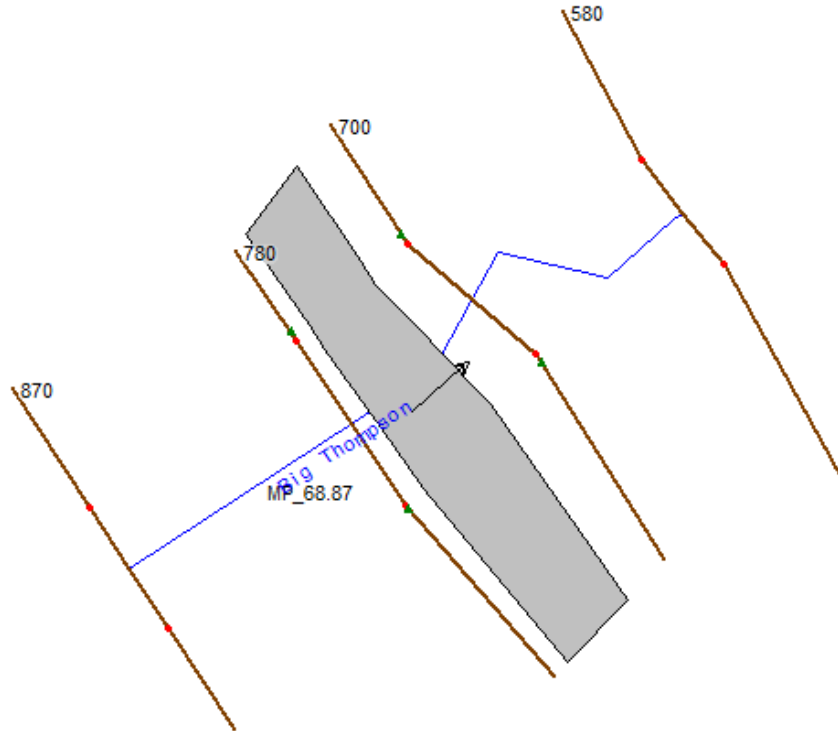


Figure 3.3 HEC-RAS geometric plan view for C-15-O

The cross sections used for the HEC-RAS model only required the four necessary cross sections for generating a rating curve at a bridge. When adding an additional cross section further up or downstream, the produced curve values stayed the same. This makes sense for the downstream cross section due to the flow having already fully expanded and there are little obstructions to affect the flow at the approach section. The additional upstream cross section had no affect for this bridge due to the channel slope and floodplain topography being identical to the already present cross sections. Damage suffered at C-15-O as a result of the September flood was 2.5' of erosion at abutment 1's retaining wall, 4-12" of exposed caisson top for two of the pier columns, crack in asphalt overlay at abutment 1 and multiple minor cracks throughout the wingwalls and retaining walls.

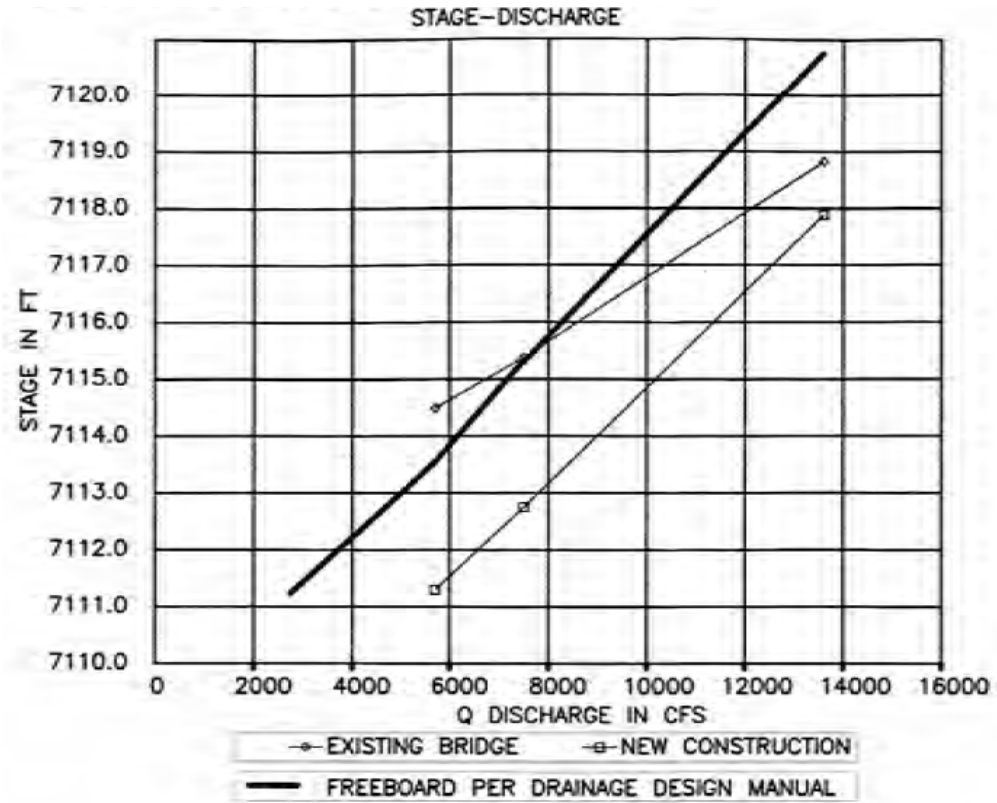


Figure 3.4 Plan rating curve for C-15-O (CDOT see Appendix A)

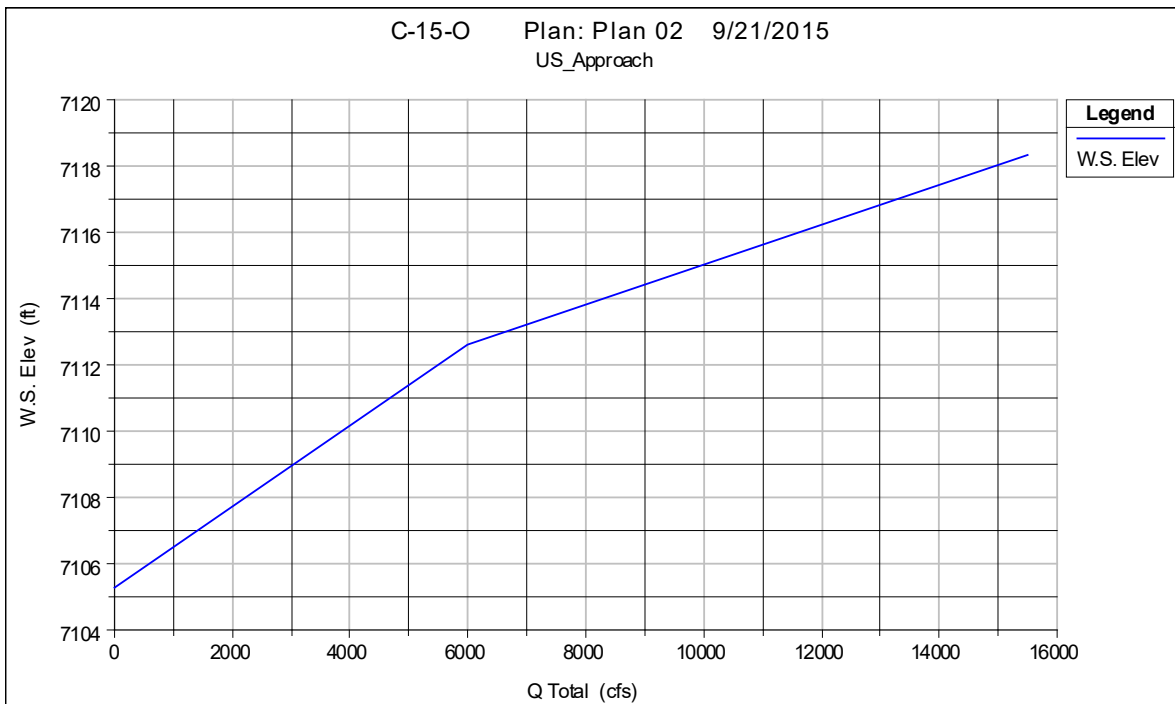


Figure 3.5 HEC-RAS rating curve for C-15-O

Figure 3.30 and 3.31 display the rating curve from the bridge hydraulic information sheet and the generated curve from HEC-RAS. The contact and overtopping discharge values for the plans' curve are 7800 and 11900 cfs respectively, whereas the HEC-RAS curve values are 6400 and 12300 cfs. This compares very well, and the main difference lies with the velocity values. The bridge information gives a single value for velocity of 10.6 ft/s, which is considerably lower than the HEC-RAS values of 14.32-16.19 ft/s. Channel and floodplain alterations since the time of the construction can lead to this discrepancy.

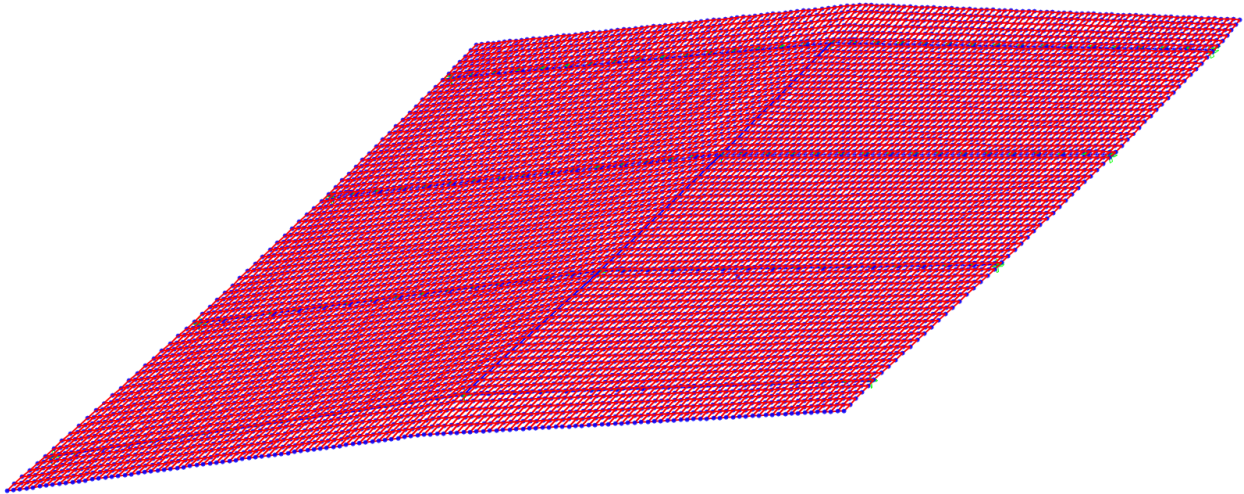


Figure 3.30 SAP2000 model for C-15-O

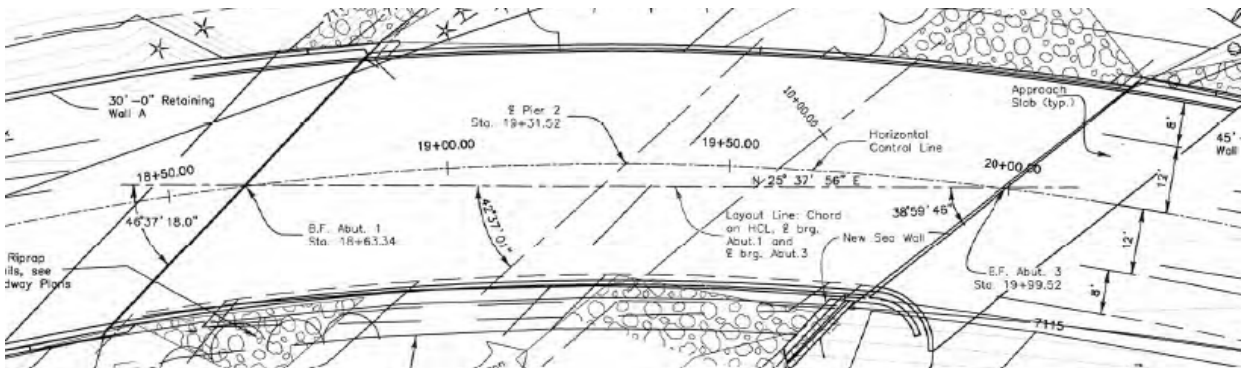


Figure 3.31 Plan view of the bridge deck of C-15-O (CDOT see Appendix A)

This bridge had several different skew angles at each bent that made it difficult to mesh uniformly and not have any misaligned rigid links. When comparing the skew at abutment one, the models skew is 40.76° as opposed to the plans value of 46.62° . At the pier, the angle stayed the same and resulted in a difference of 1.86° . At abutment 3, the model skew was 38.84° versus 39.99° from the plans. Overall, there is good agreement with the FE model and the actual bridge.

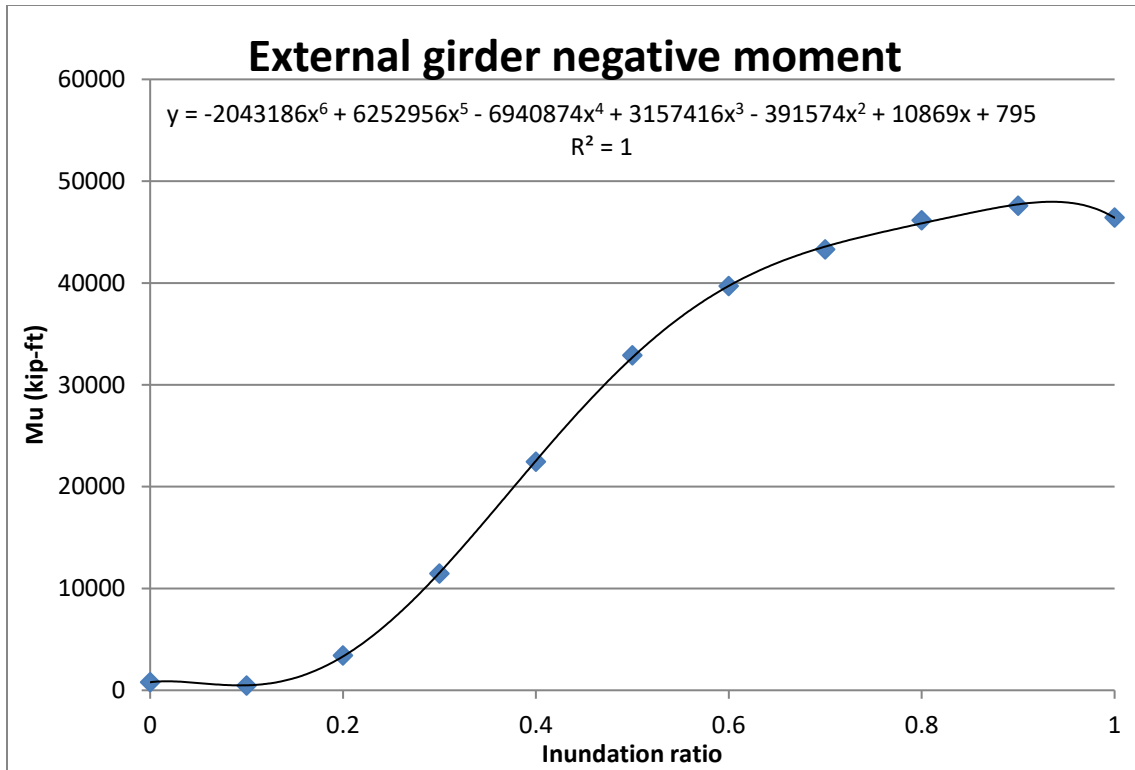


Figure 3.32 Applied negative moment felt by G1 span 2 for C-15-O

Figure 3.32 is a polynomial best fit line for the resulting negative moment on G1 due to the applied negative lift force. The overall trend is expected and follows the lift coefficient shape. The initial dip at $h^*=0.2$ is due to the buoyancy force controlling and exerting an uplift force on the bridge.

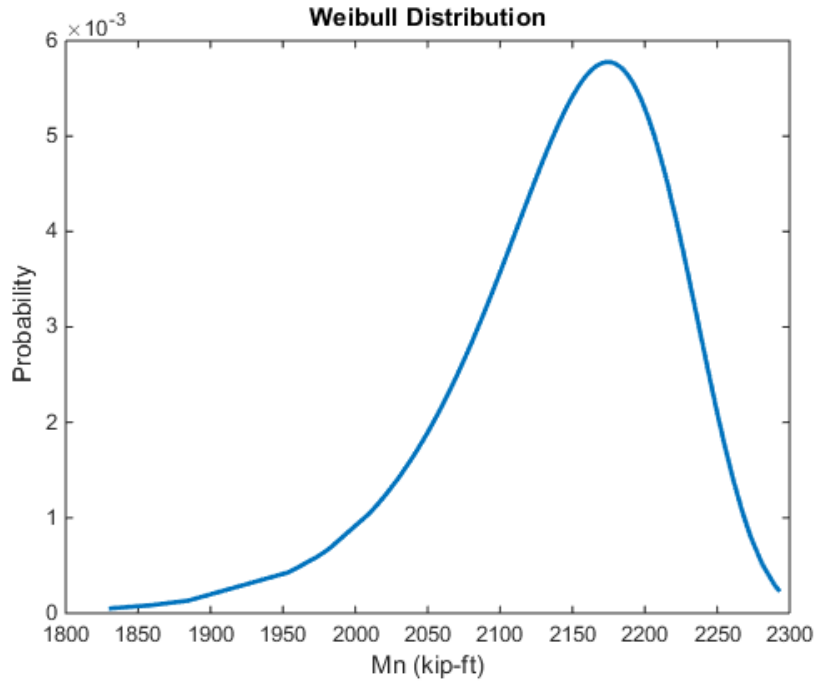


Figure 3.33 Negative nominal moment capacity for an external girder for C-15-AL

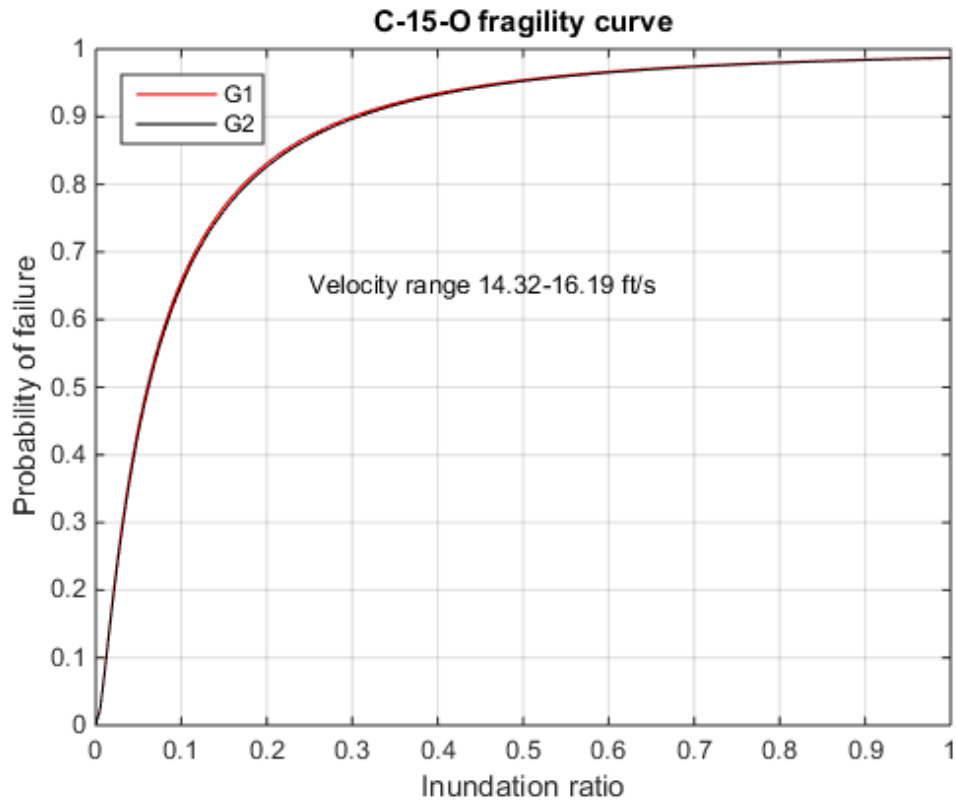


Figure 3.6 Fitted lognormal CDF function to the fragility values for C-15-AM

Figure 3.33 displays the resulting fitted Weibull PDF to the Monte Carlo simulation for the negative moment capacity. The normalized mean square error test resulted in a value of 0.9512, which is a good fit.

Figure 3.35 displays the fragility curve for C-15-O under the velocity range of 14.32 to 16.19 ft/s. The curve is very steep due to the high velocity and force values. The negative moment capacity was reached between $h^*=0.1$ and $h^*=0.2$.

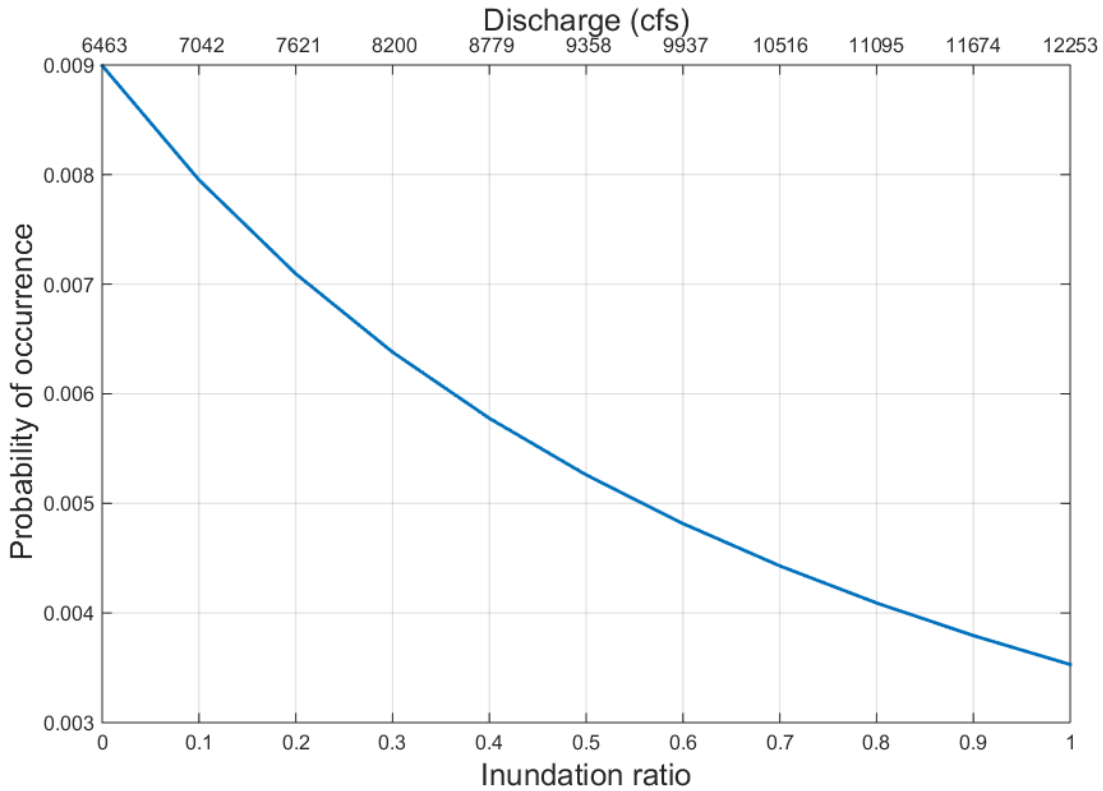


Figure 3.7 Hazard probabilities used to generate the probability of failure curve for C-15-O

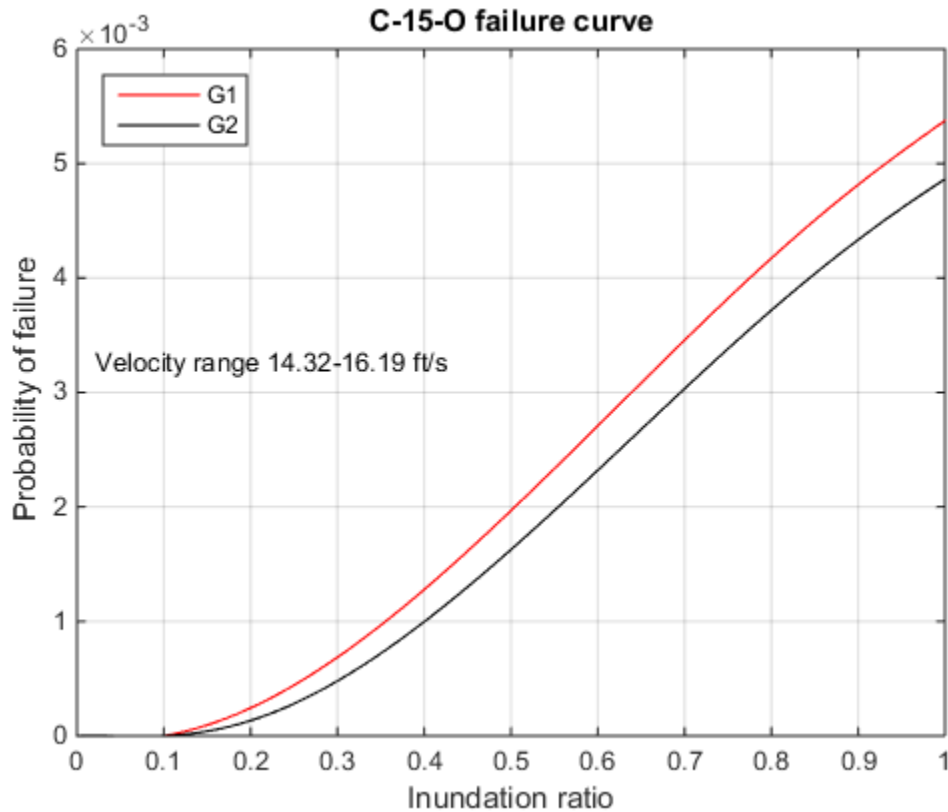


Figure 3.8 Probability of failure values for C-15-O

After incorporating hazard probabilities, the probability of failure values for the Big Thompson River location can be obtained. For this bridge, the beta values for the critical external and internal girder were 2.59. To meet the beta value criterion for the 100-year flood no adjustments are needed due to the flood not making contact with the low chord of the bridge. However, to meet the criterion for the 500-year flood, the bridge would need to be raised five feet.

3.4 Bridge C-15-U results

C-15-U suffered minor damage as a result of the September 2013 flood. There were cracks with efflorescence on the wingwall at abutment 1, cracks in the asphalt with small settlements at both abutments, exposed rebar at the downstream side of the wingwall at abutment 1 and spalling throughout the length of one of the four girders. The LiDAR data showed good agreement with the plan sheet elevations, so no revisions were necessary.

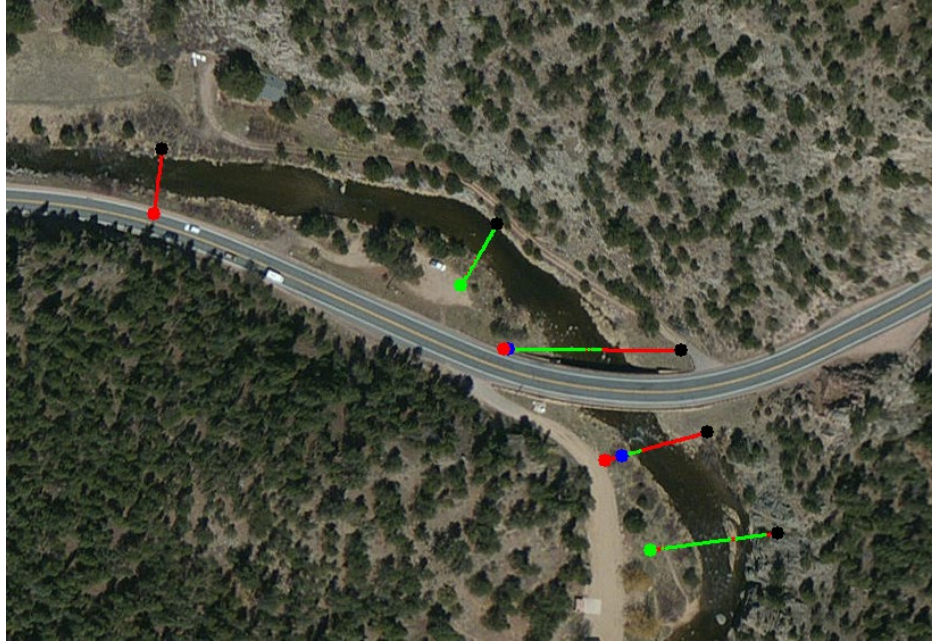


Figure 3.9 Cross sections generated in ArcMap for C-15-U

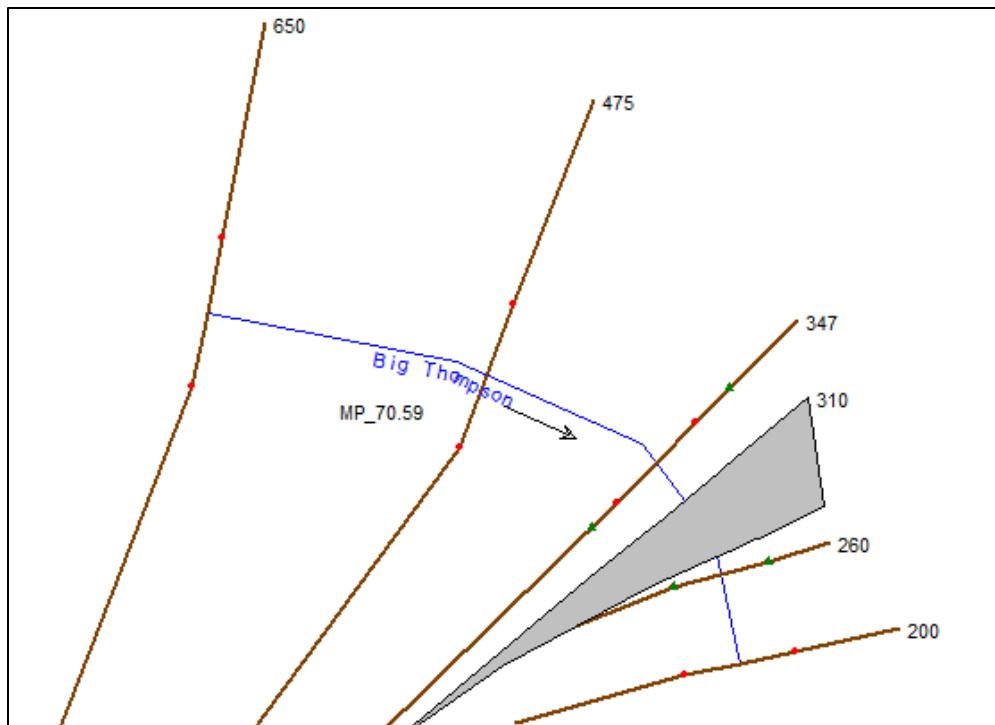


Figure 3.10 HEC-RAS geometric plan view for C-15-U

Figure 3.37 and 3.38 show a plan view of the actual bridge and the HEC-RAS model. For this bridge, the extra upstream cross section was deemed necessary due to the change in floodplain and constricted channel overbank areas.

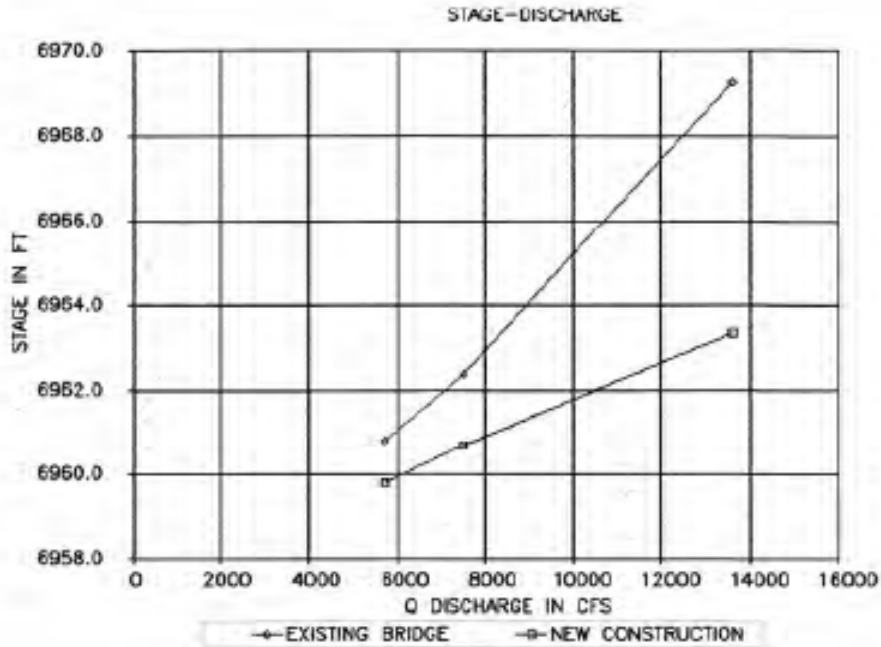


Figure 3.11 Plan rating curve for C-15-U (CDOT see Appendix A)

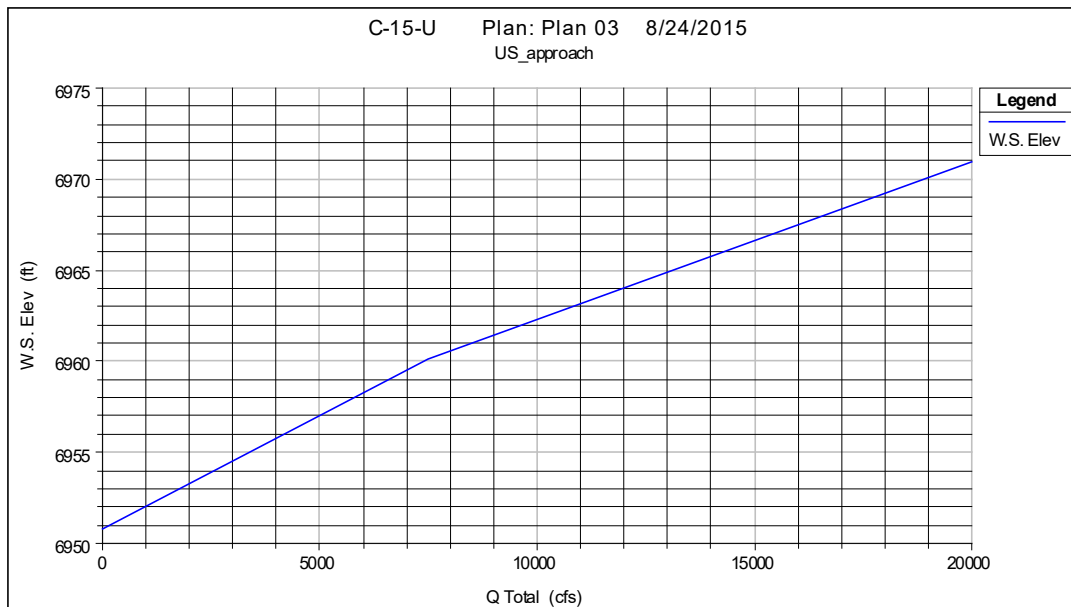


Figure 3.40 HEC-RAS rating curve for C-15-U

Due to the overtopping discharge not being listed on the plan rating curve, the only gauge of accuracy was on the contact discharge. The plans had a contact discharge value of 11000 cfs compared to 10400 cfs from the HEC-RAS curve. The velocity values generated on the HEC-RAS model are in close agreement with the ultimate velocity on the plans. The models velocity ranges from 7.22 to 5.13 ft/s compared to the ultimate velocity of 7.60 ft/s.

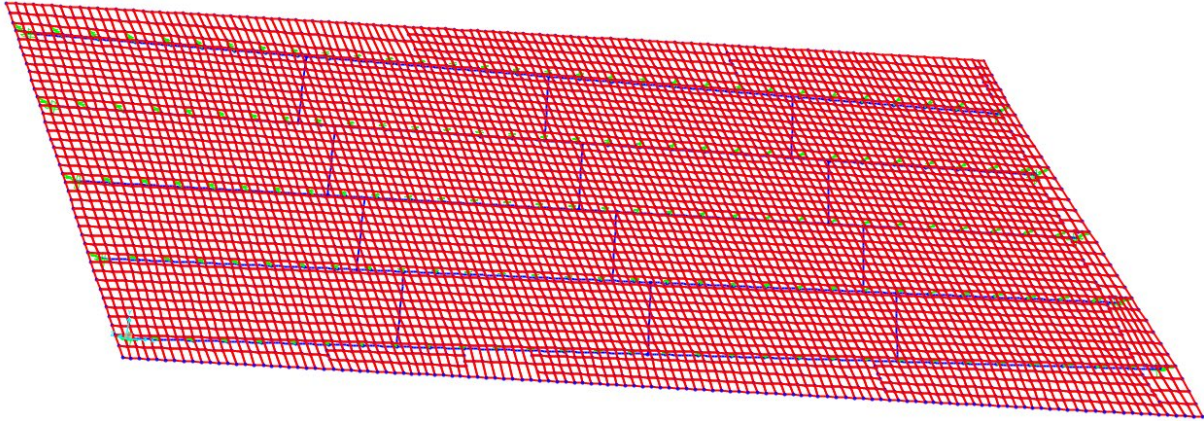


Figure 3.41 SAP2000 model for C-15-U

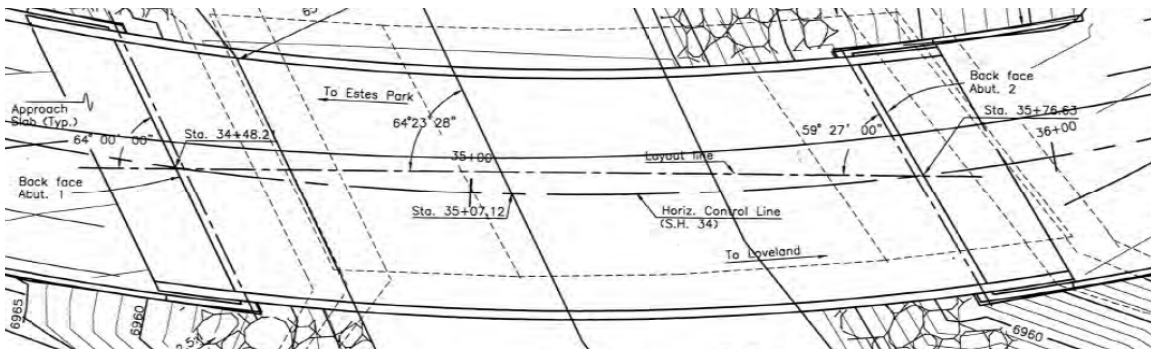


Figure 3.42 Plan view of the bridge deck of C-15-U (CDOT see Appendix A)

The difference in the skew angles at abutment 1 and 2 are 0.01° and 0.15° respectively. This is a prestressed bulb tee 5 girder single span bridge. There are some meshes on the shell elements whose nodes do not line up due to the varying overhang distances throughout the bridge length. Instead of modeling the curved nature of the slab, it was modeled as a trapezoidal shape taking into account the overhang values at each abutment. The few nodes whose meshes do not line up are not an issue as long as it does not occur at the rigid link locations, which it does not.

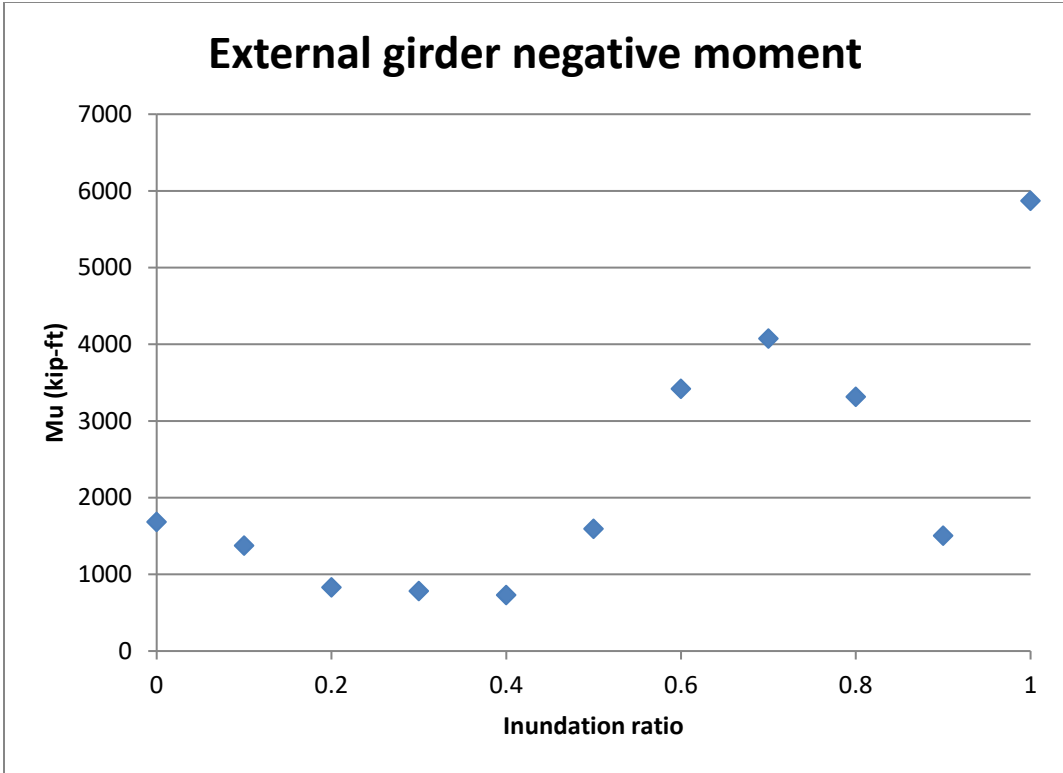


Figure 3.43 Applied negative moment felt by G1 for C-15-U

Figure 3.43 displays the negative moment felt by G5 under the negative lift force. The relatively low velocity values, large variation in abutment heights and buoyancy forces leads to the roller-coaster values for the girder. For example, if abutment 2 is under the condition of $h^*=1.0$, then abutment 1 feels $h^*=0.595$.

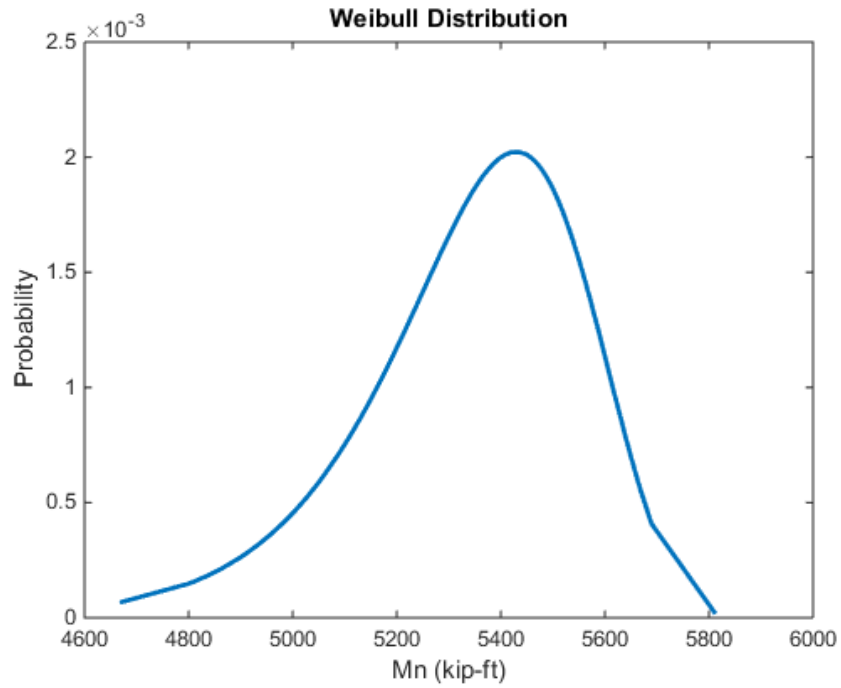


Figure 3.12 Negative nominal moment capacity for an external girder for C-15-U

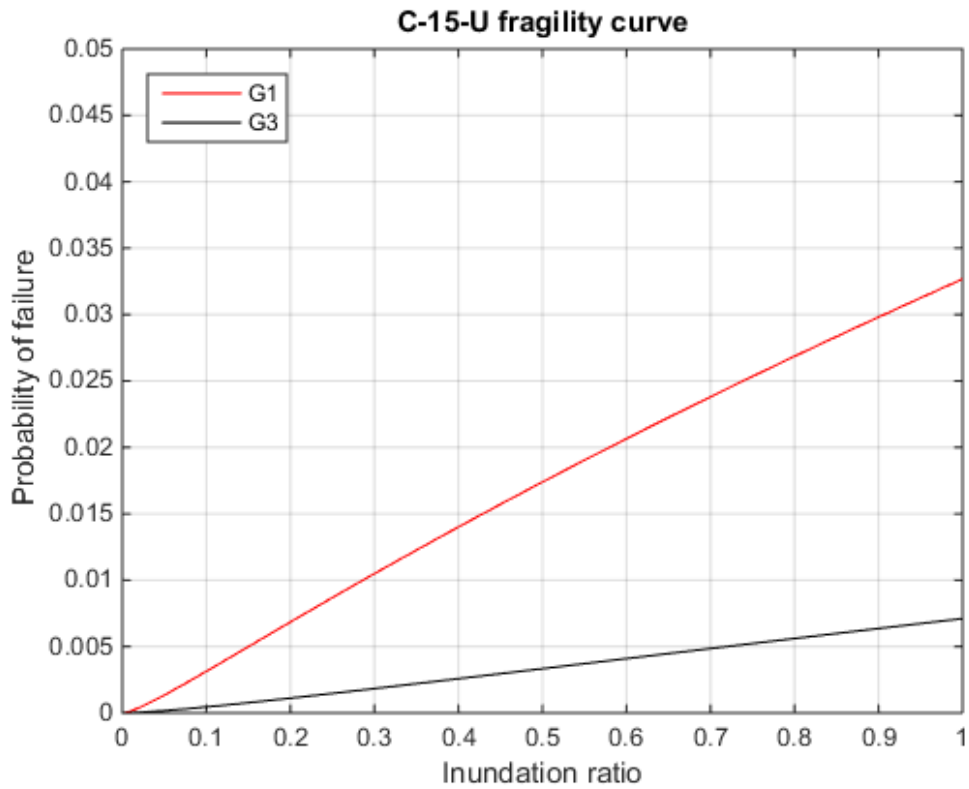


Figure 3.13 Fitted lognormal CDF function to the fragility values for C-15-U

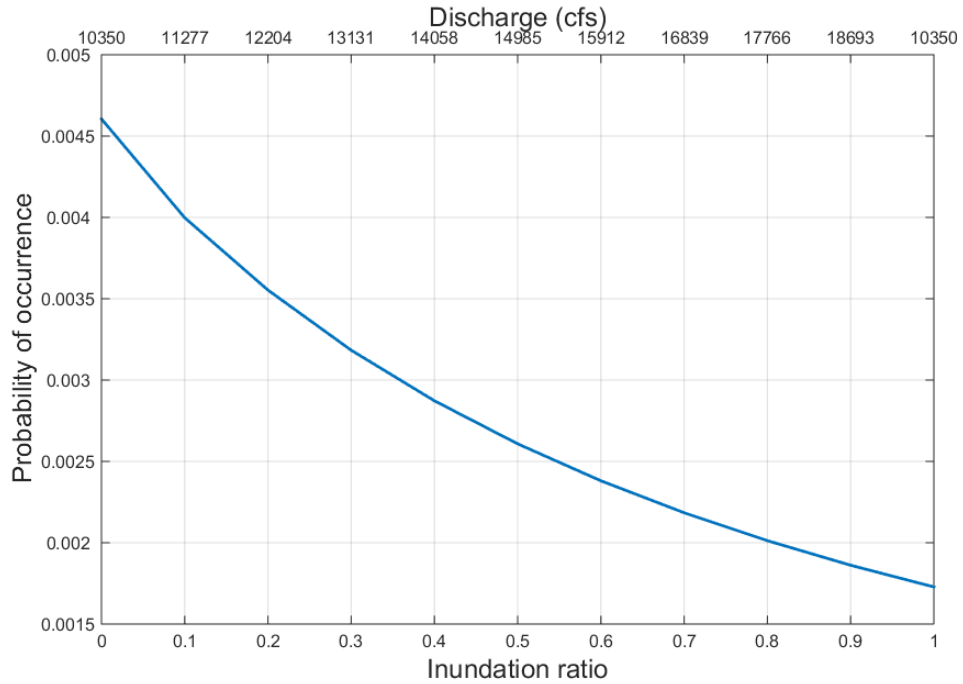


Figure 3.14 Hazard probabilities used to generate the probability of failure curve for C-15-U

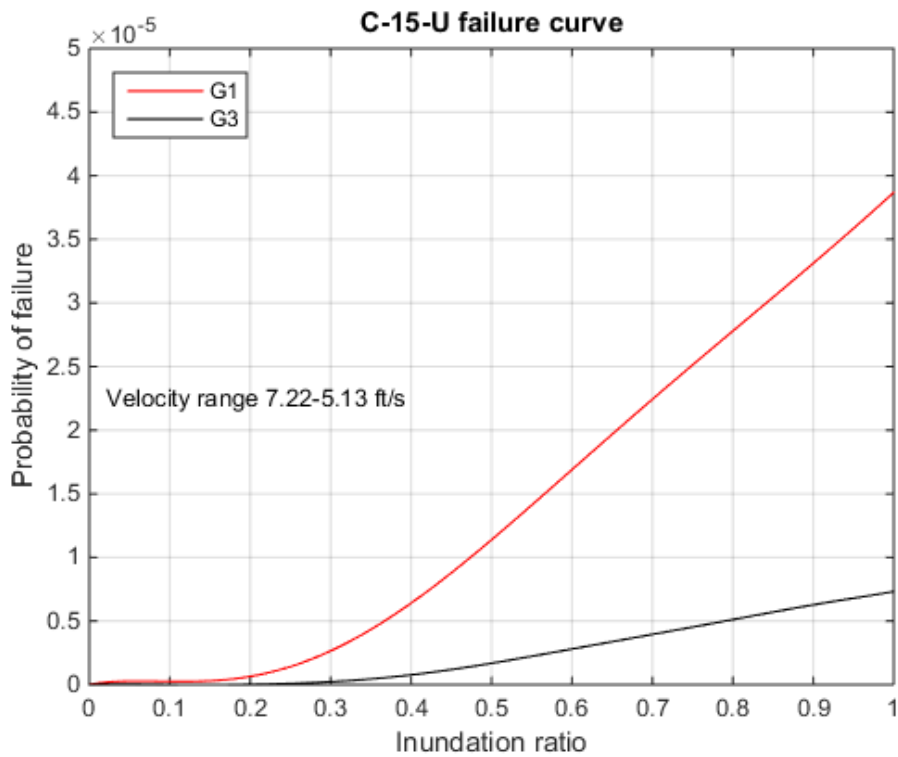


Figure 3.15 Probability of failure values for C-15-U

For this bridge, the fragility and probability of failure curve values are very small due to the high member capacity coupled with a low applied moment. The minimum nominal negative moment capacity value of 4600 kip-ft as shown in Figure 3.44 is exceeded by the applied moment felt at $h^*=1.0$. This leads to the very low failure probabilities, which can be seen on Figure 3.46 and 3.47. Not surprisingly, the beta value criterion is already met at the current bridge elevation. The beta values are 3.95 and 4.33 for the external and internal girders respectively.

3.5 Bridge C-15-Y results

C-15-Y is located at the confluence with the North Fork Big Thompson River. This bridge suffered the most damage in this study as a result of the 2013 flood. All the fill and riprap was washed out at both wing walls, the channel bottom aggraded over five feet, a portion of the approach roadway was destroyed due to structural fill being washed out and there were transverse and vertical cracks on the underside of the bridge deck. Due to the severe channel damage, the LiDAR data was adjusted to the elevations on the construction plans.

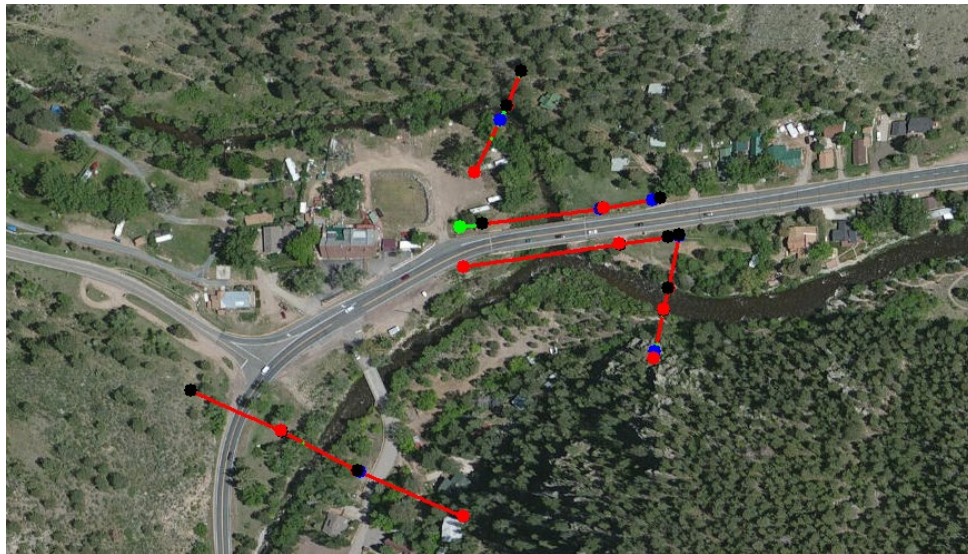


Figure 3.16 Cross sections generated in ArcMap for C-15-Y


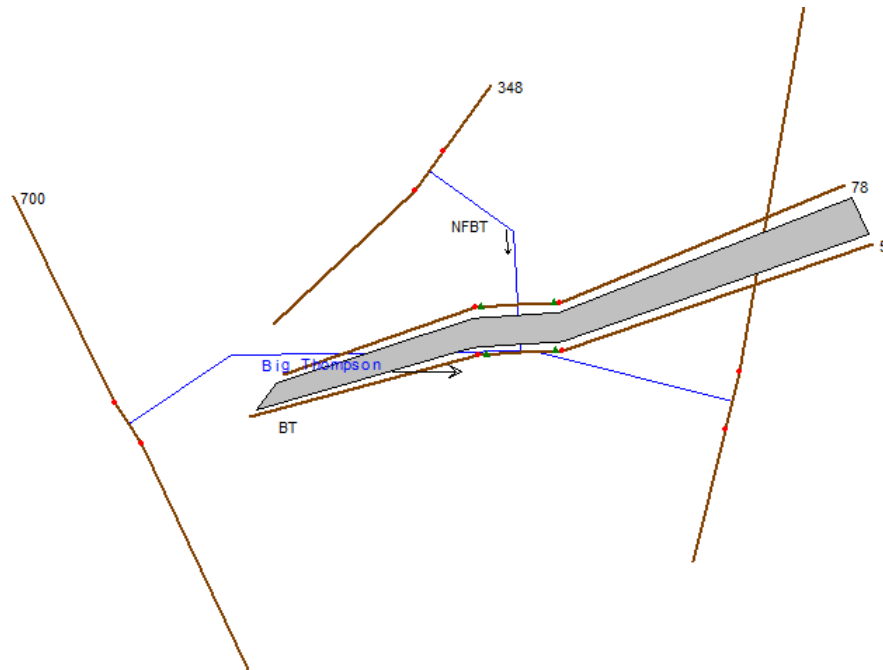


Figure 3.17 HES-RAS geometric plan view for C-15-Y

Figure 3.48 and 3.49 display the ArcMap and HEC-RAS cross sections used for C-15-Y at the mouth of the North Fork Big Thompson River. As a result of the confluence of the two rivers, an extra upstream cross section was needed for the Big Thompson River. Bridge C-15-Y is located at the center of Drake, CO. It should be noted that although the bridge section seems to overlap the Big Thompson River, the model does not treat it as such. Due to the flat and wide floodplain for this area, the bridge was extended to account for the road elevation.

The contact and overtopping discharge values for the model match well with the bridge hydraulic information sheet. For contact and overtopping discharge, the plan sheet has values of 2500 and 7500 cfs which compare well with the values of 2007 and 8736 cfs from the HEC-RAS model. For velocity, the plan has an ultimate value of 6.63 ft/s as opposed to 8.95-14.10 ft/sec on the model. However, considering the extent of damage to the bridge under the flood forces, the bridge sheet could easily have underestimated the velocity values.

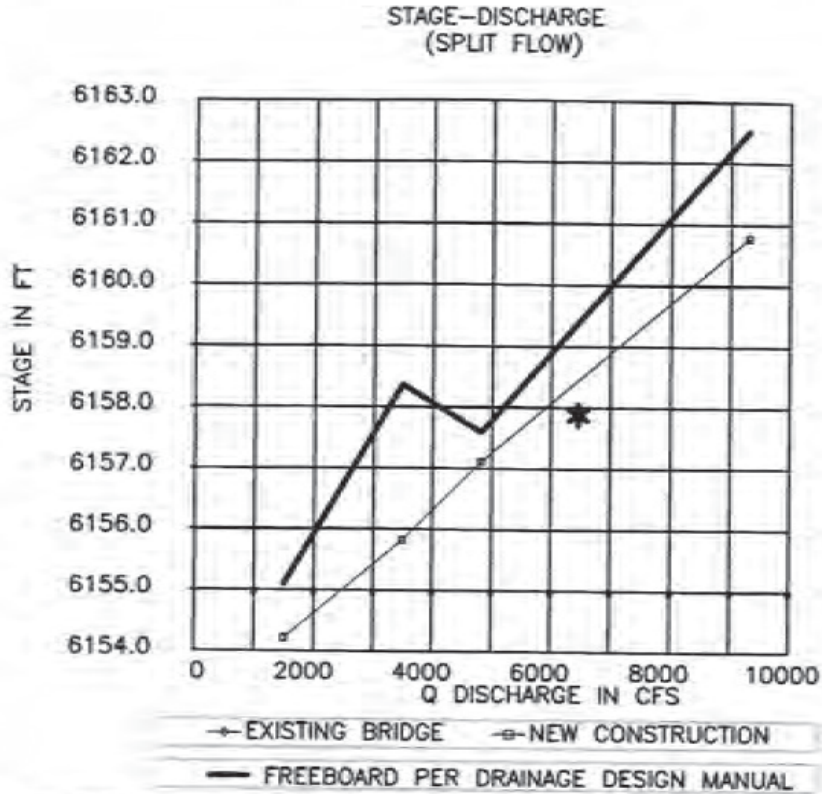

*EXISTING AND NEW CONSTRUCTION CONTAIN THE SAME STAGE-DISCHARGE VALUES.

Figure 3.50 Plan rating curve for C-15-Y (CDOT see Appendix A)

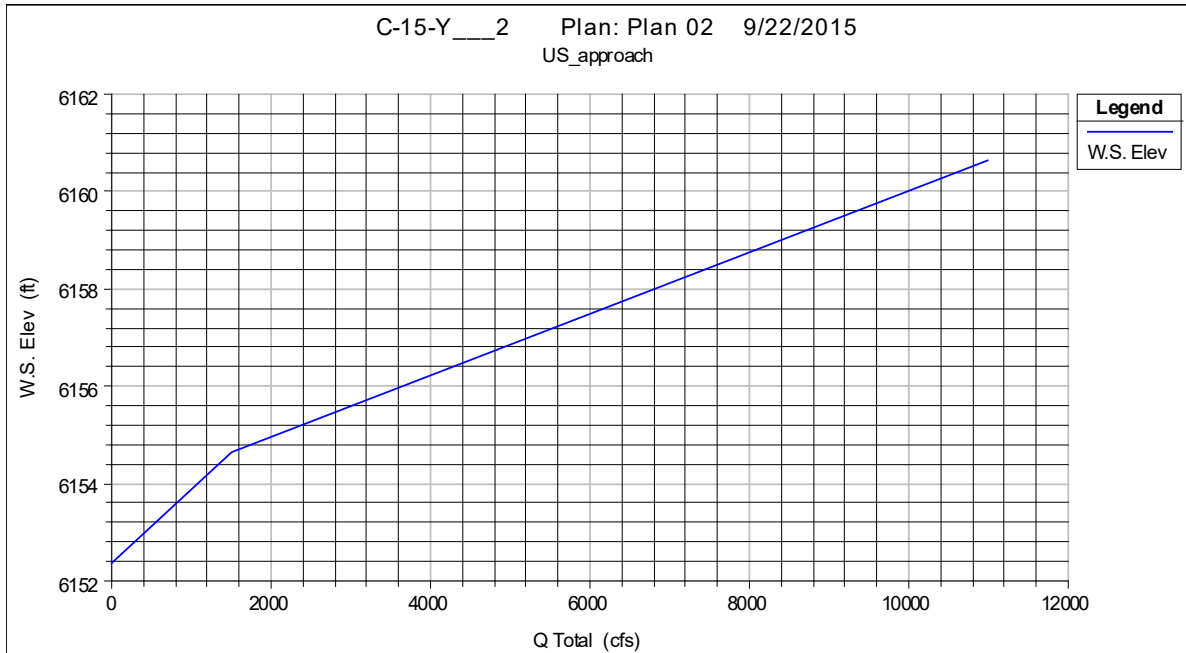


Figure 3.51 HEC-RAS rating curve for C-15-Y

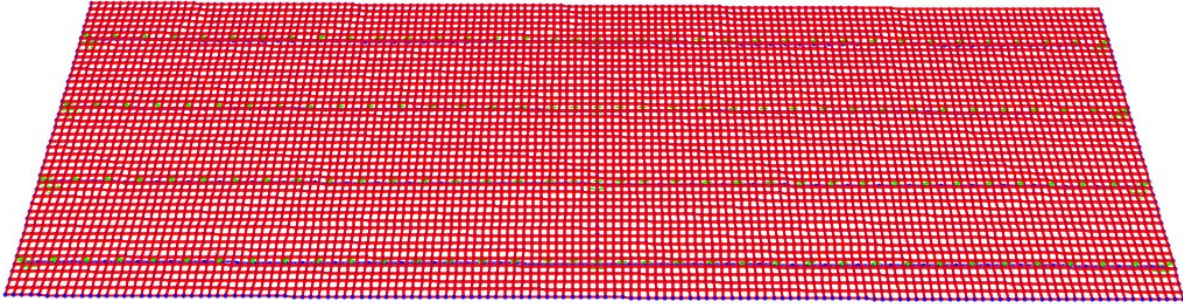


Figure 3.52 SAP2000 model for C-15-Y

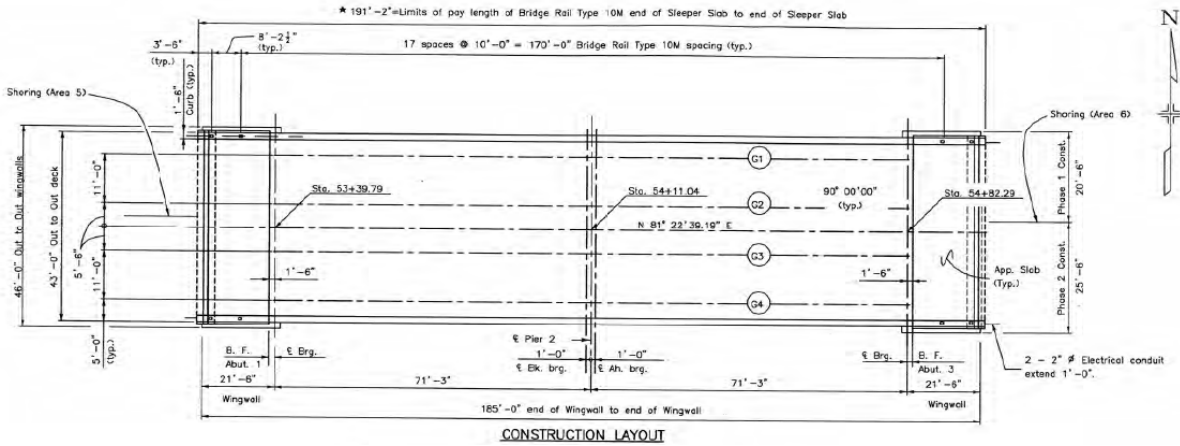


Figure 3.53 Plan view of the bridge deck of C-15-Y (CDOT see Appendix A)

C-15-Y is a rectangular four girder prestressed box girder bridge with a fixed condition at the abutments and a pin condition at the pier. Given the symmetry and lack of a skew, meshing and aligning the nodes was a straightforward task.

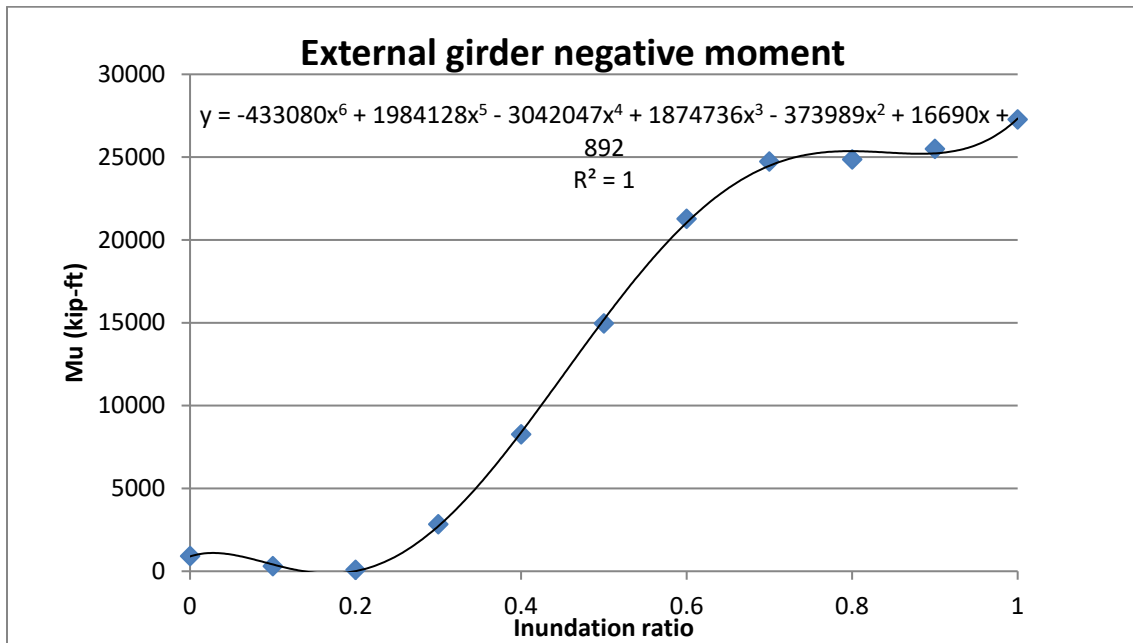


Figure 3.18 Applied negative moment felt by G1/4 for C-15-Y

The slight dip after $h^*=0$ is due to the net lift force being positive at the lower h^* values. The overall trend is expected and follows the lift coefficient shape.

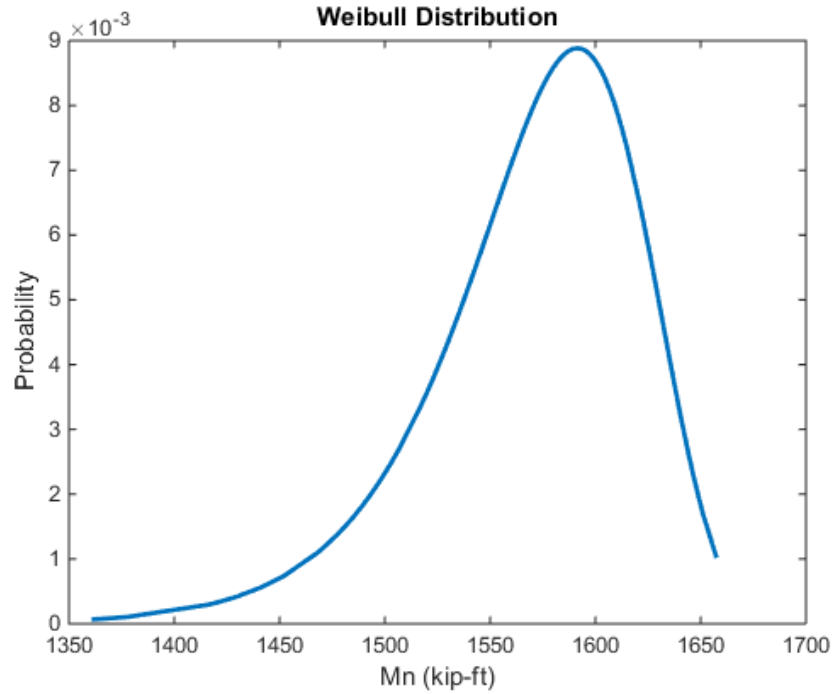


Figure 3.19 Negative nominal moment capacity for an external girder for C-15-Y

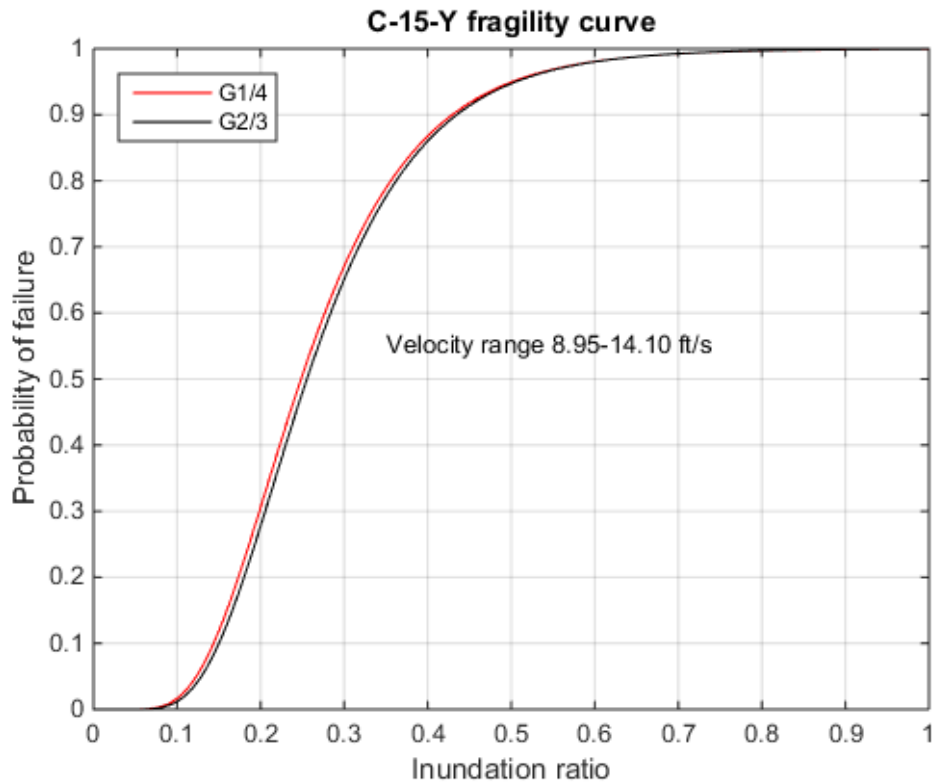


Figure 3.20 Fitted lognormal CDF function to the fragility values for C-15-Y

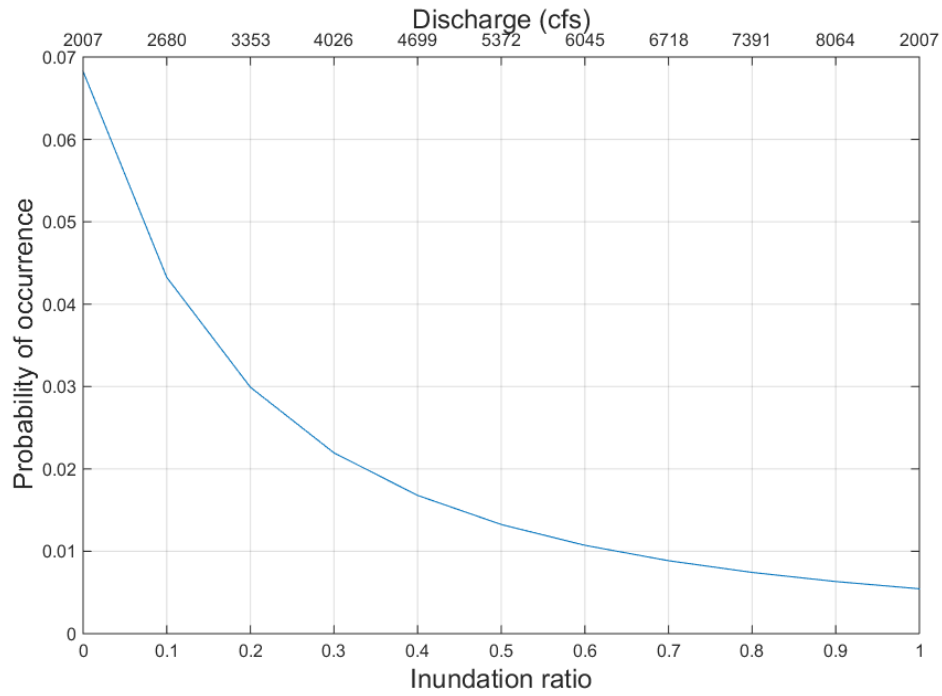


Figure 3.21 Hazard probabilities used to generate the probability of failure curve for C-15-Y

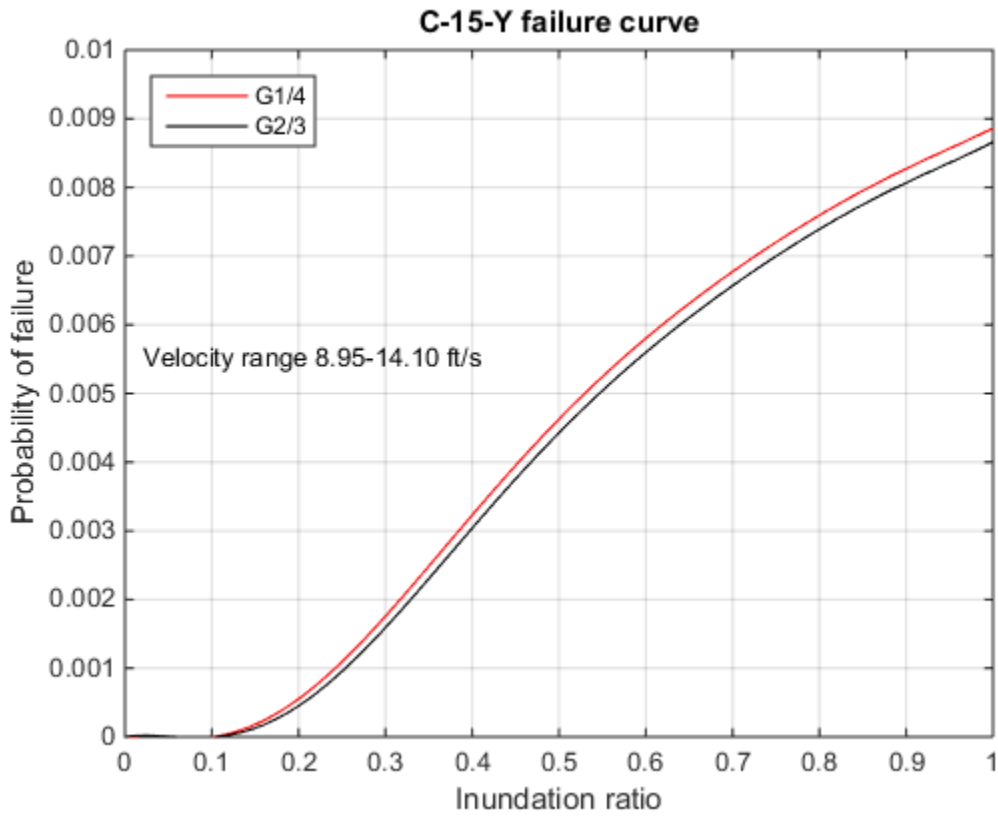


Figure 3.22 Probability of failure values for C-15-Y

The beta values for the external and internal girders are 2.37 and 2.38 respectively. To meet the target beta value for the 100 and 500-year floods, the bridge would need to be raised 2' and 6'. Another flood resiliency effort for this bridge would be to redesign the riprap to increase the protection from erosion. Erosion due to fast moving flood waters as well as debris impacts caused the majority of the damage from the September 2013 flood.

3.6 Bridge C-15-C results

C-15-C is the only steel I beam bridge in this study and was originally constructed in 1936. Major rehab was performed in 1997 to reconstruct the whole bridge. No rating curve or channel elevation was provided for this site. Also, no damage was reported due to the September 2013 flood. Based on field data, there was a 16–18' clear distance from the low chord of the girder to the channel bottom. When comparing this to the LiDAR data, no adjustments were needed and data was taken as is with some minor adjustments made to the overbank areas.

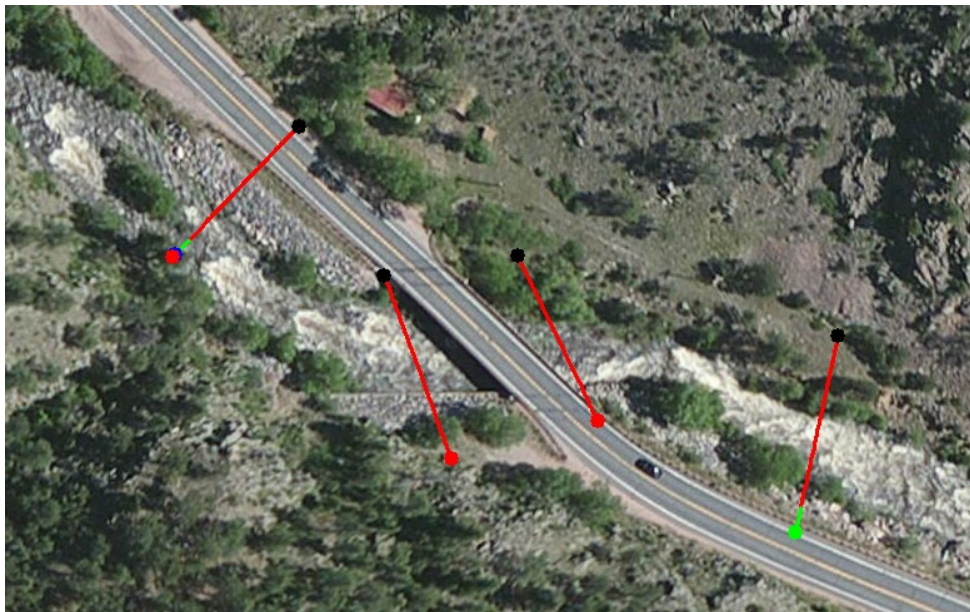


Figure 3.23 Cross sections generated in ArcMap for C-15- C

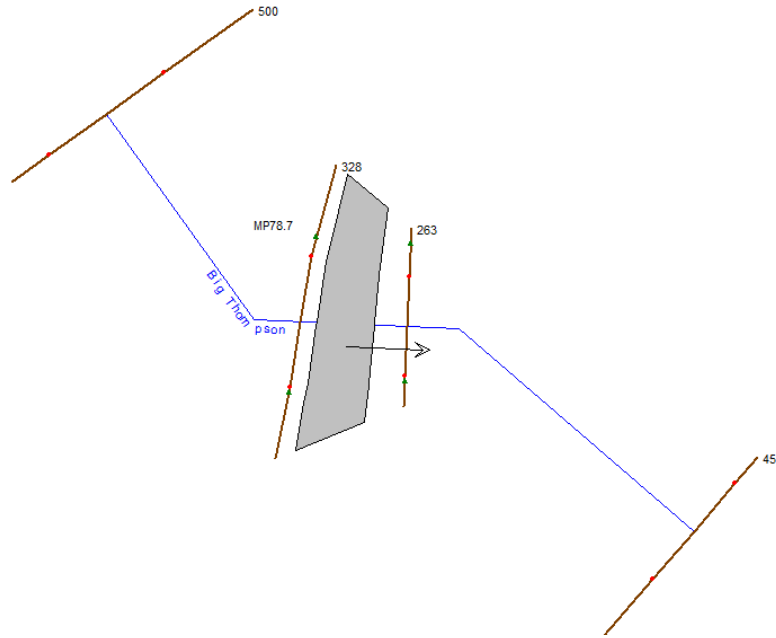


Figure 3.240 HEC-RAS geometric plan view for C-15- C

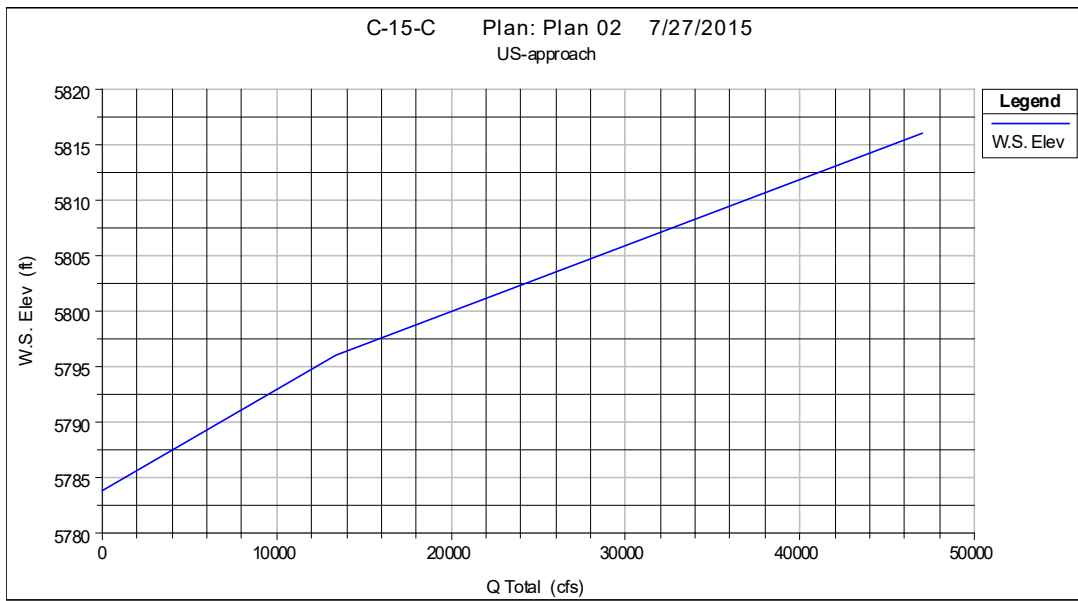


Figure 3.61 HEC-RAS rating curve for C-15- C

The best gauge of accuracy for the generated rating curve for C-15-C was to compare the contact and overtopping discharge values to the next downstream bridge C-15-AN. The contact and overtopping discharge values were 16754 and 24557 cfs, which differed by 1300 cfs for each value. A difference was expected, but the closeness of the magnitudes confirms that the values are not unreasonable. The velocity values for this bridge have a range of 14.80-15.62 ft/s.

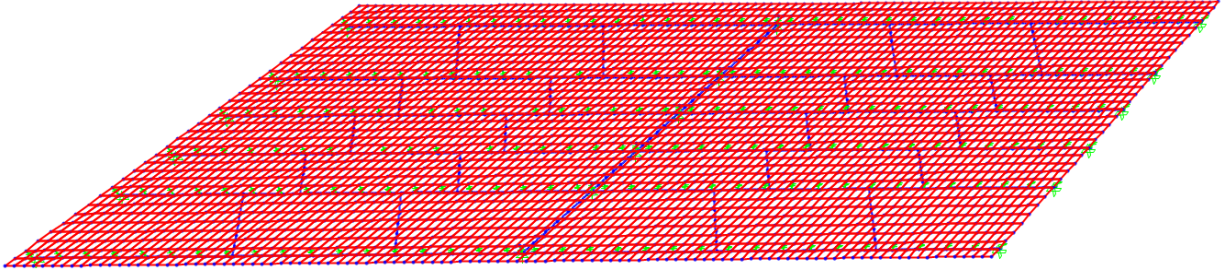


Figure 3.25 SAP2000 model for C-15- C

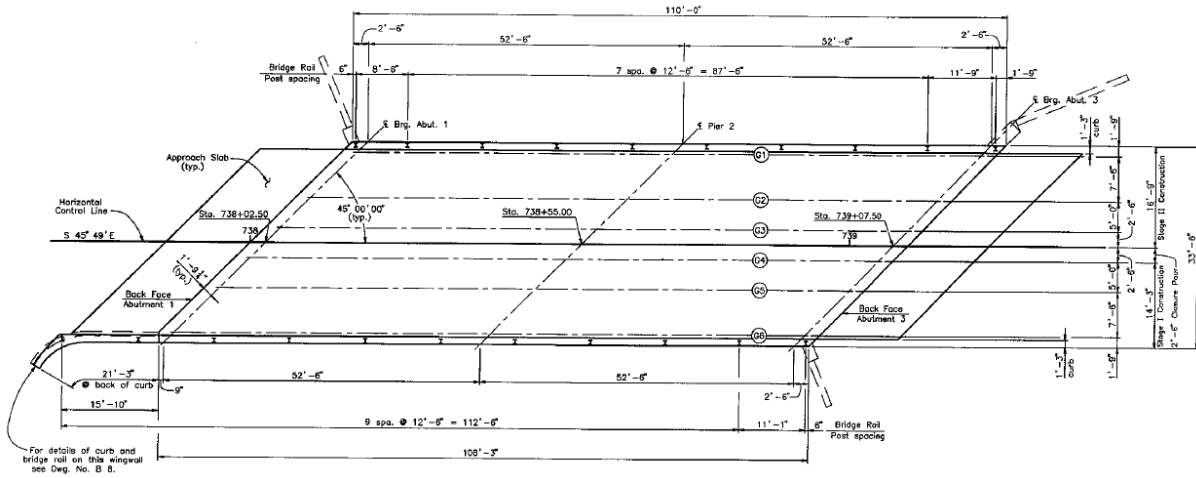


Figure 3.26 Plan view of the bridge deck of C-15- C (CDOT see Appendix A)

There is a uniform skew angle of 45°, which the SAP2000 model replicates exactly. C-15-C is a 6 girder 2 span bridge with a difference in elevation of 1.55' between abutments.

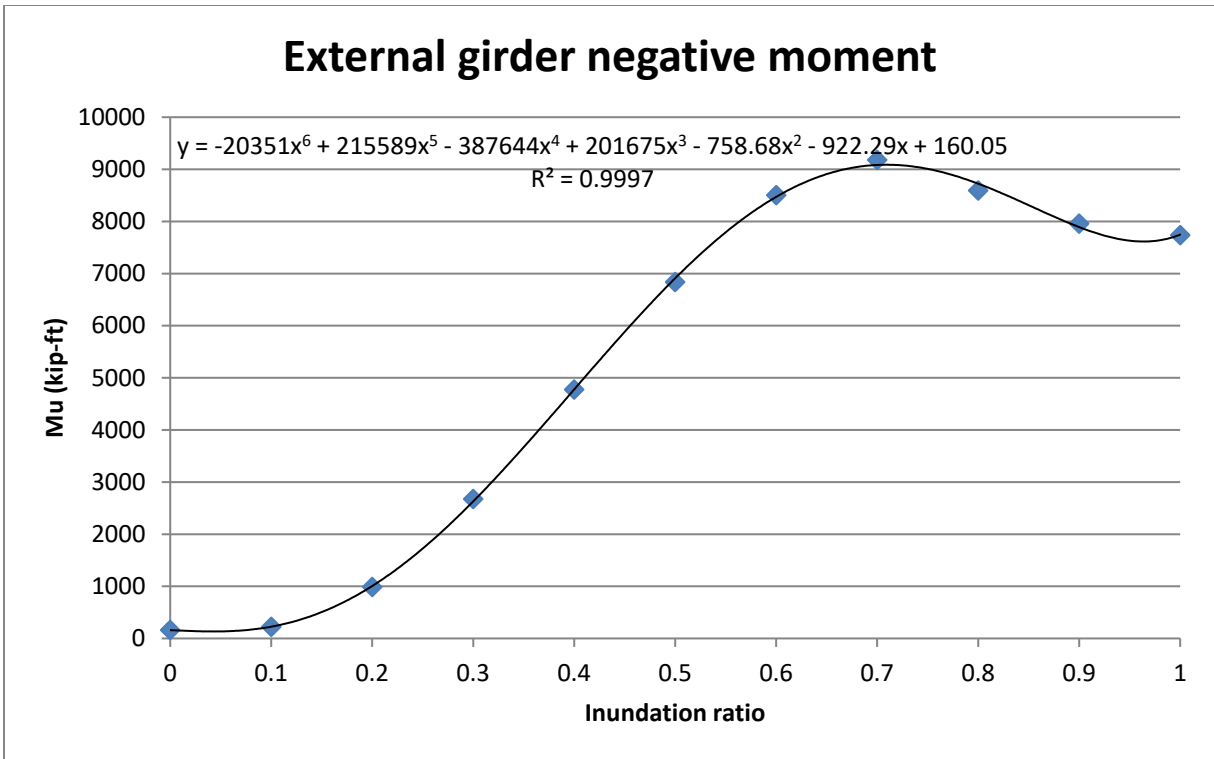


Figure 3.27 Applied negative moment felt by G6 for C-15- C

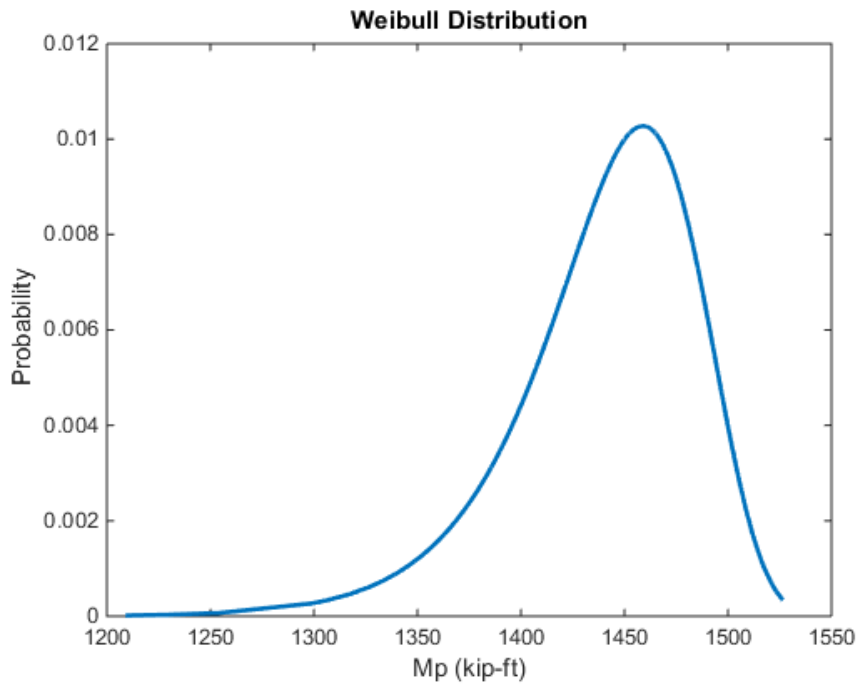


Figure 3.28 Negative nominal moment capacity for an external girder for C-15- C

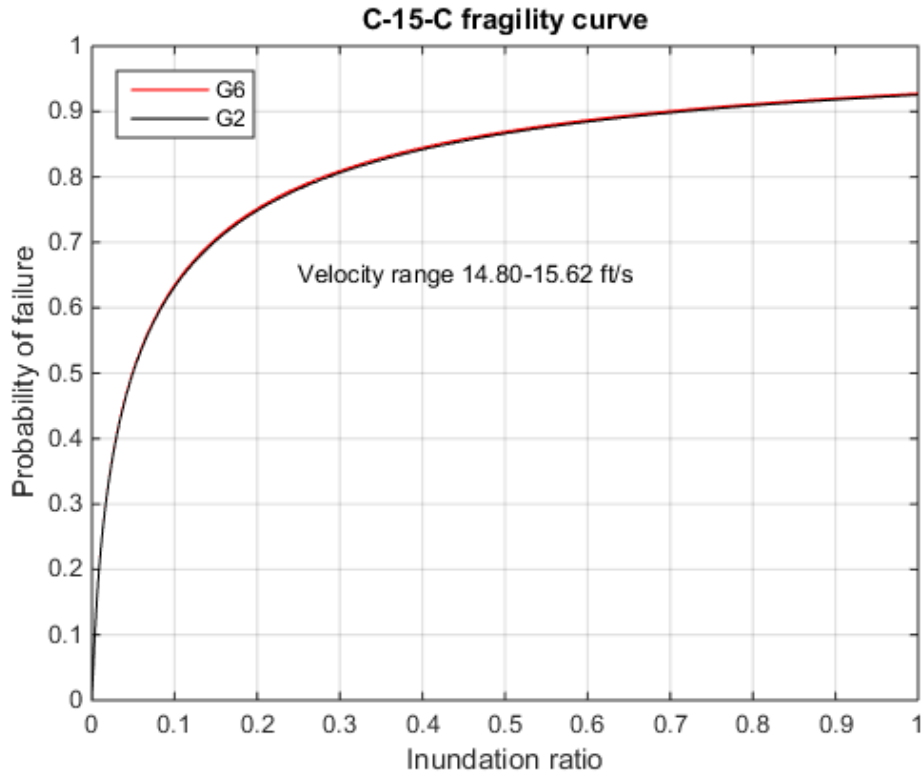


Figure 3.29 Fitted lognormal CDF function to the fragility values for C-15- C

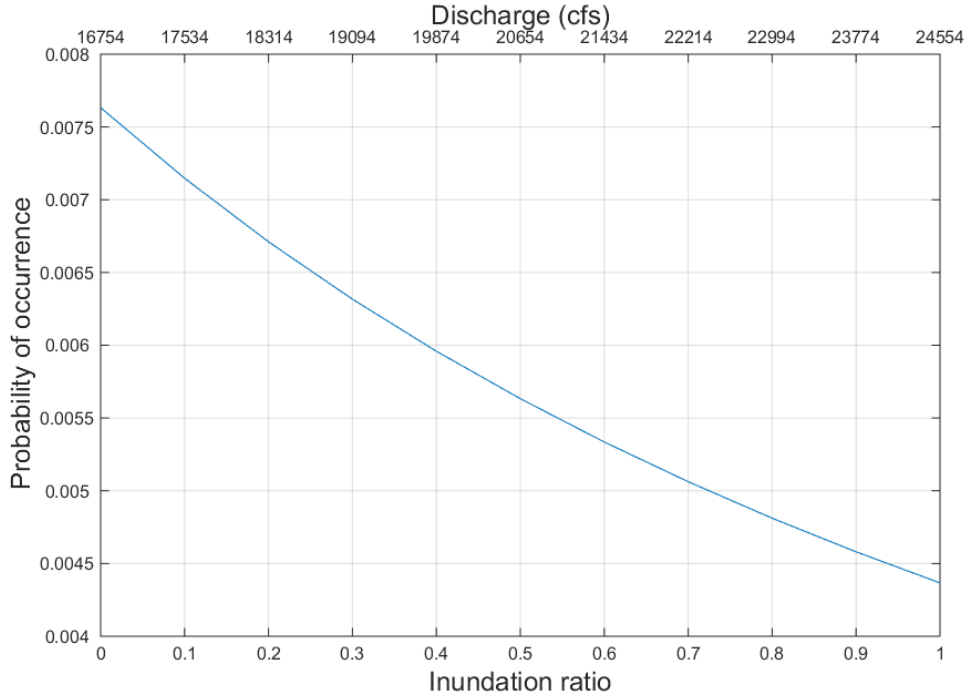


Figure 3.30 Hazard probabilities used to generate the probability of failure curve for C-15- C

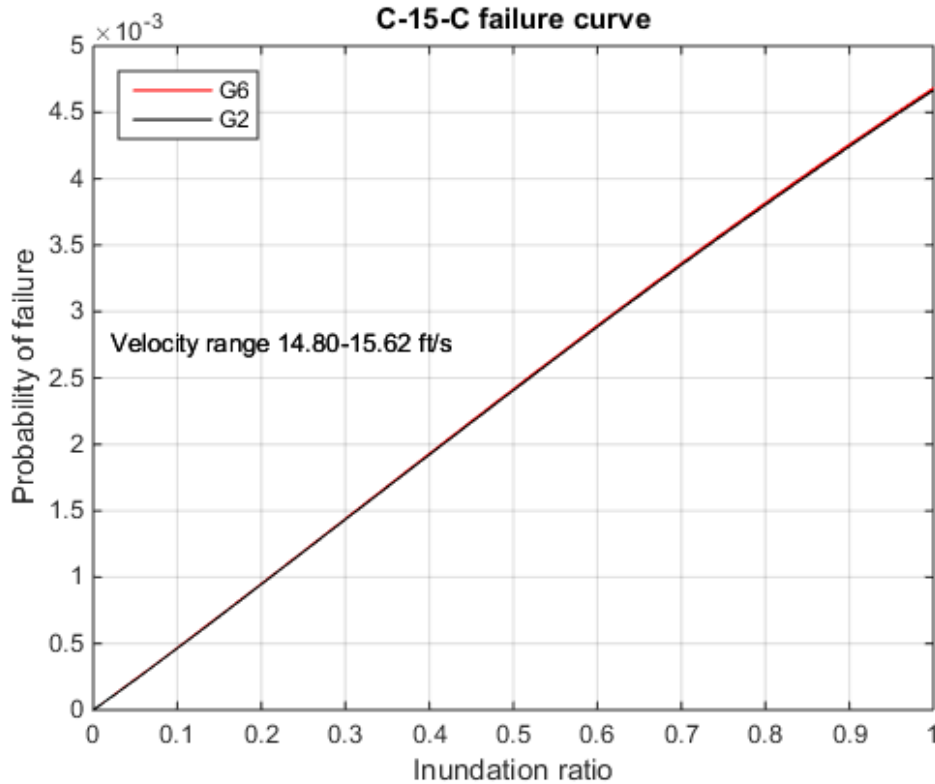


Figure 3.31 Probability of failure values for C-15- C

The beta values for the exterior and interior girder are 2.60. To reach the target beta value for the 100 and 500-year flood, the bridge would need to be raised 0' and 7.5'. The 100-year storm doesn't come in contact with the superstructure hence the lack of adjustments needed. For the 500-year flood, the bridge needs to be raised such that no contact is made with the superstructure due to the low capacity of the girders and the high demand as a result of the lift force.

3.7 Bridge C-15-AN results

C-15-AN is a prestressed box girder 3 span bridge located 2.42 miles downstream of C-15-C. No damage was suffered due to the September flood at this site. Comparing the field measurements to the plan elevations resulted in about one foot of degradation in the center of the channel. The LiDAR data was adjusted to match the plan elevations because of post flood repairs by CDOT. The channel overbank areas consist of a steep hill on the left bank and a large open area on the right bank with a gradual slope.



Figure 3.32 Cross sections generated in ArcMap for C-15- AN

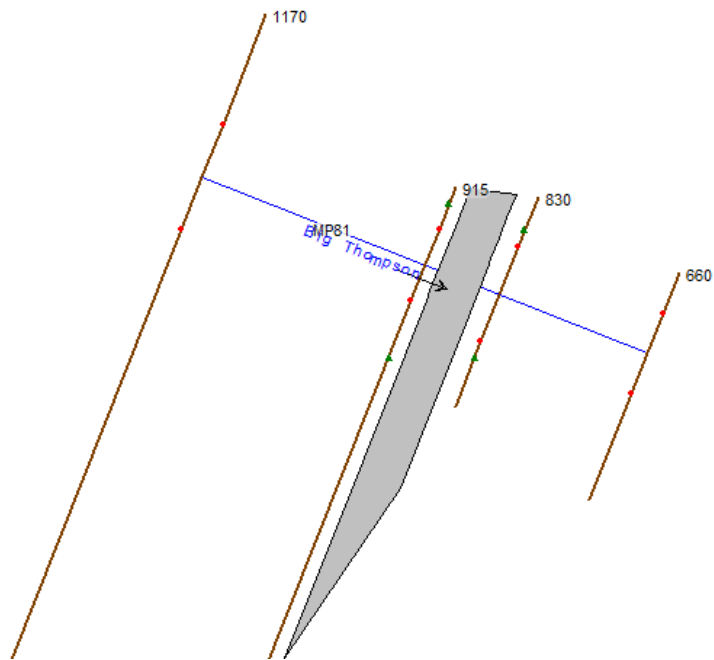


Figure 3.70 HEC-RAS geometric plan view for C-15- AN

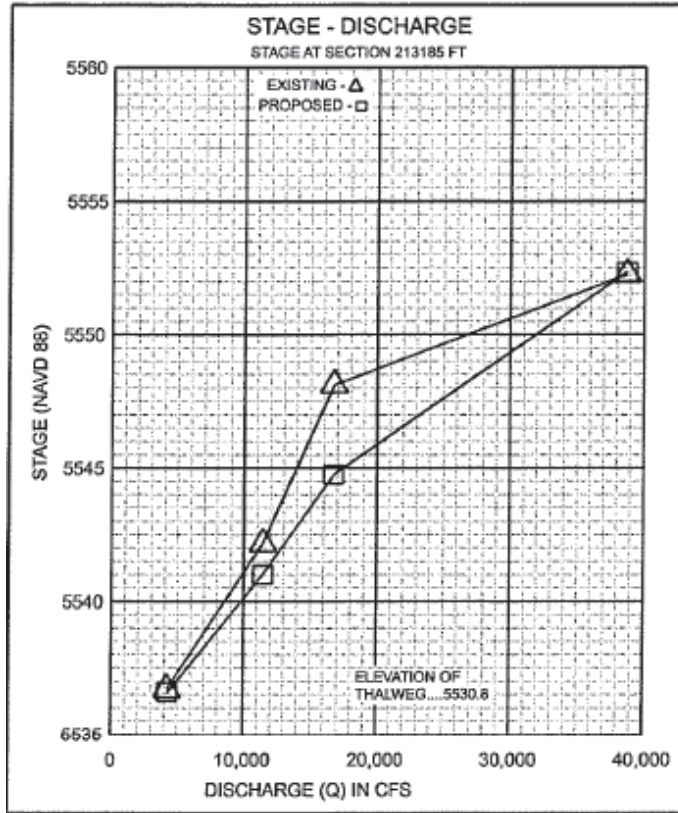


Figure 3.331 Plan rating curve for C-15- AN (CDOT see Appendix A)

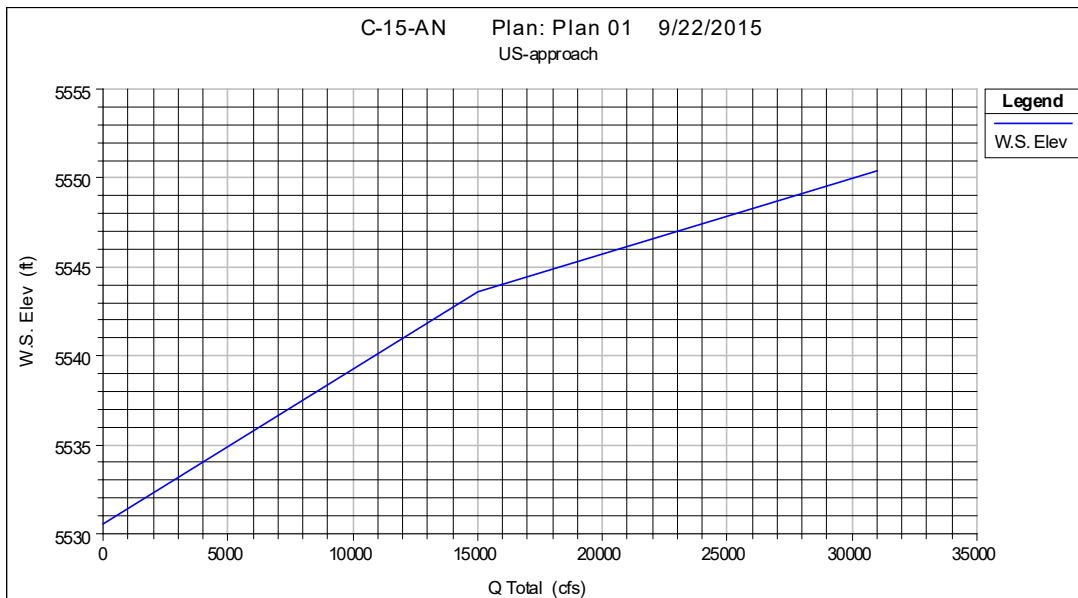


Figure 3.72 HEC-RAS rating curve for C-15- AN

The contact and overtopping discharge values from the plans' curve are 15500 and 23000 cfs, which compare well with the models' values of 15446 and 23258 cfs. The main difference lies with the velocity values. For this bridge, the HEC-RAS models' values are much lower than the plans. The ultimate velocity is 14.26 ft/s as opposed to the range of 7.26-6.83 ft/s from the model. The velocity and discharge values generated in HEC-RAS were used to be consistent.

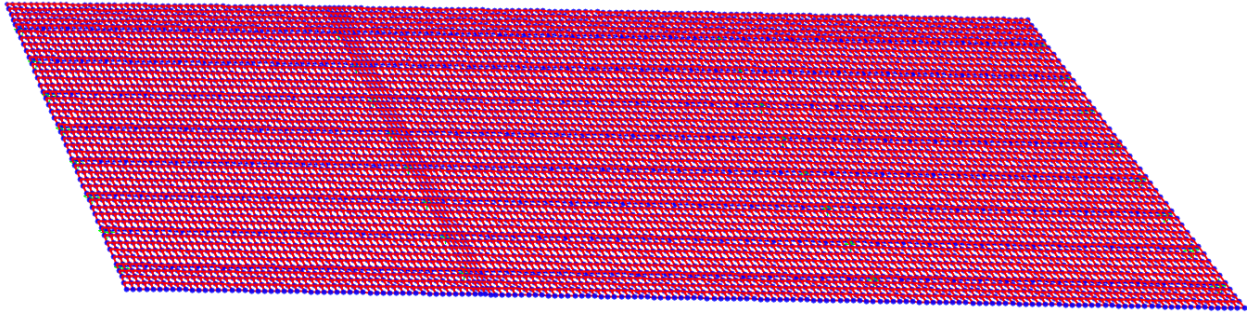


Figure 3.73 SAP2000 model for C-15- AN

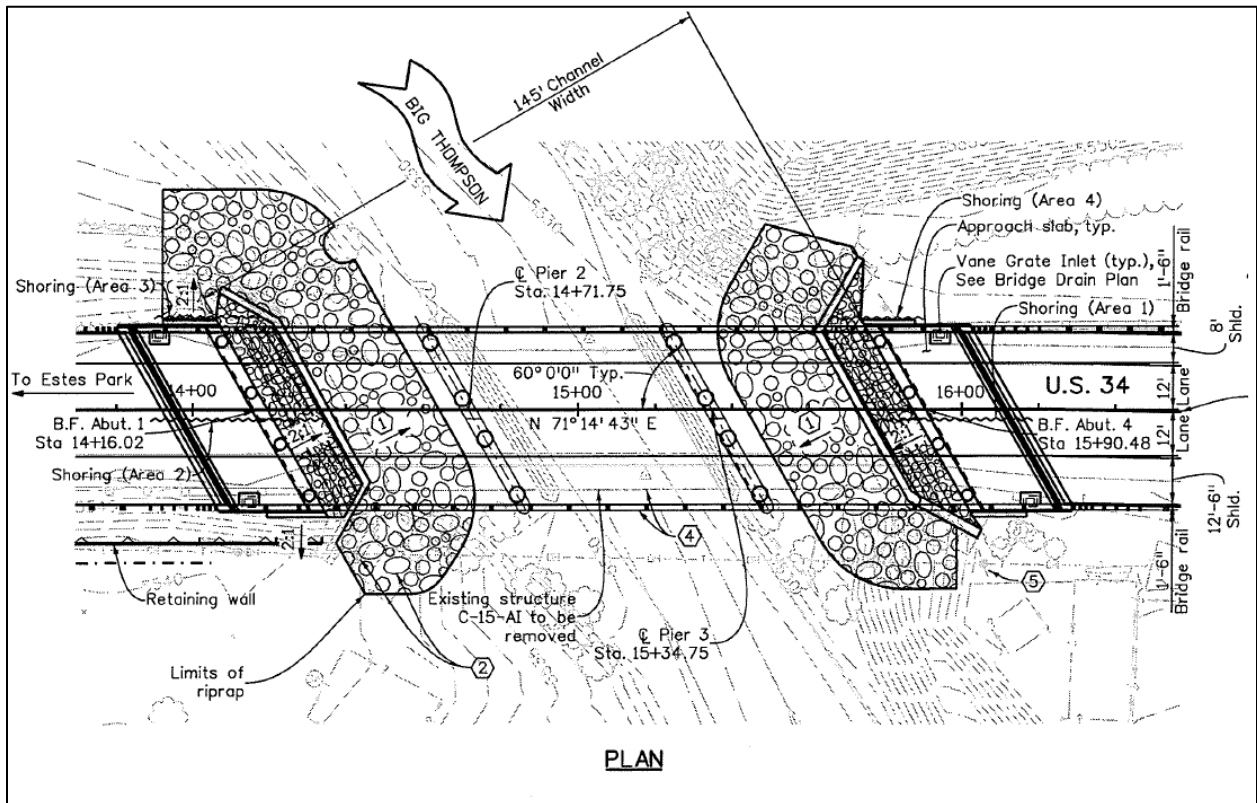


Figure 3.34 Plan view of the bridge deck of C-15- AN (CDOT see Appendix A)

The model skew is 60.02° and the real bridge has a skew angle of 60° . Also, the differential elevation occurs at the piers, which are 0.44' greater than the abutments.

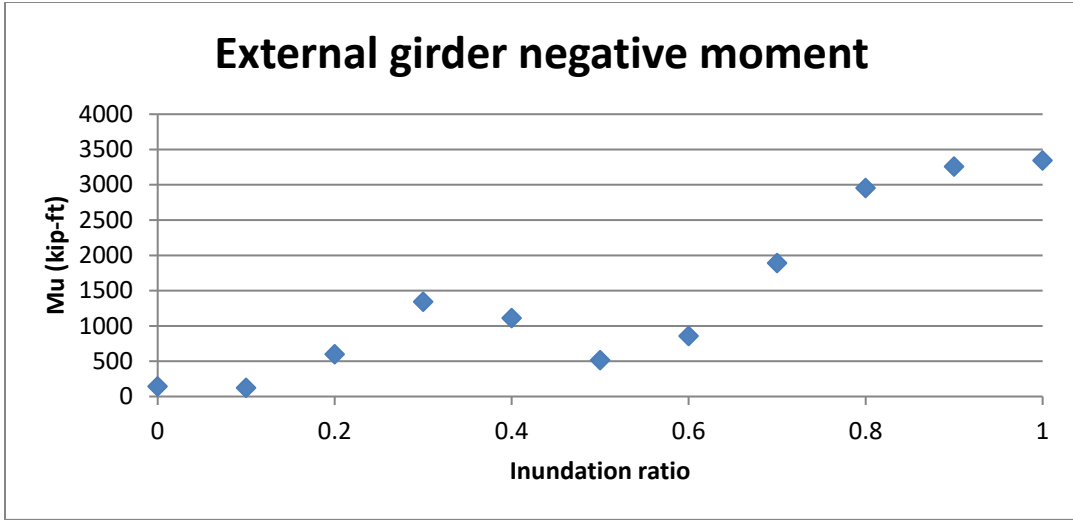


Figure 3.35 Applied negative moment felt by G1 for C-15- AN

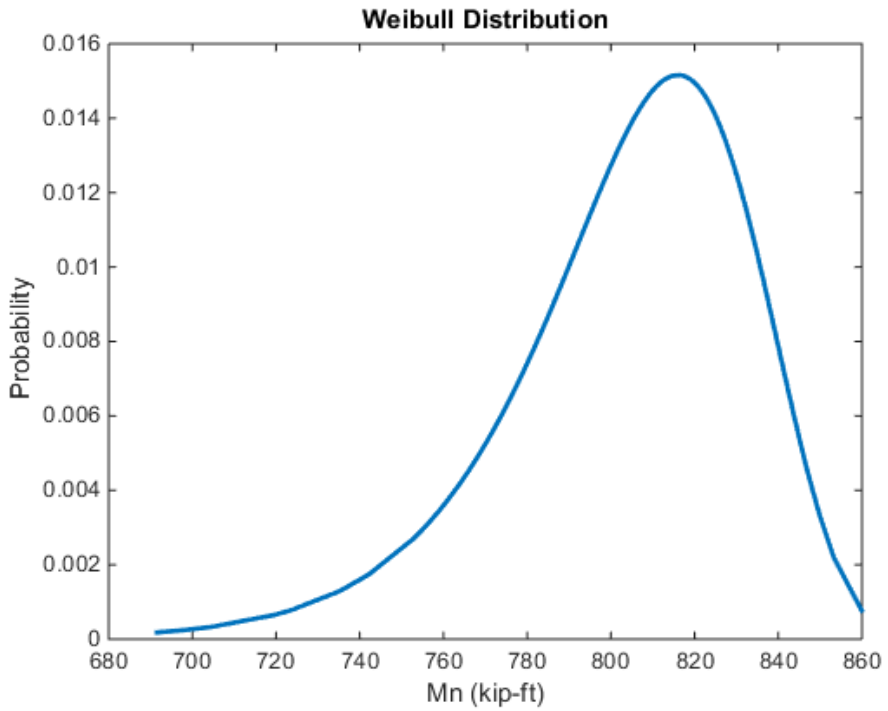


Figure 3.36 Negative nominal moment capacity for an external girder for C-15- AN

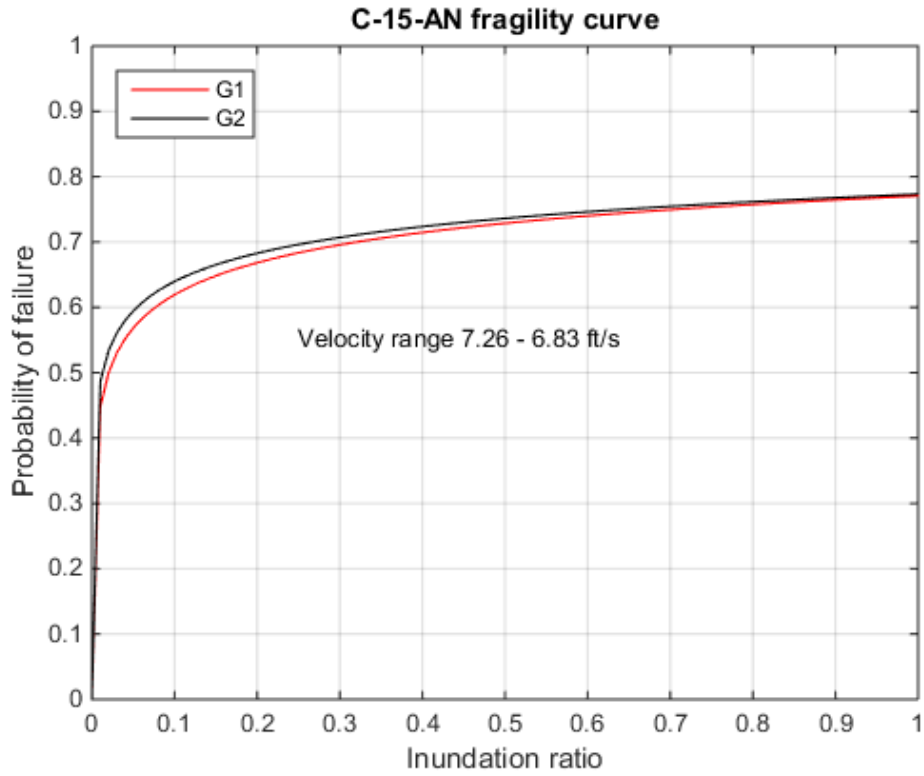


Figure 3.37 Fitted lognormal CDF function to the fragility values for C-15- AN

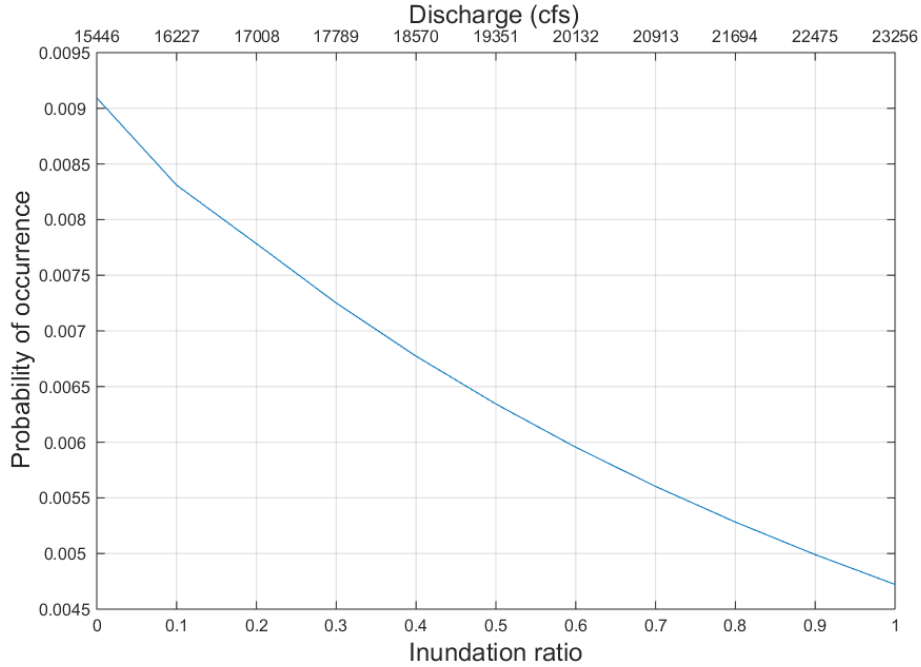


Figure 3.38 Hazard probabilities used to generate the probability of failure curve for C-15- AN

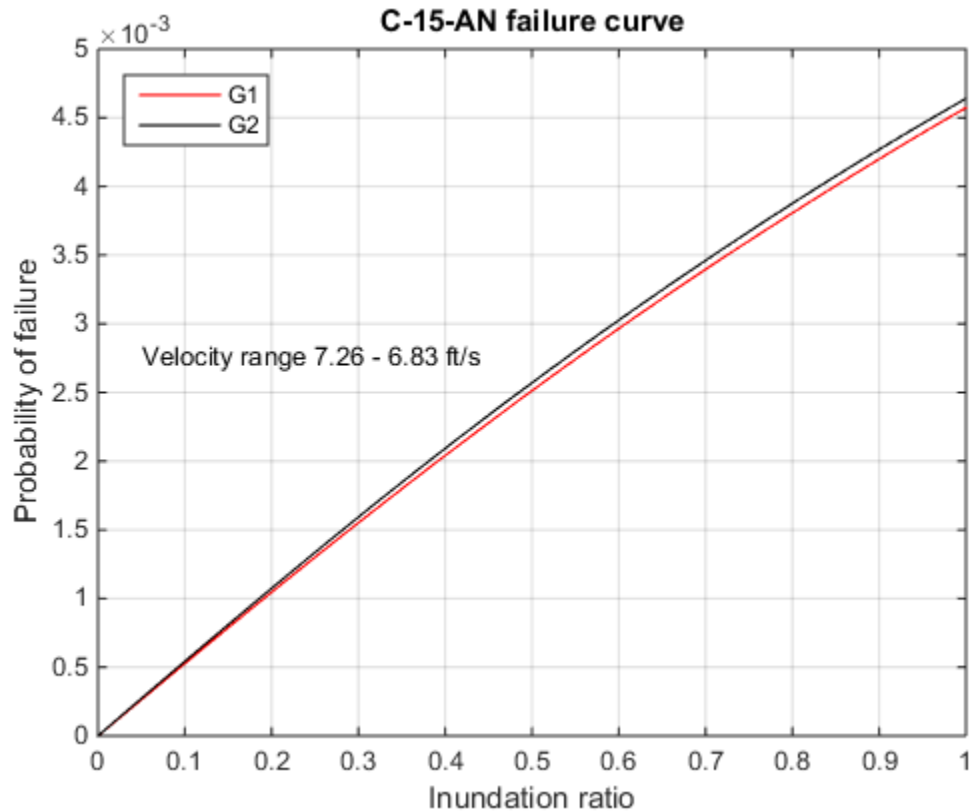


Figure 3.39 Probability of failure values for C-15- AN

The low capacity and variability in the inundation ratio results in a jump of the fragility curve at $h^*=0$ to $h^*=0.1$. The beta values are 2.61 and 2.60 for the external and internal girders. To reach the target beta value for the 100 and 500-year flood, the bridge would need to be raised 0' and 7'. The 100-year storm doesn't come in contact with the superstructure hence the lack of adjustments needed.

3.8 Bridge C-16-DI Results

C-16-DI is located a mile upstream from the mouth of the canyon and is the only bridge in the study to be modeled as supercritical flow. This is due to the nature of the overbank areas, which are vertical rock cliffs and corrugated metal retaining walls. Velocity values are the greatest at this location which leads to very high forces. Due to the large clearance distance of 18-22', the probability of being inundated is small. Field measurements determined that there was 3-5' of degradation to the channel bottom so the LiDAR data was adjusted to match the plan elevations. Damage done was limited to asphalt cracking and slight settlement at the roadway-bridge interface. Also, there was a mild erosion hole at the back right wingwall.

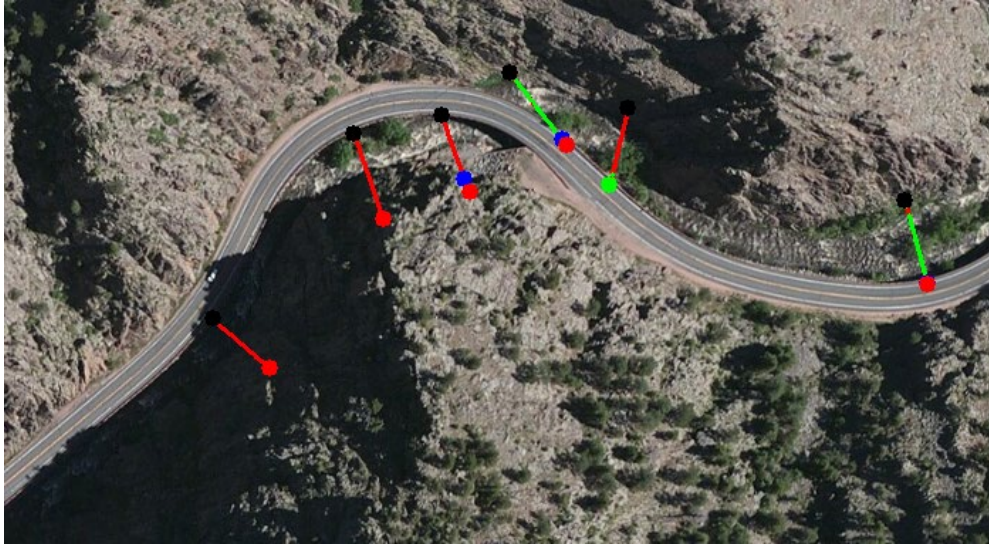


Figure 3.80 Cross sections generated in ArcMap for C-16-DI

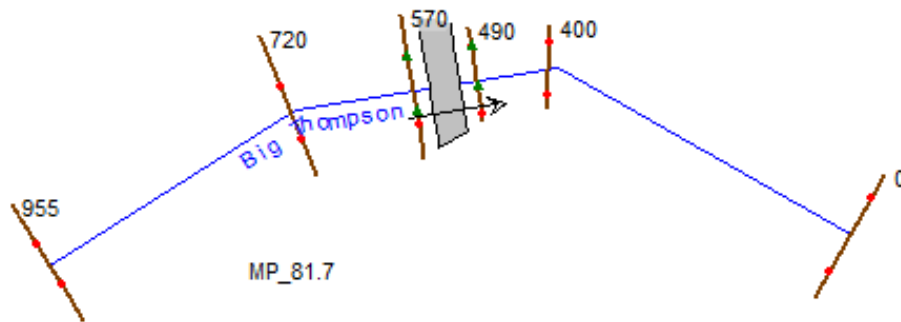


Figure 3.81 HEC-RAS rating curve for C-16-DI

The degree of meandering plus the fast moving flow required two additional cross sections for the HEC-RAS model.

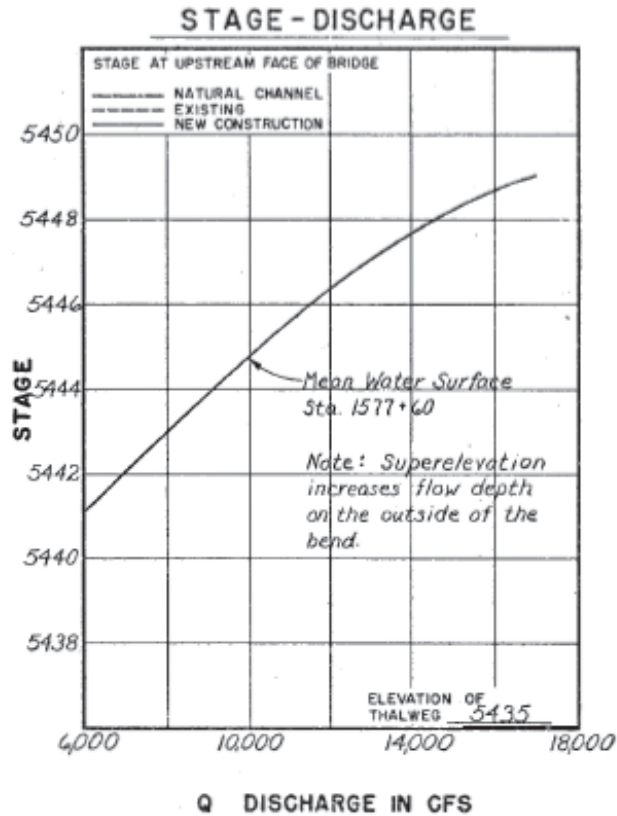


Figure 3.402 Plan rating curve for C-16-DI (CDOT see Appendix A)

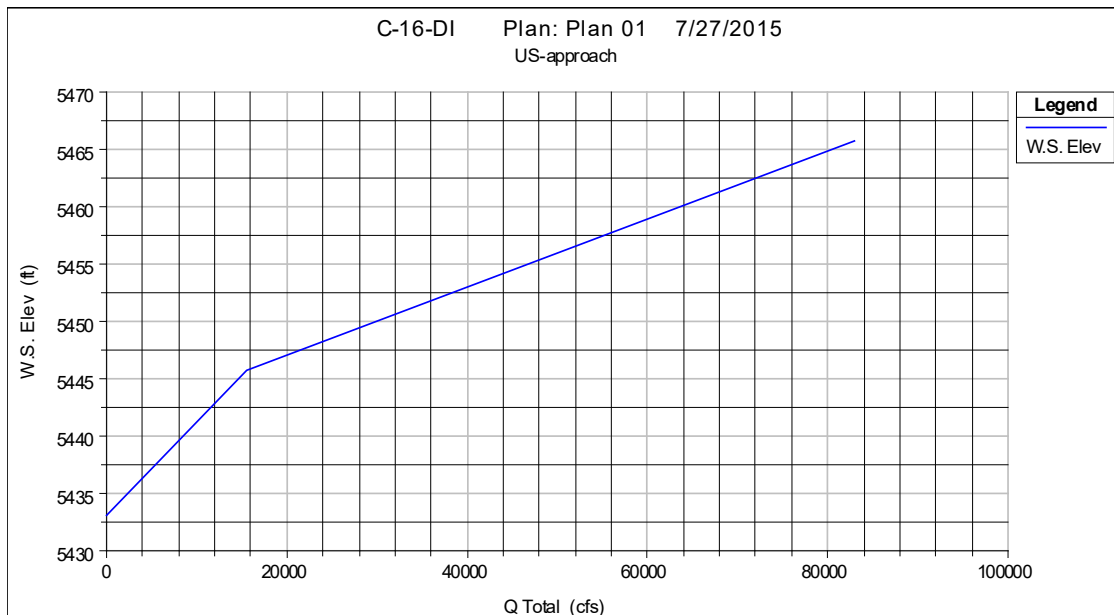


Figure 3.83 HEC-RAS rating curve for C-16-DI

The plan rating curve does not include a contact or overtopping discharge value, but there is a velocity value provided. Due to the supercritical nature of the channel, the velocity values are the highest at this location when compared to the previous bridges in this study. The plan sheet gives a velocity value of 25

ft/s, which corresponds to much lower discharge values. Velocity values range from 30.92-36.31 ft/s at discharge values of 46539 to 63639 cfs for the HEC-RAS model.

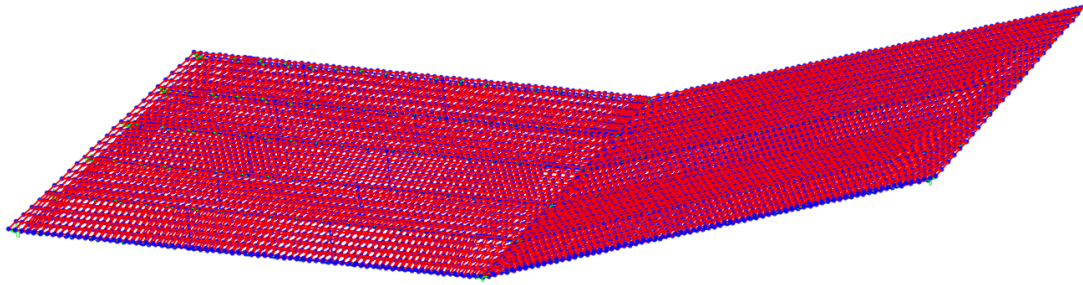


Figure 3.41 SAP2000 model for C-16-DI

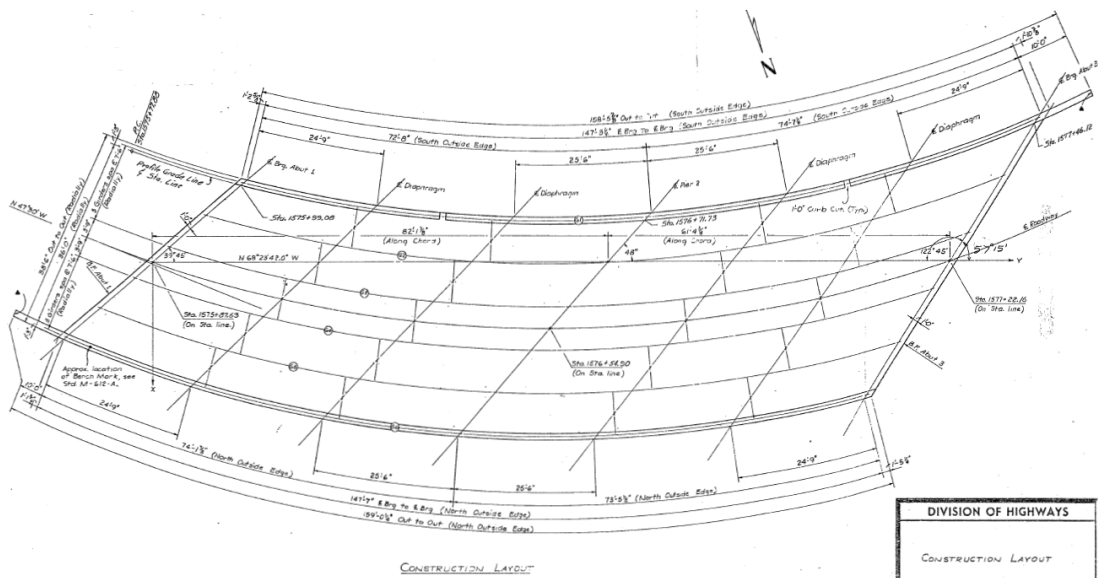


Figure 3.42 Plan view of the bridge deck of C-16-DI (CDOT see Appendix A)

The structural configuration of this bridge was unique and handled slightly differently than previous bridges. Instead of a single element for the box girders, it was modeled as shell elements for the top and bottom slab plus rectangular frame elements for the columns. This is felt to align better with the staged construction for this project. The bottom slab and girder web columns were poured first and then the top slab was poured. This differs from other box girder bridges because the deck is part of the box girder as opposed to the box girder top flange being compositely connected via shear studs to the bridge deck slab. The concrete web girders were modeled as straight frames and the curvature was not taken into account. For this bridge, the concrete strength was very low, 1600 psi, which led to a low capacity. Coupling the low capacity with the high demand led to the less robust approach, straight elements, for this bridge.

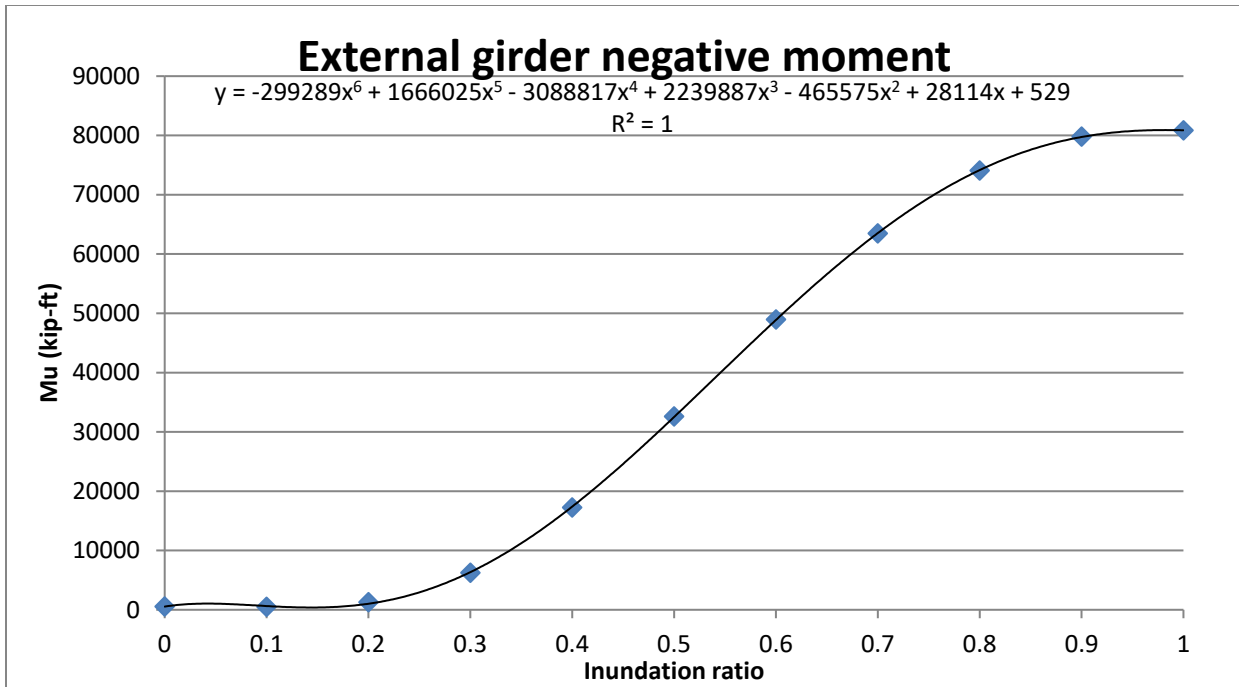


Figure 3.43 Applied negative moment felt by G6 span 2 for C-16-DI

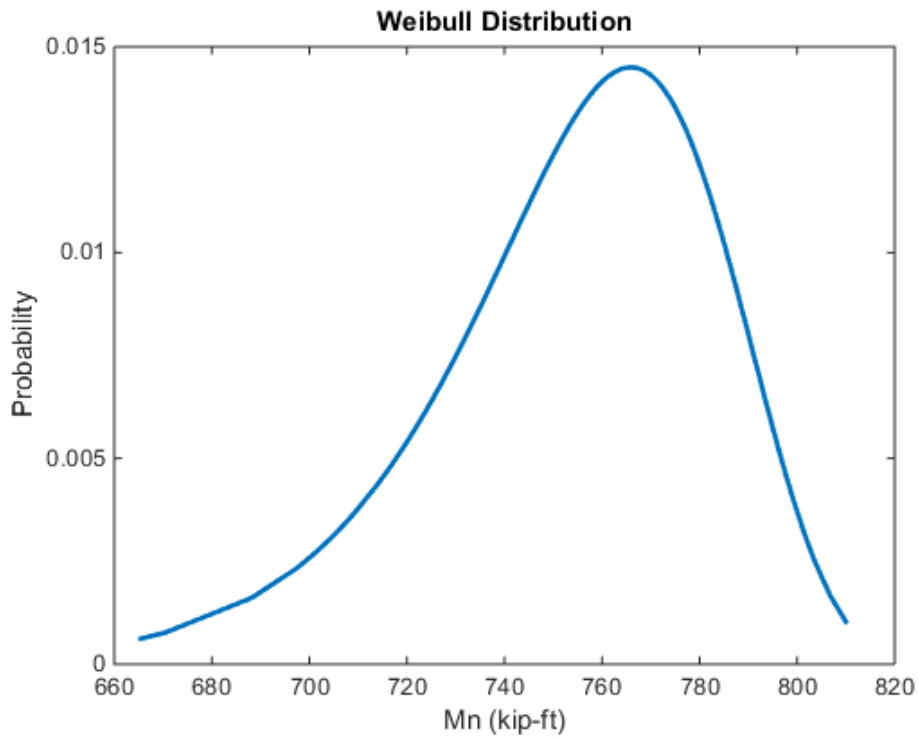


Figure 3.44 Negative nominal moment capacity for an external girder for C-16-DI

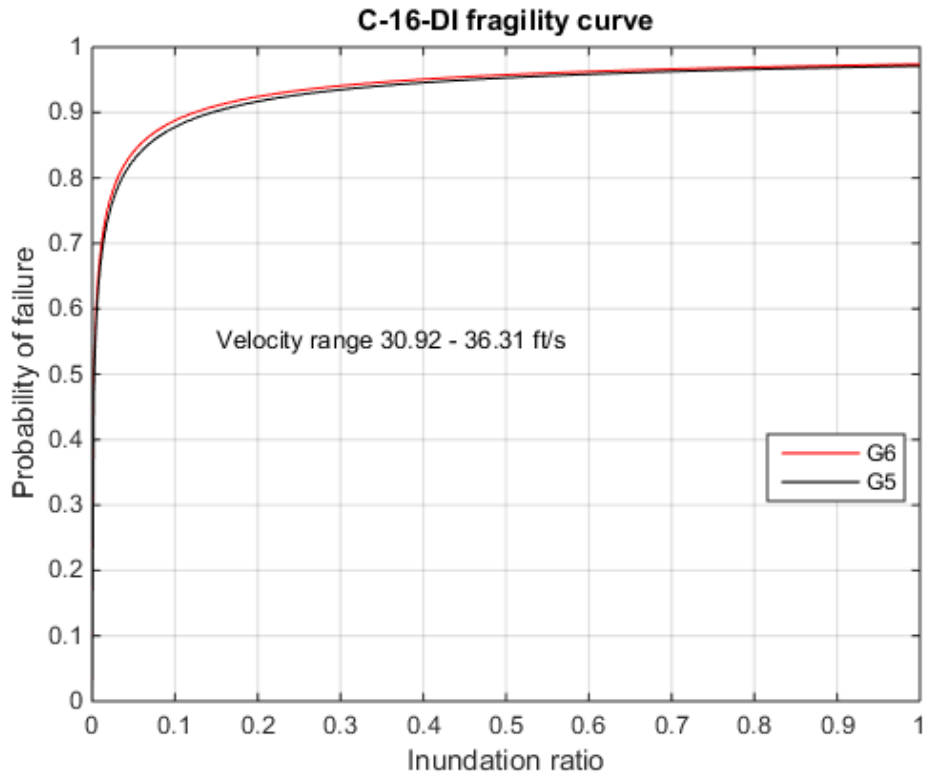


Figure 3.45 Fitted lognormal CDF function to the fragility values for C-16-DI

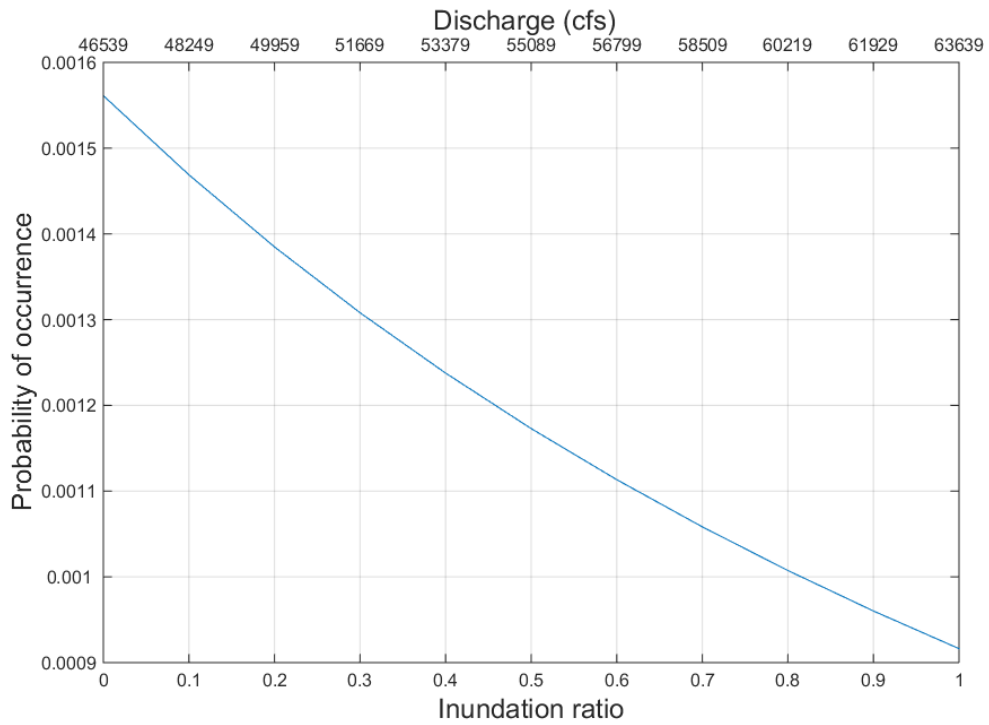


Figure 3.46 Hazard probabilities used to generate the probability of failure curve for C-16-DI

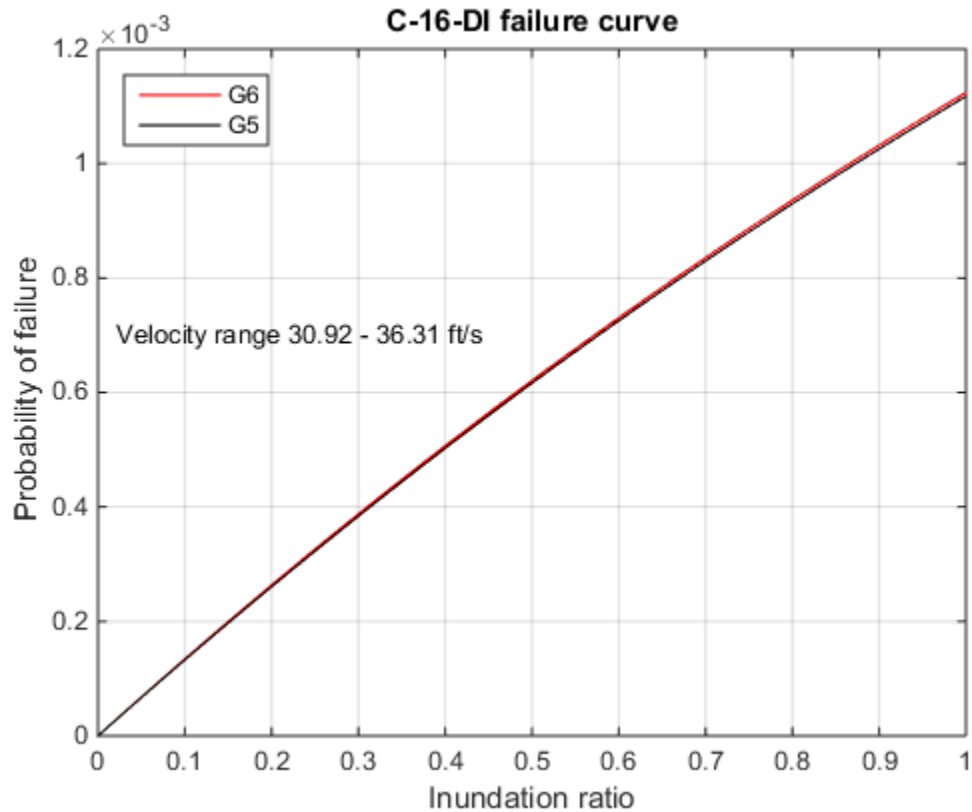


Figure 3.90 Probability of failure values for C-16-DI

For variation in the demand, 20% of the predicted discharge value was used, as discussed in the previous chapter, and the standard deviation ranges from 9300 to 12700 cfs. Such a large range in the discharge, or the demand, leads to several high inundation ratios at every point. When a distribution is fit to the resulting Mu values, it leads to very high fragility probabilities at even low inundation ratios as seen in Figure 3.90. The current beta values are 3.06 for the external and internal girders. However, due to the large clearance distance, no adjustments are needed to reach the target beta value for the 100 and 500 year storm due to no contact being made with the superstructure.

4. CONCLUSIONS, CONTRIBUTIONS AND RECOMMENDATIONS

The community of Drake, CO, was the focal point of this research. Eight bridges were selected and analyzed under flood loading as per the design equations proposed by Kerenyi et al. (2009). Fragilities were developed for the most critical internal and external composite girders. The results obtained from fragility analysis were then used to determine the elevation adjustments needed to reach a target beta value of 3.5. These adjustments would reduce post-flood repair cost, increase bridge safety during a low probability storm event, and increase the flood resiliency of the Big Thompson Canyon.

Currently, bridge superstructures are designed based on the 100-year flood, which in the case of the bridges in this study, would not have resulted in any inundation of the bridge deck at the time of construction based on the knowledge at that time. In fact, there is a required amount of freeboard, or clearance distance between the water surface and the low chord of the girder, for bridges to allow for wave surges and debris to pass under the bridge. This methodology results in bridge superstructures not properly being analyzed for flood forces due to inundation, more specifically the lift force that has proven to be significant in this study. The negative lift force is especially significant for fast moving rivers such as the Big Thompson River.

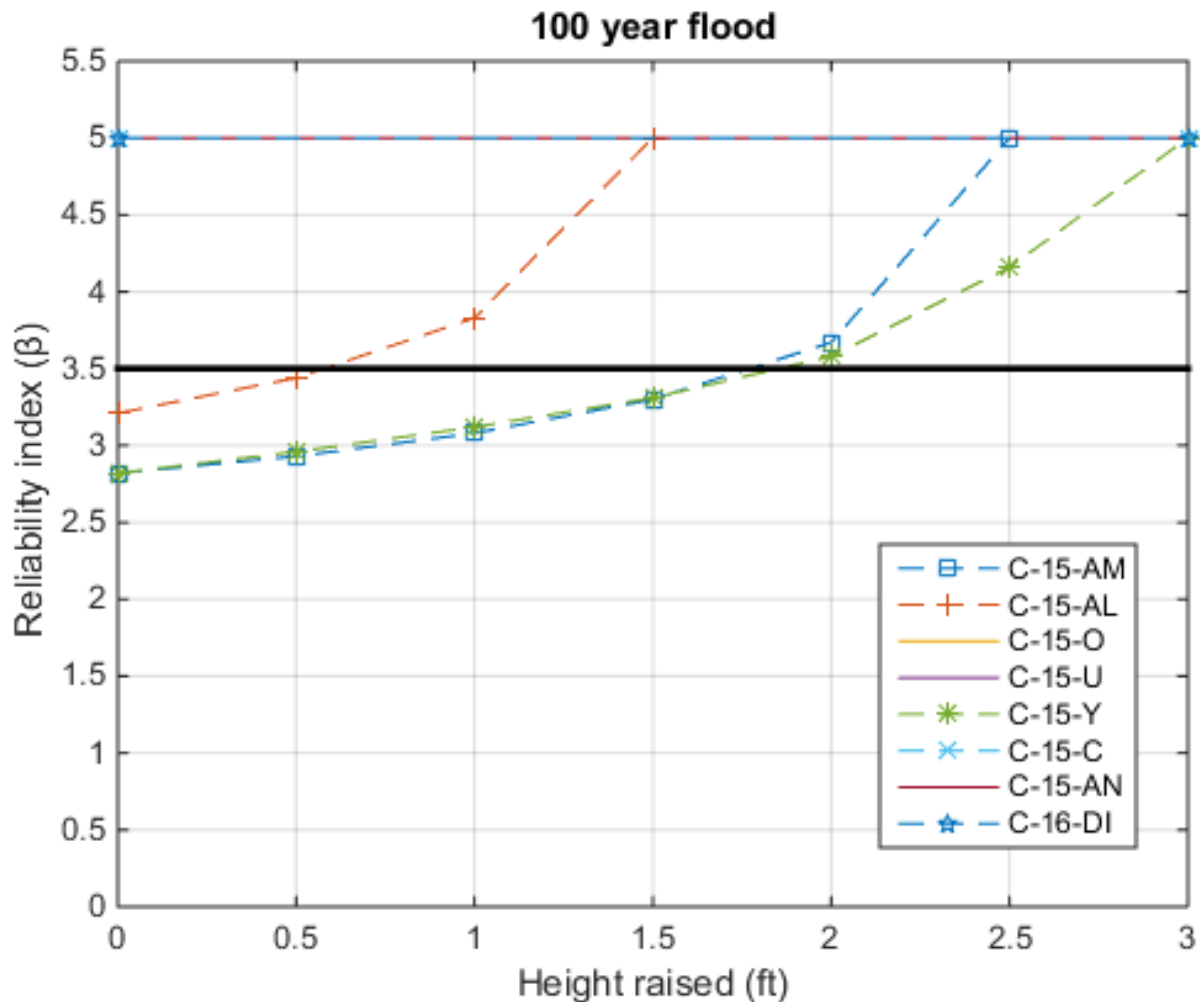


Figure 4.1 100 year flood beta values for all bridges

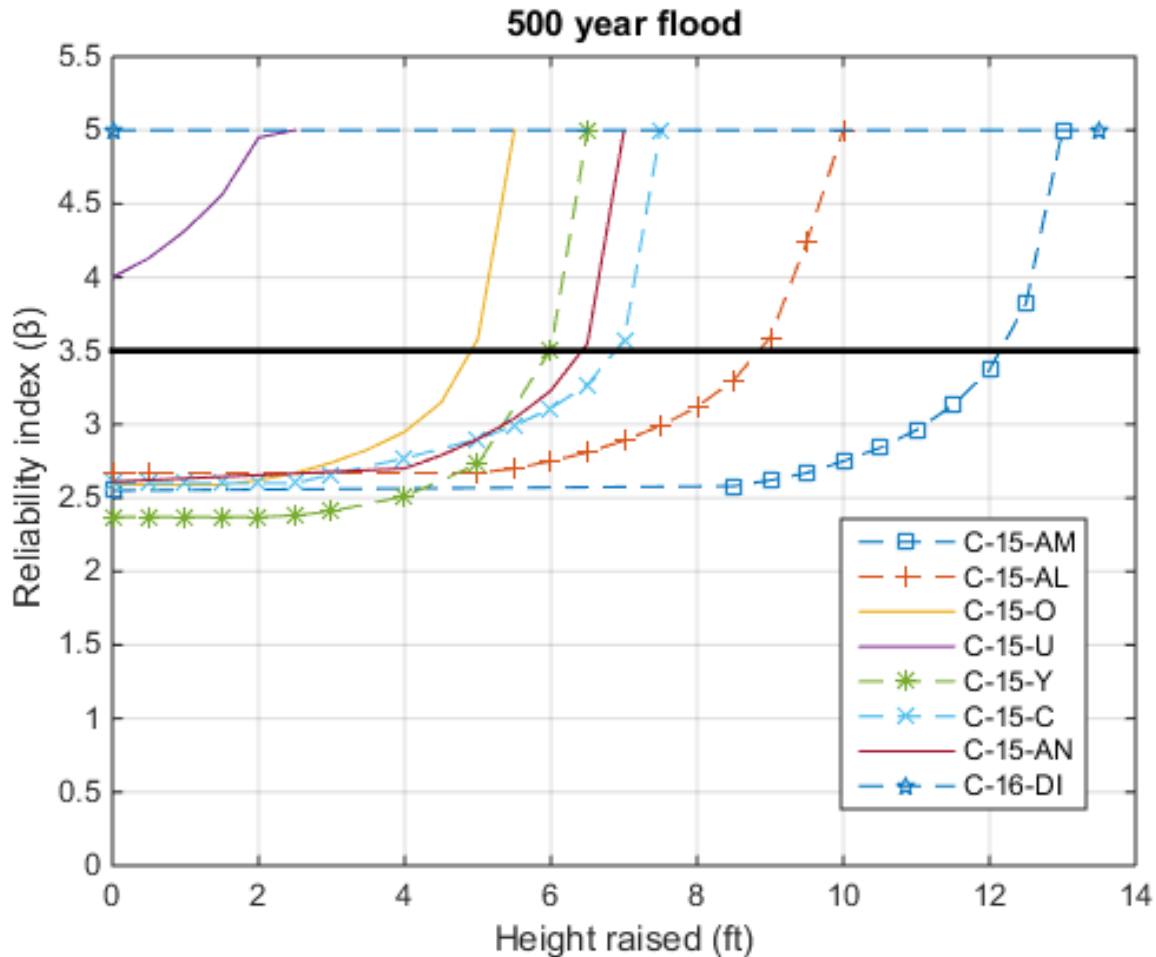


Figure 4.2 500 year flood beta values for all bridges

Figures 4.1 and 4.2 display the elevation adjustments needed for each bridge to satisfy the target beta value for the 100 and 500-year floods. If a bridge had zero probability of failure, then the beta value was set to 5. Also, the bridges were assumed to be raised in 0.5' increments. The height adjustments needed for the 100 year flood range from 1' to 2' and only three bridges require alterations. C-15-Y is the most critical of the three. This makes sense, considering it suffered the most damage due to the September 2013 flood. The height adjustments needed for the 500-year flood range from 5' to 12.5' for six of the eight bridges in this study. The reason why such high adjustments are warranted for the 500-year flood is due to the high probability of failure at low inundation ratios for this type of flow. So even though the 500-year flood results in $h^*=0.25$ for certain bridges, the high demand coupled with low capacity would require adjustments such that the 500-year flood doesn't result in inundation.

As a result of bridge scour concerns, lowering the channel elevation would not be a feasible mitigation strategy to reduce the failure probability of the superstructure. Bridge scour is currently designed based on the 500-year flood due to it being a catastrophic failure mechanism and decreasing the riprap and depth of soil around bridge foundations would be ill advised. Raising the height of the bridge deck would be the most practical solution.

Bridge substructure components take into account the numerous forces associated with flood flows. This study solely analyzed the superstructure as to quantify the risk associated with inundation. With the trend of a higher frequency of low probability flood events, the risk will only rise. Also, the uncertainty in discharge estimates increases the probability of failure. Future research should be based on the analysis of several different bridge configurations under varying velocity flows as to produce a wide array of fragilities applicable all kinds of flow conditions. Another consideration should be made to assess the fragilities of embankments and approach roadway failure due to erosion.

REFERENCES

- American Association of State Highway and Transportation Officials (AASHTO). (1994). AASHTO LRFD bridge design specifications, 1st Ed., Washington, D.C.
- Aguilar, J. (2014). Colorado re-emerging from \$2.9 billion flood disaster a year later. Retrieved September, 2015.
- Biondini, F., Bontempi, F., Frangopol, D. M., & Malerba, P. G. (2006). Probabilistic service life assessment and maintenance planning of concrete structures. *Journal of structural engineering*, 132(5), 810-825.
- Bolinger, B. (2013). Colorado Flood 2013. Retrieved September, 2015.
- Botts et al. (2013). Natural Hazard Risk Summary and Analysis. Retrieved August, 2015.
- Bradbury, R. B., Hill, R. A., Mason, D. C., Hinsley, S. A., Wilson, J. D., Balzter, H., ... & Bellamy, P. E. (2005). Modelling relationships between birds and vegetation structure using airborne LiDAR data: a review with case studies from agricultural and woodland environments. *Ibis*, 147(3), 443-452.
- (a) Brunner, G. W. (2010). HEC-RAS River Analysis System Hydraulic Reference Manual Version 4.1 (Report CPD-69).
- (b) Brunner, G. W. (2010) HEC-RAS River Analysis System User's Manual Version 4.1 (Report CPD-68).
- Computer and Structures, Inc. (2013). SAP2000, Analysis Reference Manual, Berkeley, Calif.
- Culmo, M. P. (2009). Connection Details for Prefabricated Bridge Elements and Systems. (Report No. FHWA-IF-09-010).
- Denson, K. H. (1982). *Steady-state drag, lift and rolling-moment coefficients for inundated inland bridges* (No. FHWA-MSHD-RD-82-077 Final Rpt.).
- Disaster Recovery. (n.d.). Retrieved September, 2015 from: <https://www.colorado.gov/pacific/dola/node/101531>.
- Ellingwood, B. R., Galambos, T. V., MacGregor, J. G., & Cornell, C. A. (1980). Development of a Probability Based Load Criterion for American National Standard A58. Washington (DC).
- Erdman, J. (2013). Colorado Flash Flooding: How It Happened, How Unusual? Retrieved September, 2015.
- Ghosn, M., & Moses, F. (1998). NCHRP Report 406. *Redundancy in Highway Bridge Superstructures*.
- Hydrologic Information Center - Flood Loss Data. (2015). Retrieved August, 2015
- Jacobs. (2014). Hydrologic Evaluation of the Big Thompson Watershed. Retrieved from Big Thompson River Restoration Coalition: http://bigthompson.co/wp-content/uploads/2015/05/CDOT-2014_Hydrologic-evaluation-of-the-Big-T.pdf
- Jempson, M. (2000). Flood and debris loads on bridges.
- Kerenyi, K., Sofu, T., & Guo, J. (2009). Hydrodynamic forces on inundated bridge decks.
- Malavasi, S., & Guadagnini, A. (2003). Hydrodynamic loading on river bridges. *Journal of Hydraulic Engineering*, 129(11), 854-861.
- Matsuda, K., Cooper, K. R., Tanaka, H., Tokushige, M., & Iwasaki, T. (2001). An investigation of Reynolds number effects on the steady and unsteady aerodynamic forces on a 1: 10 scale bridge deck section model. *Journal of Wind Engineering and Industrial Aerodynamics*, 89(7), 619-632.

- McCain, J. F., Shroba, R. R., & Soule, J. M. (1979). *Storm and flood of July 31-August 1, 1976, in the Big Thompson River and Cache la Poudre River basins, Larimer and Weld Counties, Colorado* (Vol. 1115). US Govt. Print. Off.: for sale by the Supt. of Docs., GPO.
- Mirza, S. A., Kikuchi, D. K., and MacGregor, J. G. (1980). "Flexural strength reduction factor for bonded prestressed concrete beams." *J. ACI*, 77(4), 237-246.
- Naaman, A. E., & Siriaksorn, A. (1982). Reliability of partially prestressed beams at serviceability limit states. *PRECAST/PRESTRESSED CONCRETE INSTITUTE. JOURNAL*, 27(6).
- Naudascher, E., & Medlarz, H. J. (1983). Hydrodynamic loading and backwater effect of partially submerged bridges. *Journal of Hydraulic Research*, 21(3), 213-232.
- Nowak, A. S. (1995). Calibration of LRFD bridge code. *Journal of Structural Engineering*.
- Nowak, A., E. Szeliga, and M. Szerszen. 2008. Reliability-Based Calibration for Structural Concrete, Phase 3. Portland Cement Association Research and Development Serial No. 2849, pp. 1–110
- Okajima, A., Yi, D., Sakuda, A., & Nakano, T. (1997). Numerical study of blockage effects on aerodynamic characteristics of an oscillating rectangular cylinder. *Journal of wind engineering and industrial aerodynamics*, 67, 91-102.
- Parry ML, Canziani O, Palutikof JP, Hanson C, van der Linden P (eds) (2007) *Climate change 2007: Impacts, adaptation and vulnerability. Contribution of Working Group II to the Fourth Assessment Report of the Intergovernmental Panel on Climate Change*. Cambridge University Press, New York
- Rosowsky, D. V., & Ellingwood, B. R. (2002). Performance-based engineering of wood frame housing: Fragility analysis methodology. *Journal of Structural Engineering*, 128(1), 32-38.
- Siriaksorn, A., & Naaman, A. E. (1980). Reliability of Partially Prestressed Beams at Serviceability Limit States. *Department of Civil Engineering, Report*, (80-1).
- Solomon S, Qin D, Manning M, Chen Z, Marquis M, Averyt KB, Tignor M, Miller HL (eds) (2007) *Climate change 2007: The physical science basis. Contribution of Working Group I to the Fourth Assessment Report of the Intergovernmental Panel on Climate Change*. Cambridge University Press, New York
- Ulccellini L.W. (2014). The Record Front Range and Eastern Colorado Floods of September 11-17, 2013. Retrieved September, 2015.
- Wright, L., Chinowsky, P., Strzepek, K., Jones, R., Streeter, R., Smith, J. B., . . . Perkins, W. (2012). Estimated effects of climate change on flood vulnerability of U.S. bridges. *Mitigation and Adaptation Strategies for Global Change*, 17(8), 939-955. doi:<http://dx.doi.org/10.1007/s11027-011-9354-2>

APPENDIX A. CONSTRUCTION DRAWINGS

C-15-AM Construction Drawings

GENERAL NOTES

EXCEPT AS SHOWN IN THE PLANS, STRUCTURE EXCAVATION AND BACKFILL SHALL BE IN ACCORDANCE WITH M-208-2.

EXPANSION JOINT MATERIAL SHALL CONFORM TO ASHTO SPECIFICATION M213.

THE EXPOSED CONCRETE SURFACES OF THE WINGWALLS AND THE EXTERIOR CURBS (SEE THE PLANS) SHALL BE STAINED. THE COLOR SHALL BE BEIGE, EQUIVALENT TO FEDERAL COLOR STANDARD 8925, COLOR NO. 33446, AND SHALL EXTEND AT LEAST 1 FOOT BELOW FINAL GRADE ON THE WINGWALLS.

LEVELING PADS ARE UNLAMINATED BEARINGS. THEY SHALL BE CUT OR WOLDED FROM ASHTO ELASTOMER GRADE 3, 4, OR 5 AS DESCRIBED IN TABLES 705-1 AND 705-2 WITH A DIALOMETER (SHORE "A") HARDNESS OF 60.

GRADE 60 REINFORCING STEEL IS REQUIRED.

ALL REINFORCING STEEL SHALL BE EPOXY COATED UNLESS OTHERWISE NOTED.

① DENOTES NON COATED REINFORCING STEEL.

THE FOLLOWING TABLE GIVES THE MINIMUM LAP SPlice LENGTH FOR EPOXY COATED REINFORCING BARS PLACED IN ACCORDANCE WITH SUBSECTION 602.06. THESE SPlice LENGTHS SHALL BE INCREASED BY 25% FOR BARS SPACED AT LESS THAN 6" ON CENTER.

BAR SIZE	#4	#5	#6	#7	#8	#9	#10	#11
SPlice LENGTH FOR CLASS 50 CONCRETE AND CLASS S40	1'-3"	1'-7"	2'-5"	2'-10"	3'-8"	4'-8"	5'-11"	7'-3"

THE FOLLOWING TABLE GIVES THE MINIMUM LAP SPlice LENGTH FOR BLACK REINFORCING STEEL. THESE SPlice LENGTHS SHALL BE INCREASED BY 25% FOR BARS SPACED AT LESS THAN 6" ON CENTER.

BAR SIZE	#4	#5	#6	#7	#8	#9	#10	#11
SPlice LENGTH FOR CLASS 40 CONCRETE AND CLASS S40	1'-1"	1'-4"	1'-7"	1'-11"	2'-6"	3'-1"	3'-11"	4'-10"

EXIST'G AND BAR SPACING IS 6" OR GREATER ON CENTER.

FOR STRUCTURE NUMBER INSTALLATION, SEE STANDARD S-614-12.

DESIGN DATA

ASHTO, FOURTH EDITION LRFD WITH CURRENT INTERIMS

DESIGN METHOD: LOAD AND RESISTANCE FACTOR DESIGN

LIVE LOAD: HL-93 (DESIGN TRUCK OR TANDER AND DESIGN LANE LOAD)
 DEAD LOAD: ASHES: 30 LBS. PER SQ. FT. FOR BRIDGE DECK OVERLAY
 UTILITIES: 100 LBS./LIN. FT.

REINFORCED CONCRETE: $f'_c = 4,500$ psi
 $f_y = 5,800$ psi
 **CLASS S40 CONCRETE: $f'_c = 60,000$ psi
 REINFORCING STEEL: $f_y = 60,000$ psi

•• THE BRIDGE DECK HAS BEEN DESIGNED FOR AN f'_c OF 4500 psi. THE BRIDGE DECK CAN BE OPENED TO TRAFFIC WHEN THE CONCRETE HAS ATTAINED A MINIMUM FIELD COMPRESSIVE STRENGTH OF 4000 psi AND IT HAS CURED A MINIMUM OF 5 DAYS. THE CURING COMPOUND SHALL BE APPLIED TO ALL EXPOSED SURFACES IMMEDIATELY AFTER CURING OF THE STRUCTURE SITE IN ACCORDANCE WITH ASHTO 23.1 AND TESTED IN ACCORDANCE WITH ASHTO T 22 OR A MATURITY RELATIONSHIP ESTABLISHED IN ACCORDANCE WITH THE SPECIFICATIONS.

CAISSON CONCRETE:

CLASS B7 CONCRETE: $f'_c = 4,000$ psi
 REINFORCING STEEL: $f_y = 60,000$ psi
 PRESTRESSED PRECAST CONCRETE: $f'_c =$ (SEE DETAILS)
 PRESTRESSING STEEL: $f_e = 270,000$ psi



BRIDGE DESCRIPTION

A ONE SPAN (111'-0") BRIDGE WITH PRESTRESSED PRECAST CONCRETE GIRDERS (BT 42'S) OVER THE BIG THOMPSON RIVER WITH A 43'-0" WIDE BRIDGE DECK, 63' 09" 00" SKEW AND BRIDGE RAIL TYPE 10M.




ITEM NO.	ITEM DESCRIPTION	SUMMARY OF QUANTITIES					TOTAL
		UNITS	SUPER	STRUCTURE	ABUTMENT 1	ABUTMENT 2	
202	REMOVAL OF STRUCTURE	EACH	1				1
206	STRUCTURE EXCAVATION	CY		302			302
206	STRUCTURE BACKFILL (CLASS 2)	CY		38			38
206	STRUCTURE BACKFILL (FLOWILL)	CY		96			96
403	HOT MIX ASPHALT (GRADING SX) (75) (PG 64-28)	TON	82.5				82.5
500	DRILLED CAISSONS (30 INCH)	LF		54.4		48.2	102.6
506	PIPPAF (16')	CY					
915	WATER-PROOFING (MEMBRANE)	SF	905.9				905.9
601	CONCRETE CLASS D (BRIDGE)	CY		22		22	44
601	CONCRETE CLASS S40	CY	139		20		159
601	STRUCTURAL CONCRETE STAIN	SF	2800				2800
602	REINFORCING STEEL	LB		5130		6000	12,410
602	REINFORCING STEEL (EPOXY COATED)	LB	23,205		1,200	1,170	25,575
606	BRIDGE RAIL TYPE 10M	LF	251				251
613	2 INCH ELECTRICAL CONDUIT	LF	252				252
616	PRESTRESSED CONCRETE (B742)	LF	162.8				162.8

INDEX OF DRAWINGS

- B 1 GENERAL INFORMATION AND SUMMARY OF QUANTITIES
- B 2 GENERAL LAYOUT
- B 3 ENGINEERING GEOLOGY
- B 4 BRIDGE HYDRAULIC INFORMATION - C-15-AM
- B 5 CONSTRUCTION LAYOUT
- B 6 CAISSON LAYOUT
- B 7 ABUTMENT 1 DETAILS
- B 8 ABUTMENT 2 DETAILS
- B 9 WINGWALL DETAILS
- B 10 BRIDGE DECK DETAILS
- B 11 PRESTRESSED CONCRETE I
- B 12 PRECAST PANEL DECK FORM (SHEET 1 OF 2)
- B 13 PRECAST PANEL DECK FORM (SHEET 2 OF 2)
- B 14 STRUCTURE BACKFILL (FLOWILL)
- B 15 BRIDGE RAIL TYPE 10M
- B 16 BRIDGE RAIL TYPE 10M (MISC.)
- B 17 BRIDGE DECK ELEVATIONS (SHEET 1 OF 4)
- B 18 BRIDGE DECK ELEVATIONS (SHEET 2 OF 4)
- B 19 BRIDGE DECK ELEVATIONS (SHEET 3 OF 4)
- B 20 BRIDGE DECK ELEVATIONS (SHEET 4 OF 4)
- B 21 BRIDGE DECK ELEVATIONS (SHEET 4 OF 4)


GENERAL INFORMATION AND SUMMARY OF QUANTITIES Project No./Code: BR 0341-068 Designer: D. Deschamps Detailer: D. Deschamps Sheet Subject: Bridge Subst Sheet: B 1 of 2		As Constructed No. Revisions: Revised: Void:		Colorado Department of Transportation 2207 EAST HIGHWAY 402 LOVELAND, COLORADO 80537 Phone: 970-657-4670 FAX: 970-689-0289 SCE	
Sheet Revisions Date: _____ Comments: _____		Drawing File Name: \$DATE\$ Horiz. Scale: \$SCALE\$ SHORT Vert. Scale: As Noted Unit Leader: _____		Print Date: \$DATE\$ Horiz. Scale: \$SCALE\$ SHORT Vert. Scale: As Noted Unit Leader: _____	

Design	DATE	INITIALS	DATE	INITIALS
Checked By:	MC	11/09	Checked By:	MC
Checked By:	MC	11/09	Checked By:	MC
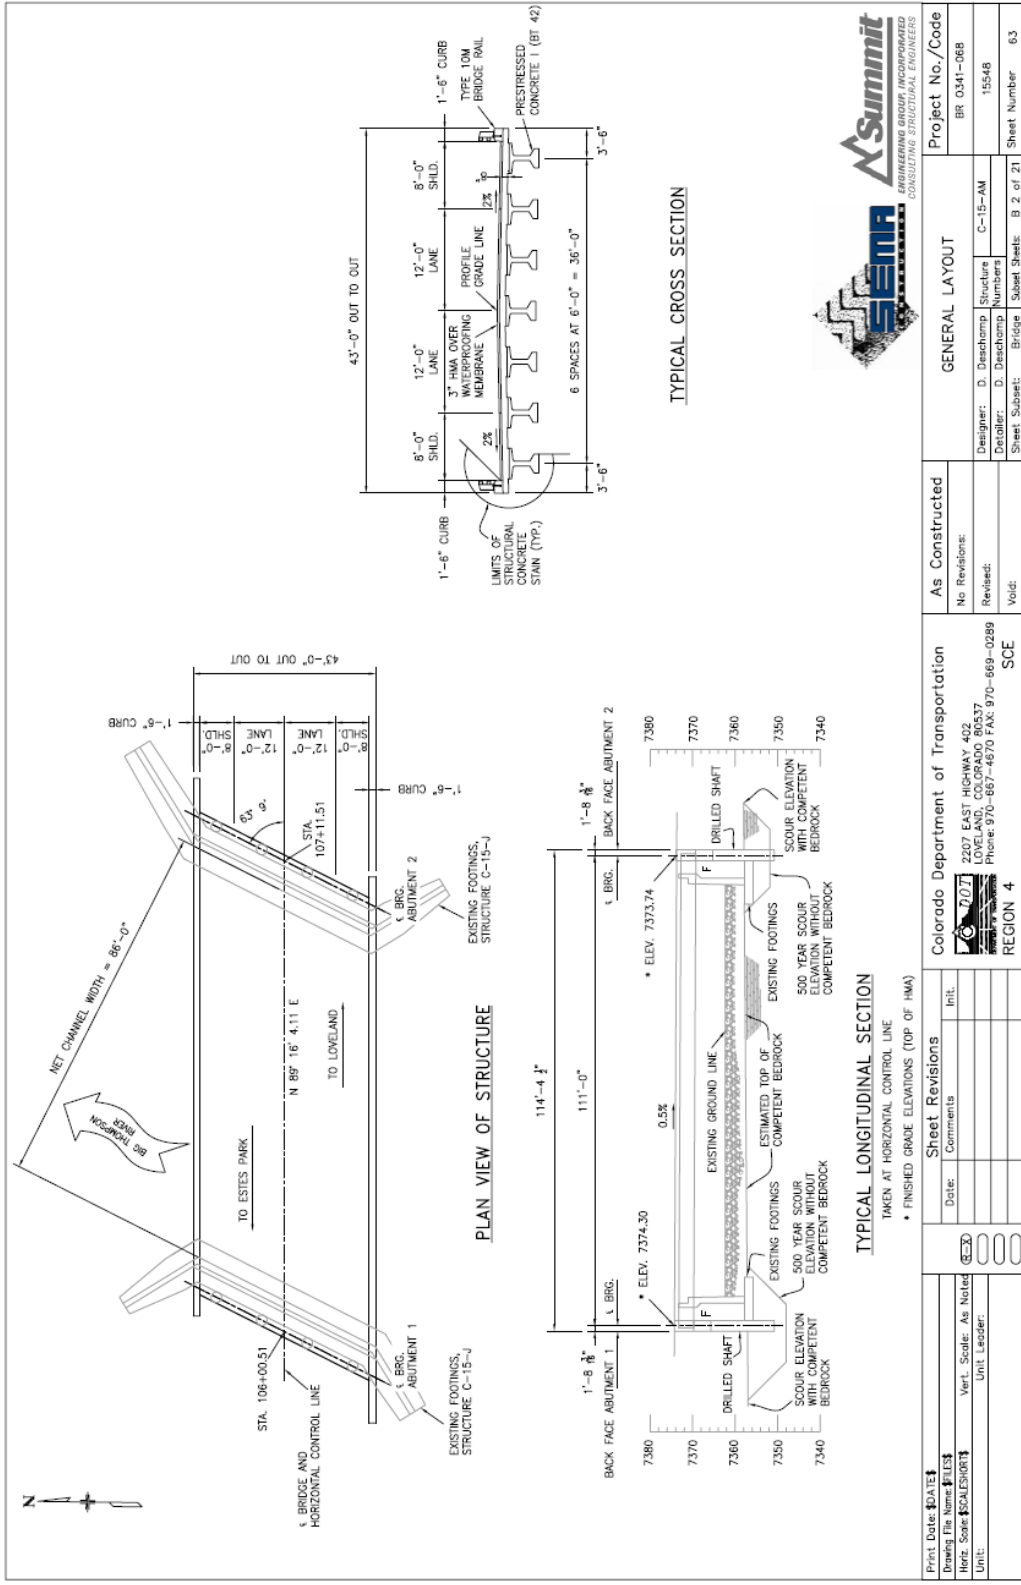

Print Date: \$DATE\$ Drawing File Name: \$FILES\$ Horiz. Scale: \$SALES\$ Unit:		Sheet Revisions Date: _____ Comments: _____ Init.: _____		Colorado Department of Transportation 2207 EAST HIGHWAY 402 LOVELAND, COLORADO 80537 Phone: 970-667-4670 FAX: 970-669-0289 SCE	
Design: D. Deschamps Designer: D. Deschamps Detailer: D. Deschamps Sheet Subject: Bridge		As Constructed No Revisions: Reviewed: Void:		Project No./Code BR 0341-068 15546 63	
GENERAL LAYOUT Designer: D. Deschamps Detailer: D. Deschamps Sheet Subject: Bridge		No Revisions: Reviewed: Void:		Project No./Code BR 0341-068 15546 63	




Checked By	MC	11/20	Checked By	MC	11/20
Checked By	MC	11/20	Checked By	MC	11/20
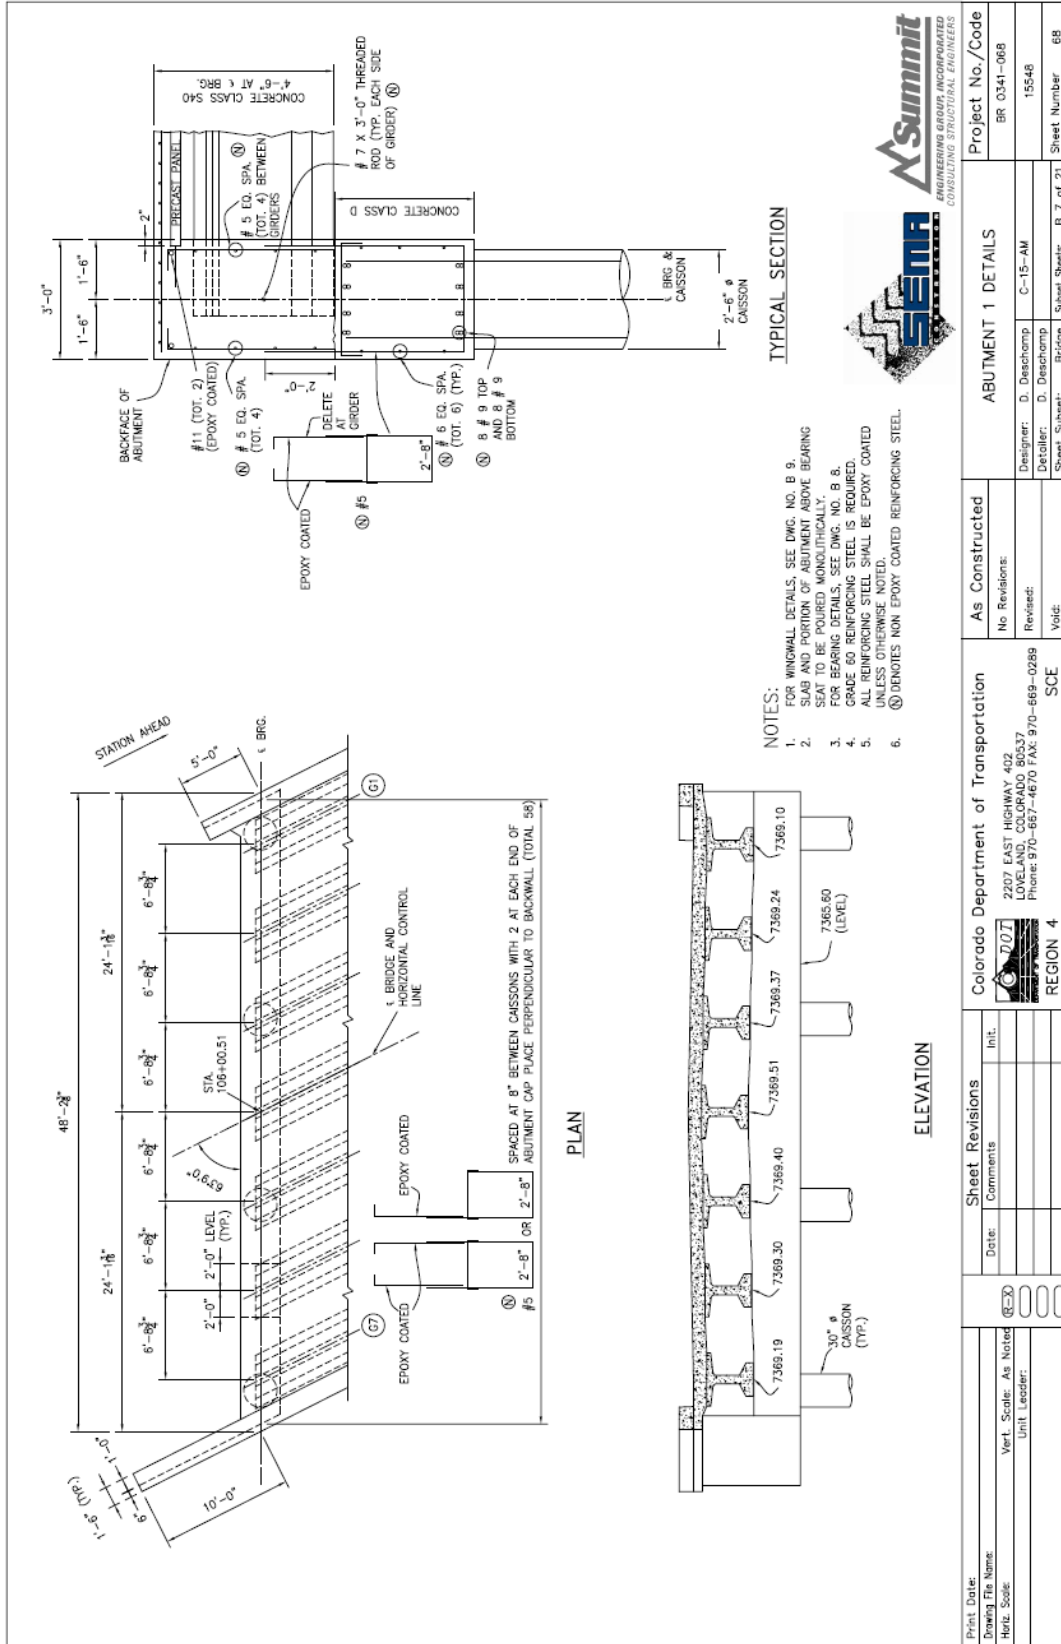

Prep.	DESIGNED BY		DATE	Checked by	DATE	Quantity

Function	NAME	DATE	Checked by	DATE
Function Name (Preliminary Scope Only)				

Print Date:	Colorado Department of Transportation		Project No./Code
Drawing File Name:	2207 EAST HIGHWAY 402	REGION 4	BR 0341-068
Vertical Scale: As Noted	LOVELAND, COLORADO 80537	Sheet No. of Total	15548
Horizontal Scale:	Phone: 970-667-4670 FAX: 970-669-0288	Design: D. Deschomp	
		Detail: D. Deschomp	
		Sheet Subnet: Bridge	Sheet Number 68
Sheet Revisions	SCE	As Constructed	ABUTMENT 1 DETAILS
Date:		No Revisions:	
Comments:		Revised:	
Init.:		Void:	
Unit Leader:			

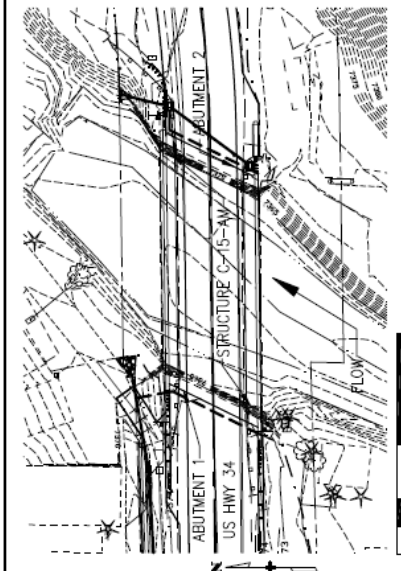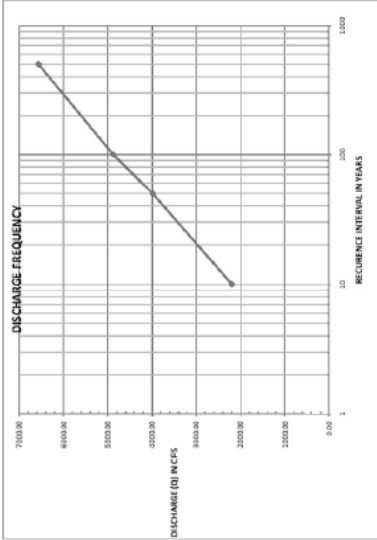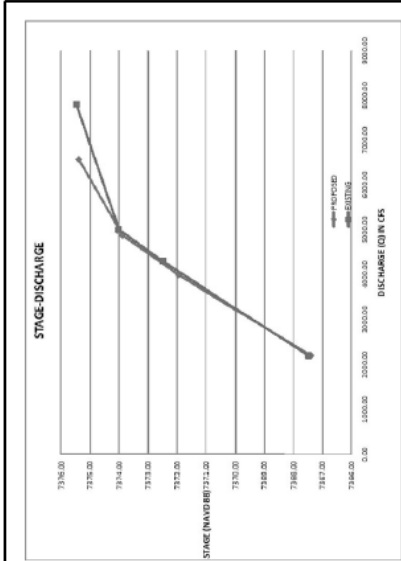


HYDRAULIC DATA TABLE

RECURRANCE INTERVAL (YRS)	QAVE (CFS)	VELOCITY (FT/SEC)	WHEEL UPSTREAM OF BRIDGE (FT)	WEST ABUTMENT SCOUR DEPTH (FT)	EAST ABUTMENT SCOUR DEPTH (FT)
10	1200.00	8.00	7997.40	7.00	0.00
50	3999.48	8.00	7971.95	7.00	1.00
100	4576.00	216.00	7973.88	11.32	11.35
500	8569.82	202.00	7975.35	14.91	11.32

HYDRAULIC DATA:
 CHANNEL TYPE: OPEN NON-COHESSIVE
 BOTTOM MATERIAL: STRAIGHT MEANING BRAIDED
 BOTTOM MATERIAL PARTICLE SIZE: CLAY SILT SAND GRAVEL COBBLES
 CHANNEL STABILITY: STABLE AGGRAVATING DEGRADING
 ICE: YES NO UNKNOWN

EXISTING VELOCITY: 10.45
EXISTING FLOW: 7377.49
EXISTING CHANNEL: 10.45
EXISTING CHANNEL: 7377.49
EXISTING CHANNEL: 10.45
EXISTING CHANNEL: 7377.49

GEOTECHNICAL DATA:
 SOIL TYPE: CLAY SILT SAND GRAVEL
 CHANNEL STABILITY: STABLE AGGRAVATING DEGRADING
 ICE: YES NO UNKNOWN

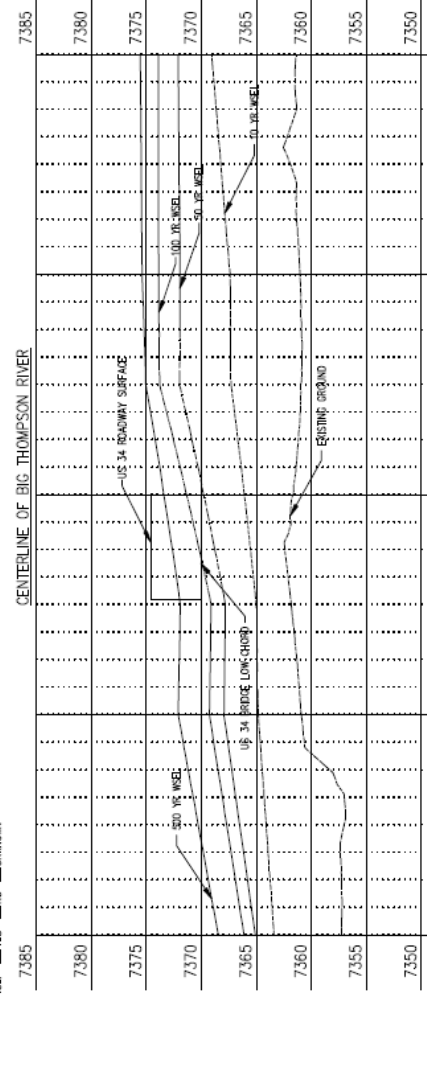

BRIDGE HYDRAULIC INFORMATION

Project No./Code: BR 0341-088

Designer: JSD Structure Number: C-15-AW

Detailer: JSD Number: 15548

Sheet Subst: 4 of 21 Subst Sheets: 4 of 21 Sheet Number: 65

As Constructed

No Revisions:

Revised:

Void:

Colorado Department of Transportation


2207 East Highway 402
 Loveland, CO 80537
 Phone: 970-687-4670 Fax: 970-689-0289

Region 4, SCE

Sheet Revisions

Date:	Init:

Print Date: 12/10/2009
 File Name: C:\S\15548\HYDR_BRIDGE\HYDRAULIC\CS01.dwg
 Horiz. Scale: 1" = 50'
 Unit Information: Unit Leader Initials

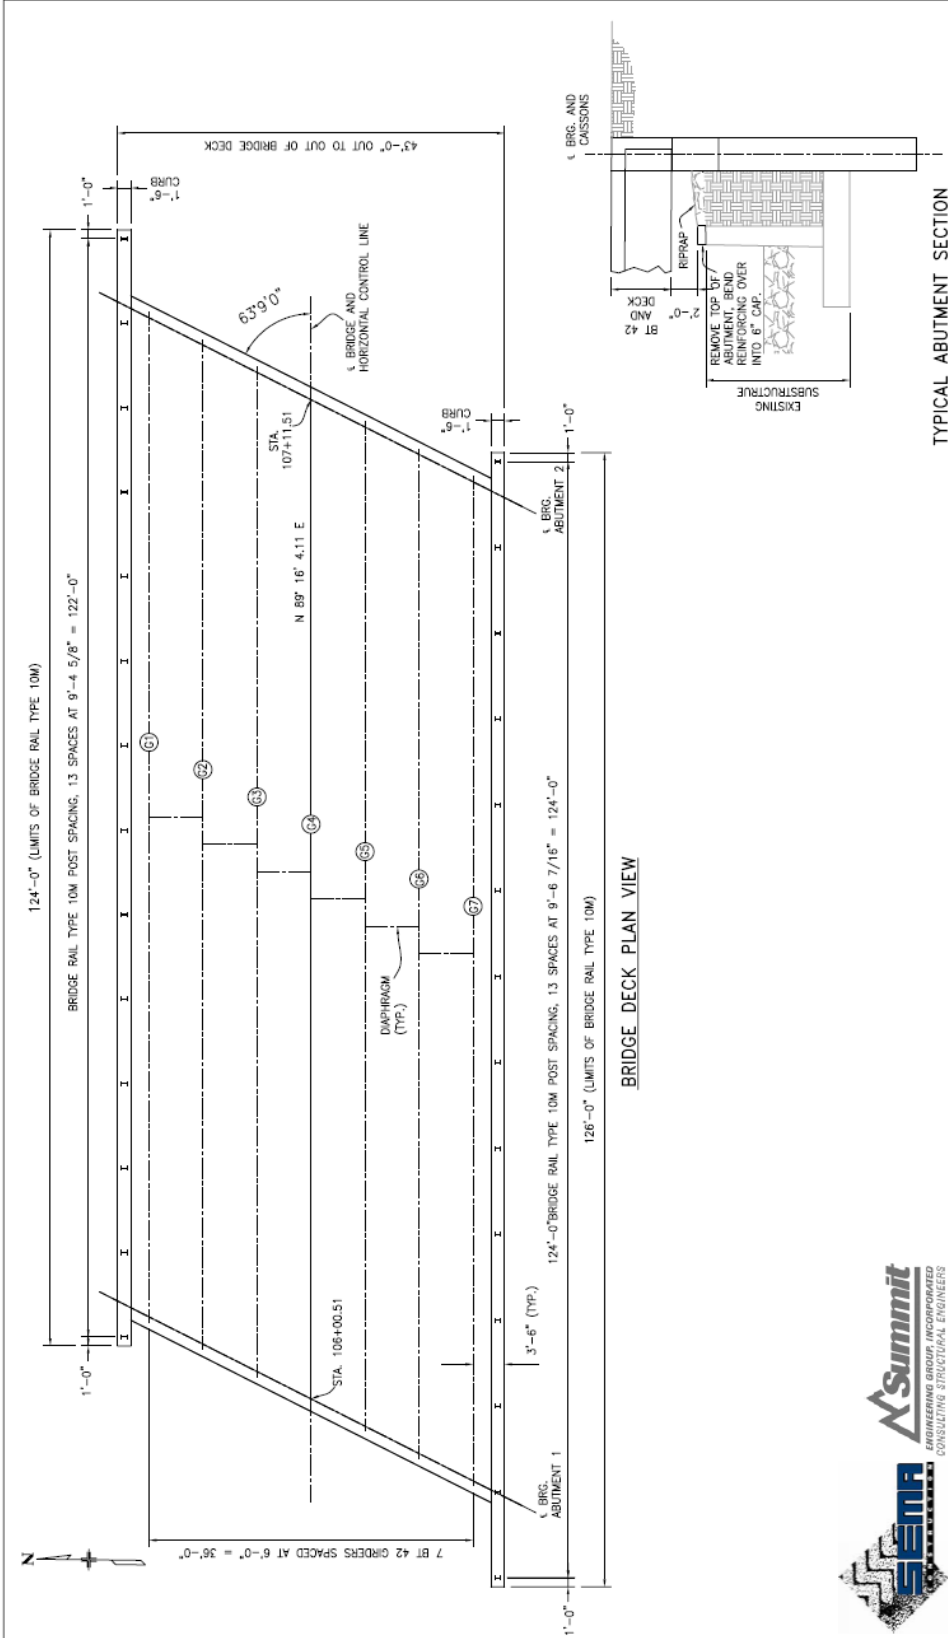


TYPICAL ABUTMENT SECTION

Print Date: DATE\$ Drawing File Name: FILES\$ Horiz. Scale: SCALE\$HORIZ Unit:		Sheet Revisions Date: _____ Comments: _____ Init.: _____ (E-X) <input type="checkbox"/> <input type="checkbox"/> <input type="checkbox"/>	Colorado Department of Transportation 2207 EAST HIGHWAY 402 LOVELAND, COLORADO 80537 Phone: 970-667-4670 FAX: 970-669-0289 REGION 4	As Constructed No. Revisions: _____ Revises: _____ Void: _____	CONSTRUCTION LAYOUT Designer: D. Deschamps Structure Number: C-15-AM Detailer: D. Deschamps Bridge Subst. Sheet: B 5 of 21	Project No./Code BR 0341-068 15548 Sheet Number 66
--------------------------------------------------------------------------------------------------------------	--	-------------------------------------------------------------------------------------------------------------------------------------------------------	------------------------------------------------------------------------------------------------------------------------------------------------------------	-------------------------------------------------------------------------	----------------------------------------------------------------------------------------------------------------------------------------	----------------------------------------------------------------




Checked By: _____	Checked By: _____	Checked By: _____	Checked By: _____	Checked By: _____	Checked By: _____	Checked By: _____	Checked By: _____
DATE: _____	DATE: _____	DATE: _____	DATE: _____	DATE: _____	DATE: _____	DATE: _____	DATE: _____
Initials: _____	Initials: _____	Initials: _____	Initials: _____	Initials: _____	Initials: _____	Initials: _____	Initials: _____

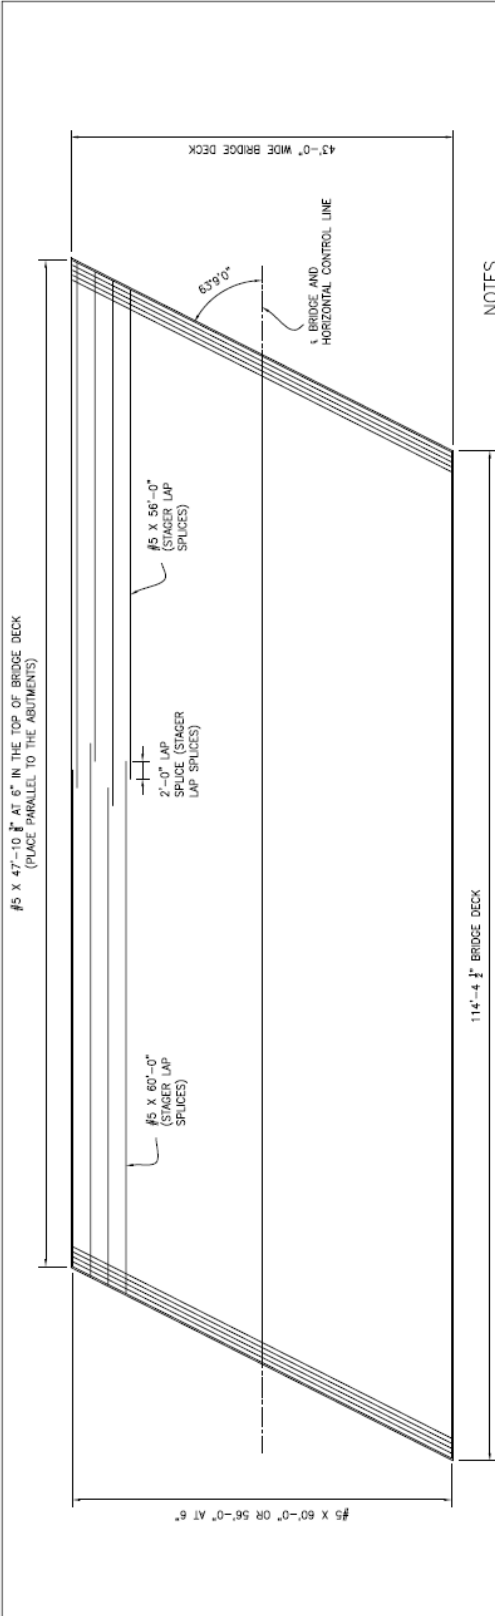

NOTES
 THE BRIDGE DECK CONCRETE SHALL BE CONCRETE CLASS 504.
 THE BRIDGE DECK HAS BEEN DESIGNED FOR AN f_c OF 4500 PSI. THE BRIDGE DECK SHALL BE CURED FOR A MINIMUM OF 7 DAYS AND TESTED IN ACCORDANCE WITH ASTM T 22 OR A STRUCTURE TEST. TEST CYLINDERS MADE AND CURED AT THE STRUCTURE SITE IN ACCORDANCE WITH ASTM T 23 AND TESTED IN ACCORDANCE WITH ASTM T 22 OR A STRUCTURE TEST. RESULTS SHALL BE ESTABLISHED IN ACCORDANCE WITH THE SPECIFICATIONS.
 FOR BRIDGE RAIL REINFORCING SEE THE BRIDGE RAIL TYPE 10M DRAWINGS.



BRIDGE DECK CROSS SECTION

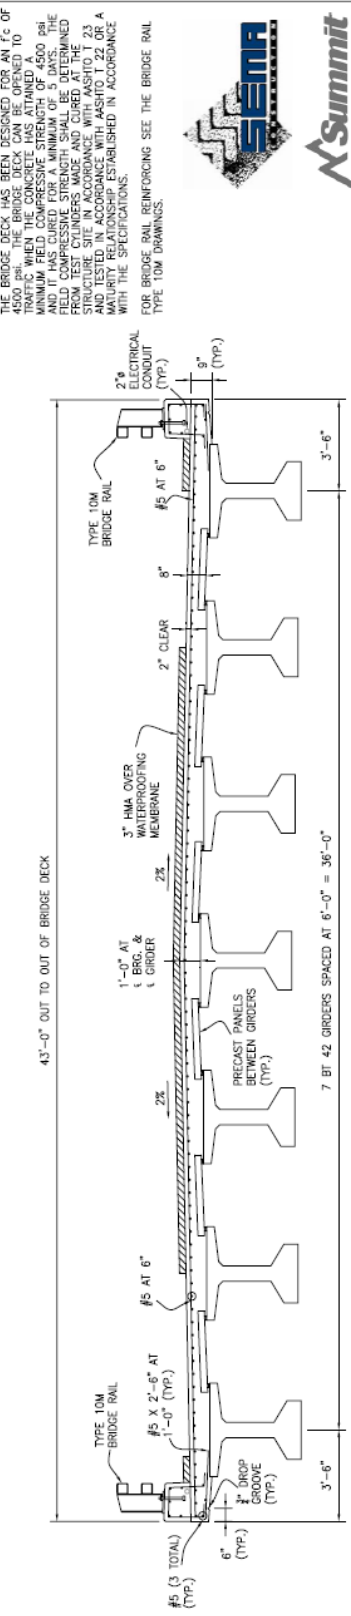

As Constructed
 No Revisions:
 Revised:
 Void:

BRIDGE DECK DETAILS
 Designer: D. Deschamps
 Detailer: D. Deschamps
 Sheet Subject: Bridge
 Structure Numbers: C-15-AM
 Subst Sheets: B 10 of 21
 Project No./Code: BR 0341-068
 15548
 Sheet Number: 71

Colorado Department of Transportation
 2207 EAST HIGHWAY 402
 LOVELAND, COLORADO 80537
 Phone: 970-667-4670 FAX: 970-669-0289
 SCE
 REGION 4

Print Date: 03/11/13
 Drawing File Name: BRIDGE DECK DETAILS
 Horiz. Scale: AS SHOWN
 Unit: INCHES
 Vertical Scale: AS NOTED
 Unit Leader: []

Date	Comments	Init.

Quantity	Unit	INITIAL	DATE

Revised By	QC'd	11/09	Checked By	MC	11/09

NOTES:

As work necessary to fabricate and install the interparts of the girder (including the intermediate diaphragms, $\frac{1}{8}$ " threaded rods, and leveling pads), as shown on the plans, shall be included in the bid price. The contractor shall be responsible for the concrete (BT 4.2), with a pay unit of feet which shall be measured by dispersion L.

When approved by the Engineer, a minimum of tack welding will be permitted on ASTM A106 uncoated reinforcing steel.

Reinforcing projecting from the top of the girder and reinforcing concrete diaphragms shall be protected with a minimum of 1" epoxy coated. Damaged coating on girder reinforcing need not be repaired. The minimum cover for reinforcing steels is 1".

At girder ends not embedded in concrete diaphragms, cut strands of epoxy grout. At girder ends embedded in concrete diaphragms, cut strands of epoxy grout. The minimum clear distance between groups or individual strands shall be $2.5(d_s)$, but not less than $\frac{1}{4}$ ". The minimum cover for prestressing steels is $\frac{1}{2}$ ".

A minimum of two harping points shall be used per girder. Harped strands shall be distributed and distributed such that there is no space between strands greater than 1'-0" at the end of the girder. As an alternate, the contractor may place $\frac{1}{8}$ " x $\frac{1}{8}$ " x 10'-0" in the sides of the girder greater than 1'-0". The harped strands such that there is no space greater than 1'-0".

A* - minimum edge of the prestressing steel.
d_s - nominal strand diameter (assumed 0.6 inch diameter).
F_u - ultimate strength of prestressing steel.
F_y - yielding force per girder all losses.
f_{ps} - required concrete strength at release of prestress force.
f_{cr} - required concrete strength at 28 days of age.
Δ - deflection at centerline of span due to cast-in-place slab, diaphragms, asphalt, curbs, rails, and walks.
 Concrete shall be Class PS.

Entrained air is not required for girder concrete.

Use $\frac{1}{2}$ " chamfer on all corners, except as noted.

Predicted camber is the camber for the girder alone at 90 days. The Contractor shall limit the camber growth to a value not to exceed the predicted camber plus 1" prior to the deck pour by weighting, scheduling fabrication, post tensioning, or other means and must report to the Engineer. Remedial measures, as approved by the Engineer, shall be taken if the predicted camber plus 1" is exceeded. The approved remedial measures shall be reported to the Engineer. Remedial measures shall be borne by the Contractor.




Project No./Code	BR 341-068
Designer: D. DESCHAMP	Structure: C-15-AM
Detailer: D. DESCHAMP	Numbers: 15548
Sheet Subst: Bridge	Sheet No: 72

As Constructed	No Revisions:
Revised:	Void:

Colorado Department of Transportation
 2207 EAST HIGHWAY 402
 LOVELAND, COLORADO 80537
 Phone: 970-667-4670 FAX: 970-669-0289
 REGION 4

Print Date: 8/24/15	Sheet Revisions	Date:	Comments
Drawing File Name: FILES			
Unit Information	Unit Leader Initials		

Vertical Scale: AS NOTED	Horizontal Scale: AS NOTED
--------------------------	----------------------------

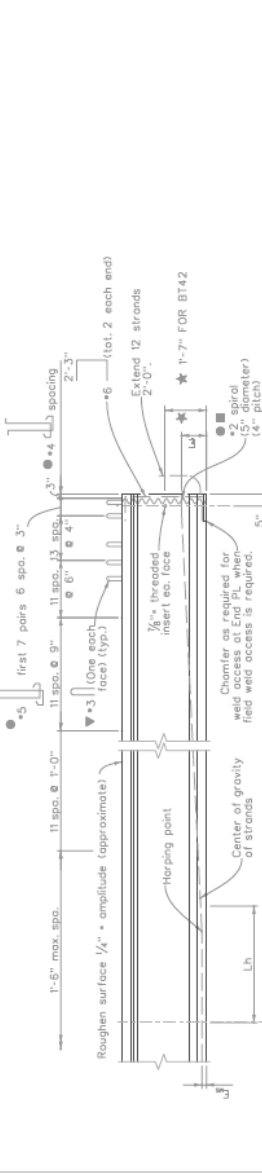

Space with #4 or #5 for stirrup spacings of 9" or more. Space at 1'-0" for stirrup spacings less than 9".

D20 wires may be used in lieu of #4. For #5, an equivalent area of wire may be used. D11 or W10.9 wires may be used in lieu of #3. W5 wires may be used in lieu of #2.


Projection varies from 9" at with #4. centerline brg. to 6" at midspan.

These legs required only on the end 20 stirrups of girder (each face).

Weld permitted at this location.

Weld permitted at this location.

Weld permitted at this location.

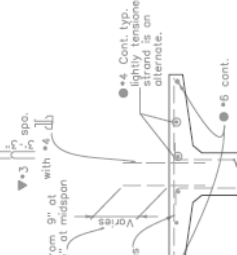


TYPICAL GIRDER SECTION
 A - girder depth - 3' - 3"

GIRDER SCHEDULE

Girder Type	Span No.	L (Feet)	L _h (Feet)	A _{sc} (Square Inch)	E _{sc} (Inch)	E _{ps} (Inch)	F _y (ksi)	F _u (ksi)	Concrete Strength		Δ (Inch)	Predicted Release (Inch)	Predicted Camber (Inch)
									F _c (psi)	F _s (psi)			
BT 4.2	1	111.83	11.2	8.68	5.2	13.6	1758	1240	7000	9000	3.5	3.4	6.5

END PLATE DETAIL
 Galvanize after fabrication.

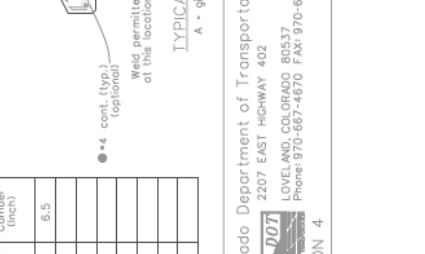

GIRDER ELEVATION


3/4" x 6" Automatically end welded anchor. Location may be adjusted to miss the strand pattern.

The Contractor may submit an alternate cross section for approval by the Engineer.

Chamfer as required for weld access at End PL when field weld access is required.

Chamfer as required for weld access at End PL when field weld access is required.


Checked By: [Blank]	Checked By: [Blank]	Checked By: [Blank]	Checked By: [Blank]	Checked By: [Blank]	Checked By: [Blank]	Checked By: [Blank]	Checked By: [Blank]	Checked By: [Blank]	Checked By: [Blank]	Checked By: [Blank]	Checked By: [Blank]	Checked By: [Blank]	Checked By: [Blank]	Checked By: [Blank]	Checked By: [Blank]
---------------------	---------------------	---------------------	---------------------	---------------------	---------------------	---------------------	---------------------	---------------------	---------------------	---------------------	---------------------	---------------------	---------------------	---------------------	---------------------

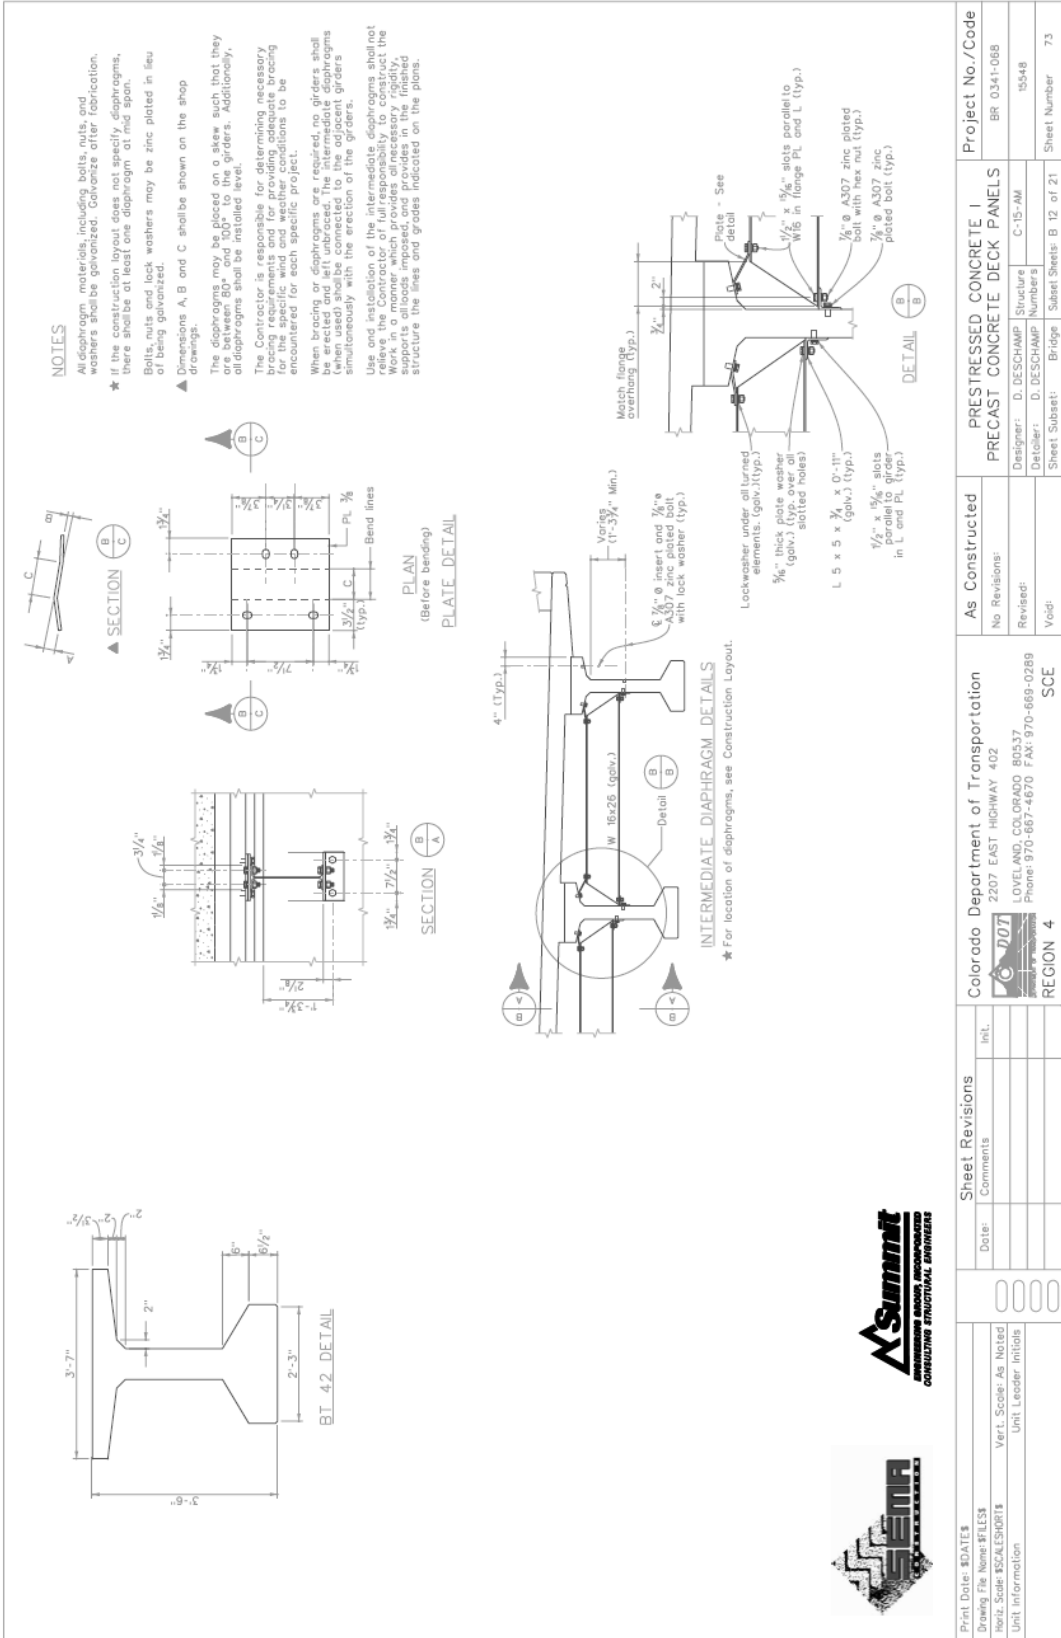


Print Dates: \$DATES	Sheet Revisions	Colorado Department of Transportation	As Constructed	Prestressed Concrete I	Project No./Code
Drawing File Name: \$FILE\$	Date: _____	2207 EAST HIGHWAY 402	No Revisions	PRECAST CONCRETE DECK PANELS	BR 0341-088
Unit Information	Comments	LOVELL AND CO. ORDO. 80537	Revised:	Designer: D. DESCHAMP	15548
Unit Leader initials		Phone 970-687-4670 FAX: 970-669-0289	Void:	Detailer: D. DESCHAMP	Structure Numbers
		REGION 4			C-15-AM
		SCE			Sheet Number
					73
					Subset Sheets: B 12 of 21



NO. 1	NO. 2	NO. 3	NO. 4	NO. 5	NO. 6	NO. 7	NO. 8	NO. 9	NO. 10	NO. 11	NO. 12	NO. 13	NO. 14	NO. 15	NO. 16	NO. 17	NO. 18	NO. 19	NO. 20

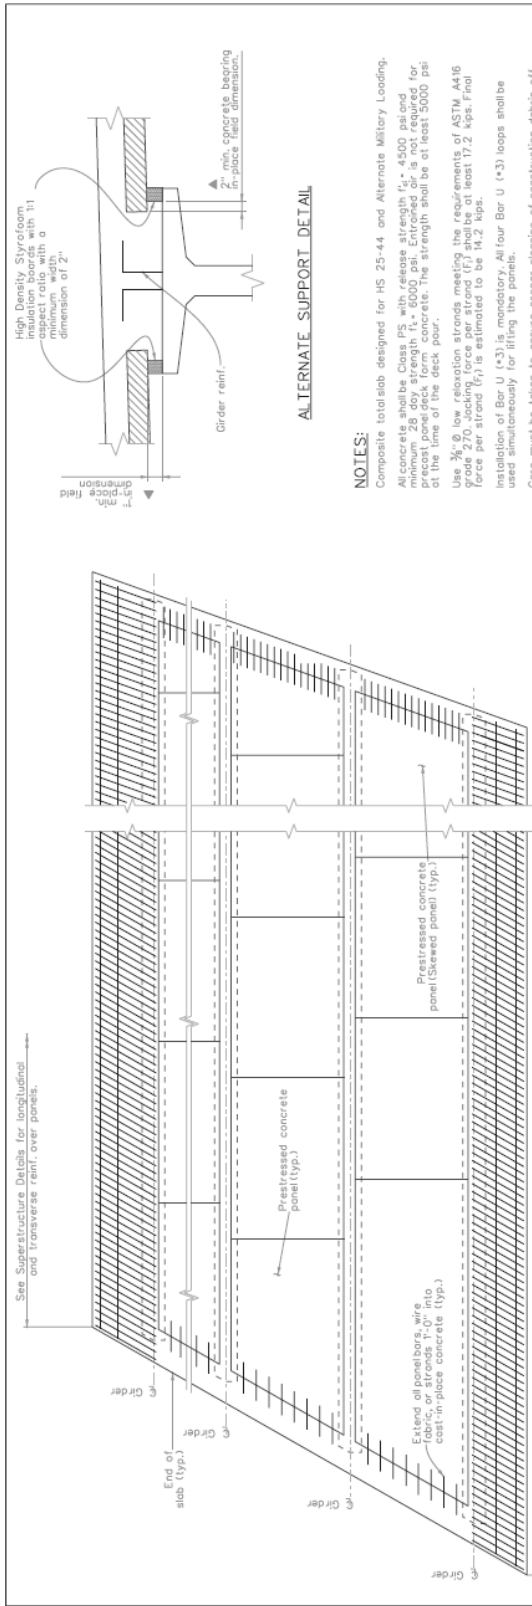

PART PLAN

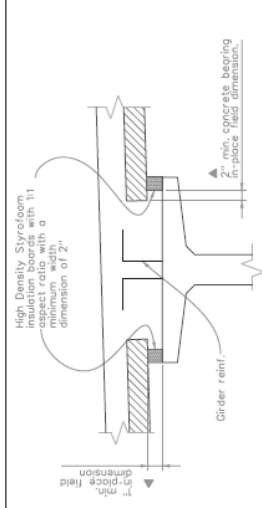

ALTERNATE SUPPORT DETAIL

NOTES:
 Composite total slab designed for HS 25-44 and Alternate Military Loading.
 All concrete shall be Class PS with release strength f_{cr} 4500 psi and minimum compressive strength f_{ci} 4000 psi for concrete. The strength shall be at least 5000 psi at the time of the deck pour.
 Use $\frac{3}{8}$ " ϕ low relaxation strands meeting the requirements of ASTM A416 grade 270. Jacking force per strand (F_j) shall be at least 17.2 kips. Final force per strand (F_s) is estimated to be 14.2 kips.
 Installation of Bar U (*3) is mandatory. All four Bar U (*3) loops shall be used simultaneously for lifting the panels.
 Care must be taken to ensure proper cleaning of construction debris off the tops of the panels and consolidation of concrete mortar under the panels. The use of a vibrator is recommended to ensure proper consolidation. Inhibit the bond of the cast-in-place concrete. It is also important that adequate space (4 min. 1" x 2") is provided for the concrete to fit the panels. The use of a vibrator is recommended to ensure proper consolidation. Width shall be determined by the Contractor and shown on the shop plans.
 The Contractor is responsible for the stability of the panels on the girders. Erected panels shall be uniformly supported along the length of the panel. The Contractor is responsible for meeting the total slab thickness shown on the Superstructure Details.



Print Date: \$DATE\$ Drawing File Name: \$FILE\$ Rev. Scale: \$SCALE\$ Unit Information	Ver.L. Scale: As Noted Unit Leader Initials	Sheet Revisions Date: _____ Comments _____ InL. _____	Colorado Department of Transportation 2207 EAST HIGHWAY 402 LOVELAND, COLORADO 80537 Phone: 970-667-4670 FAX: 970-669-0289 REGION 4	As Constructed No Revisions: Revised: Void:	PRECAST PANEL DECK FORM (MISC.) Designer: D. BESCHAMP Detailer: D. BESCHAMP Structure Numbers Sheet Subject: Bridge	Project No./Code BR 0341-068 15548 C-15-AM Numbers Sheet Number 75
--------------------------------------------------------------------------------------------------	------------------------------------------------	----------------------------------------------------------------	-------------------------------------------------------------------------------------------------------------------------------------------------	------------------------------------------------------	---------------------------------------------------------------------------------------------------------------------------------	--------------------------------------------------------------------------------------

NO.	DATE	BY	CHKD.	APP.	REVISION

C-15-AL Construction Drawings

GENERAL NOTES

EXCEPT AS SHOWN IN THE PLANS, STRUCTURE EXCAVATION AND BACKFILL SHALL BE IN ACCORDANCE WITH M-206-2.

EXPANDED JOINT MATERIAL SHALL CONFORM TO ASHTO SPECIFICATION M213. THE EXPOSED CONCRETE SURFACES OF THE WINDOW WALLS AND THE EXTERIOR GROUND (SEE THE PLANS) SHALL BE STAINED. THE COLOR SHALL BE BRICE, EQUIVALENT TO FEDERAL COLOR STANDARD 5858. COLOR NO. 33446. AND SHALL EXTEND AT LEAST 1 FOOT BELOW FINAL GRADE ON THE WINDOW WALLS.

LEVELING PADS ARE UNLUBRICATED BEARINGS. THEY SHALL BE CUT OR MOLDED FROM ASHTO (SHAPE "A") DIMENSIONS OF 8".

GRADE 60 REINFORCING STEEL IS REQUIRED.

ALL REINFORCING STEEL SHALL BE EPOXY COATED UNLESS OTHERWISE NOTED.

(X) DENOTES NON COATED REINFORCING STEEL.

THE FOLLOWING TABLE GIVES THE MINIMUM LAP SPlice LENGTH FOR EPOXY COATED REINFORCING BARS PLACED IN ACCORDANCE WITH SUBSECTION 602.06. THESE SPlice LENGTHS SHALL BE INCREASED BY 20% FOR BARS SPACED AT LESS THAN 6" ON CENTER.

BAR SIZE #4 #5 #6 #7 #8 #9 #10 #11

SPlice LENGTH FOR CLASS 0 CONCRETE AND CLASS S40

1'-3" 1'-7" 2'-5" 2'-10" 3'-8" 4'-8" 5'-11" 7'-3"

THE FOLLOWING TABLE GIVES THE MINIMUM LAP SPlice LENGTH FOR BLACK REINFORCING BARS PLACED IN ACCORDANCE WITH SUBSECTION 602.06. THESE SPlice LENGTHS SHALL BE INCREASED BY 20% FOR BARS SPACED AT LESS THAN 6" ON CENTER.

BAR SIZE #4 #5 #6 #7 #8 #9 #10 #11

SPlice LENGTH FOR CLASS 0 CONCRETE AND CLASS S40

1'-3" 1'-7" 2'-5" 2'-10" 3'-8" 4'-8" 5'-11" 7'-3"

EXISTING AND BAR SPACING IS 18" OR GREATER ON CENTER.

FOR STRUCTURE NUMBER INSTALLATION, SEE STANDARD 5-614-12.

DESIGN DATA

ASHTO, FOURTH EDITION LRD WITH CURRENT INTERIMS

DESIGN METHOD: LOAD AND RESISTANCE FACTOR DESIGN

LIVE LOAD: R1-93 (DESIGN TRUCK OR TANKER AND DESIGN LANE LOAD)

BEAD LOAD: ASSUMES 36 LBS. PER SQ. FT. FOR BRIDGE DECK OVERLAY UTILITIES: 100 LBS./LN. FT.

REINFORCED CONCRETE:

CLASS 0 CONCRETE: $f'_c = 4,500$ psi

REINFORCING STEEL: $f_y = 60,000$ psi

CLASS 87 CONCRETE: $f'_c = 4,000$ psi

REINFORCING STEEL: $f_y = 60,000$ psi

PRESTRESSED PRECAST CONCRETE: $f'_c = 4,000$ psi

CLASS PS CONCRETE: $f'_c = 270,000$ psi

PRESTRESSING STEEL: $f'_s = 270,000$ psi

CLASS 87 CONCRETE: $f'_c = 4,000$ psi

REINFORCING STEEL: $f_y = 60,000$ psi

PRESTRESSED PRECAST CONCRETE: $f'_c = 4,000$ psi

CLASS PS CONCRETE: $f'_c = 270,000$ psi

PRESTRESSING STEEL: $f'_s = 270,000$ psi

CLASS 87 CONCRETE: $f'_c = 4,000$ psi

REINFORCING STEEL: $f_y = 60,000$ psi

SUMMARY OF QUANTITIES (STRUCTURE NO. C-15-AL)

ITEM NO.	ITEM DESCRIPTION	UNITS	SUPERSUBSTRUCTURE	ABUTMENT 1	ABUTMENT 2	TOTAL
202-00000	REMOVAL OF STRUCTURE	EACH	1			1
206-00000	STRUCTURE EXCAVATION	CY		305	320	625
208-00000	STRUCTURE BACKFILL (CLASS 2)	CY		44	59	103
208-00085	STRUCTURE BACKFILL (FLOWFILL)	CY		95	95	190
403-34751	HOT MK ASPHALT (GRADEING SVO (FS)) (SG 64-28)	TON		1347	1347	2694
503-00030	DRILLED CAISSON (LOD INCH)	LF		79.4	47.9	127.3
506-00209	RIPRAE (9")	CY		6	6	12
515-00120	WATERPROOFING (MEMBRANE)	SY		505.3		505.3
601-03040	CONCRETE CLASS 0 (BRIDGE)	CY		22	22	44
601-05045	CONCRETE CLASS S40	CY		21	21	42
601-40401	STRUCTURAL CONCRETE STAIN	SF		2800		2800
602-00000	REINFORCING STEEL	LB		5334	5334	10668
602-00020	REINFORCING STEEL (EPOXY COATED)	LB		27771	27771	55542
608-11030	BRIDGE RAIL TYPE 10M	LF		267	267	534
613-00200	2 INCH ELECTRICAL CONDUIT	LF		267	267	534
618-00142	PRESTRESSED CONCRETE I (BT42)	LF		267	267	534

INDEX OF DRAWINGS

- BA 1 GENERAL INFORMATION AND SUMMARY OF QUANTITIES
- BA 2 GENERAL LAYOUT
- BA 3 ENGINEERING GEOLOGY
- BA 4 BRIDGE HYDRAULIC INFORMATION
- BA 5 CONSTRUCTION LAYOUT
- BA 6 CAISSON LAYOUT
- BA 7 ABUTMENT 1 DETAILS
- BA 8 ABUTMENT 2 DETAILS
- BA 9 WINDOW WALL DETAILS
- BA 10 BRIDGE DECK DETAILS
- BA 11 PRESTRESSED CONCRETE I (MISC)
- BA 12 PRESTRESSED CONCRETE I (MISC)
- BA 13 PRECAST PANEL DECK FORM (SHEET 1 OF 2)
- BA 14 PRECAST PANEL DECK FORM (SHEET 2 OF 2)
- BA 15 STRUCTURE BACKFILL (FLOWFILL)
- BA 16 BRIDGE RAIL TYPE 10M (MISC)
- BA 17 BRIDGE DECK ELEVATIONS (SHEET 1 OF 4)
- BA 18 BRIDGE DECK ELEVATIONS (SHEET 2 OF 4)
- BA 19 BRIDGE DECK ELEVATIONS (SHEET 3 OF 4)
- BA 20 BRIDGE DECK ELEVATIONS (SHEET 4 OF 4)
- BA 21 BRIDGE DECK ELEVATIONS (SHEET 4 OF 4)




BRIDGE DESCRIPTION


A ONE SPAN (111'-0") BRIDGE WITH PRESTRESSED PRECAST CONCRETE GIRDERS (BT 42'S) OVER THE BIG THOMPSON RIVER WITH A 43'-0" WIDE BRIDGE DECK, 6.3' @ 90' 00" SPAN AND BRIDGE RAIL TYPE 10M.

CROSS REFERENCE DRAWING NUMBER: (SEE PLAN; REFERENCE IS TO SAME SHEET)

SECTION OR DETAIL IDENTIFICATION

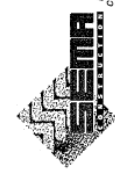

Print Date: 04/13/23	Project No./Code: BR 0341-068
Drawing File Name: P1513	Summary of Quantities: 15548
Horizontal Scale: 85% (AS SHOWN)	Vertical Scale: As Noted
Unit: Feet	Unit Leader: [Signature]
As Constructed: No Revisions 6-30-2010	Revised: [Signature]
Void: [Signature]	Sheet Number: 83
Colorado Department of Transportation	Subcontract: Bridge
2207 EAST HIGHWAY 402 LOVELAND, COLORADO 80037 Phone: 970-467-4670 Fax: 970-689-0289	Subcontract: BA 1 of 21
REGION 4	Sheet Number: 83

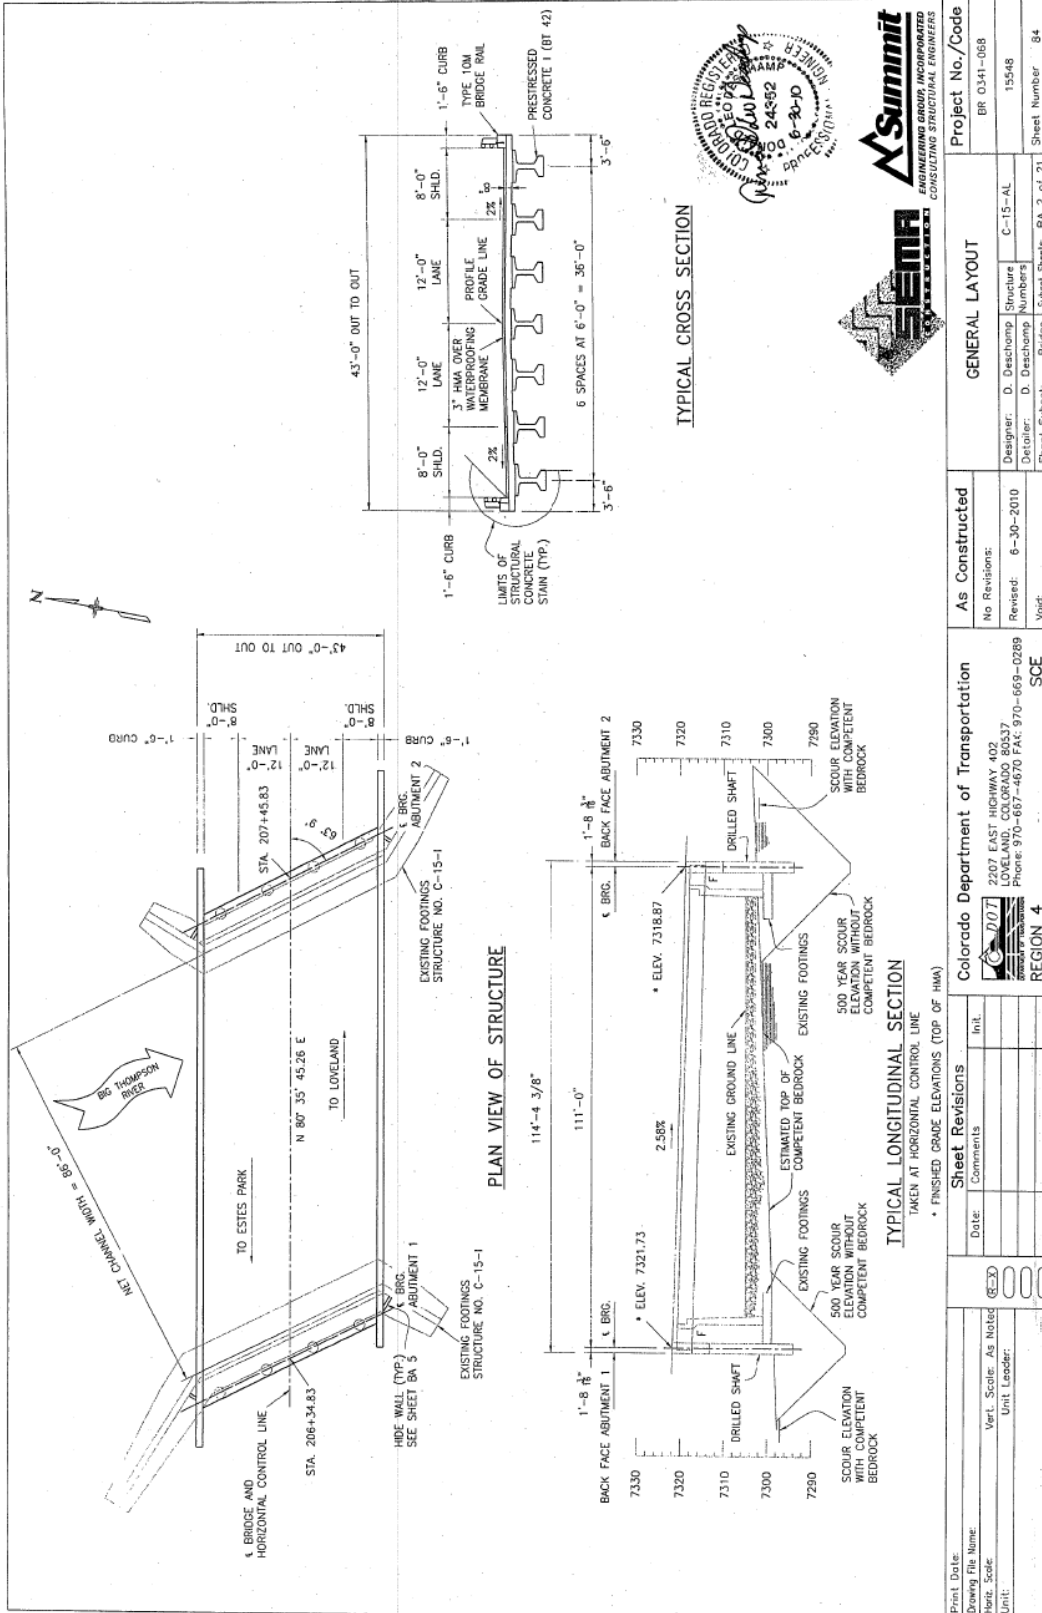

SEMA
Summit
 ENGINEERING GROUP, INCORPORATED
 CONSULTING STRUCTURAL ENGINEERS

GENERAL LAYOUT

As Constructed
 No Revisions:
 Revised: 6-30-2010
 Void:

Colorado Department of Transportation
 2207 EAST HIGHWAY 402
 LOVELAND, COLORADO 80537
 Phone: 970-667-4670 Fax: 970-669-0289
 REGION 4
 SCE

Project No./Code
 BR 0341-068
 15548


Sheet No./Code
 BR 0341-068
 15548

Sheet Revisions

Date	Comments	Init.

Print Date:
Drawing File Name:
Horizontal Scale:
Unit:


Checked By	Date	Checked By	Date
MC	11/09	MC	11/09
MC	11/09	MC	11/09
MC	11/09	MC	11/09

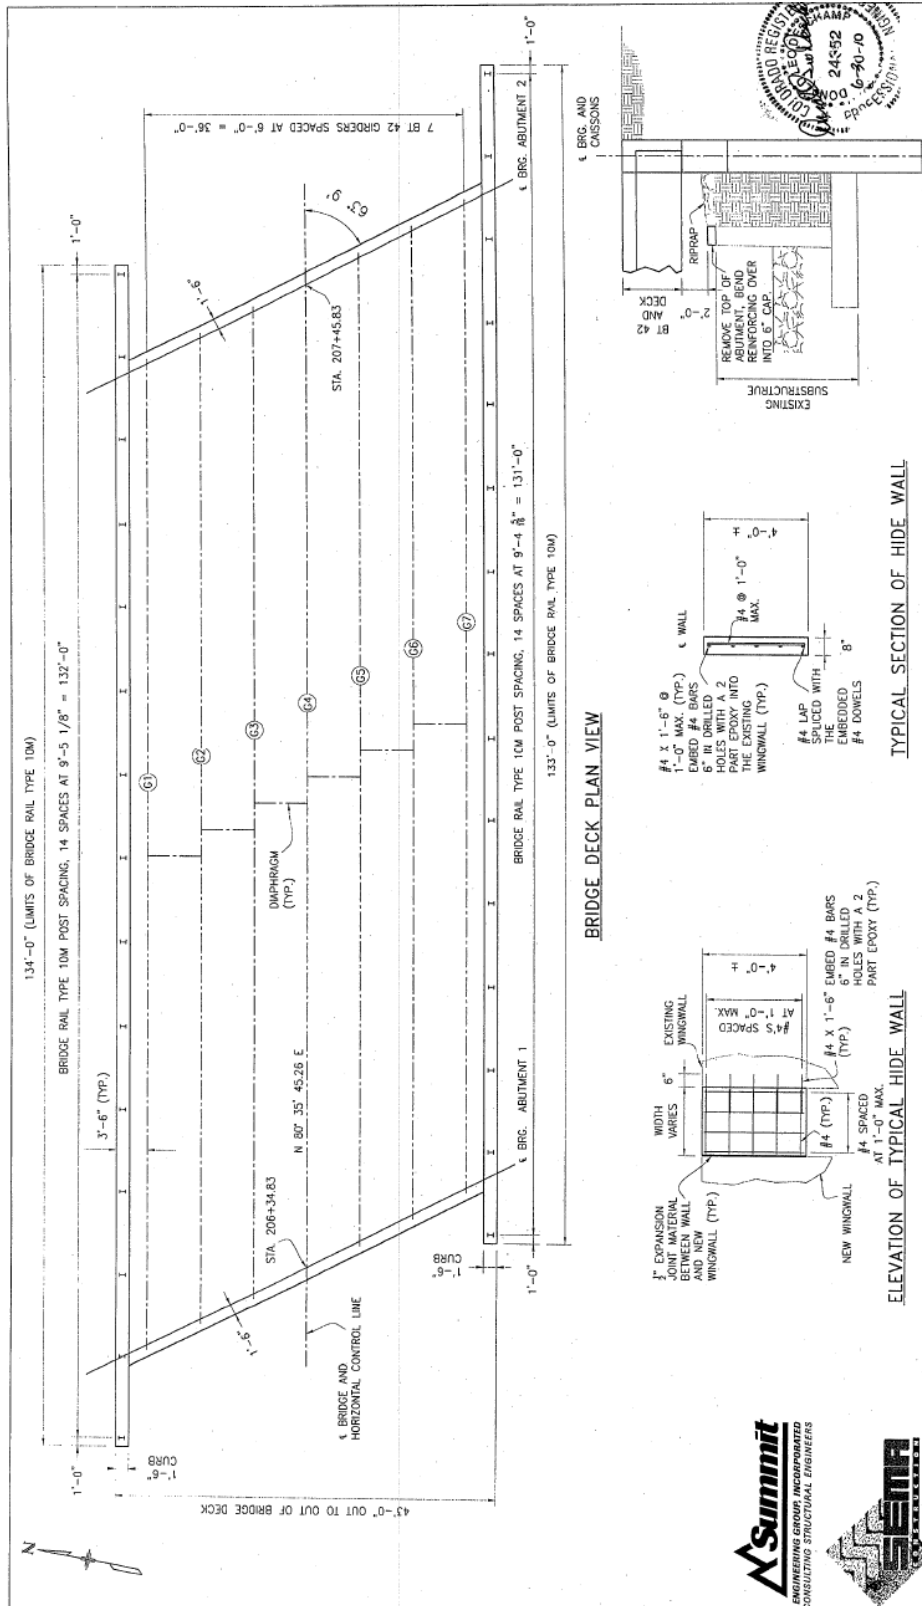

Print Date: \$DATE\$ Drawing File Name: \$FILES\$ Horiz. Scale: ISCALES\$HOR\$ Unit:		Sheet Revisions Date: _____ Comments: _____ Init: _____	Colorado Department of Transportation 2207 EAST HIGHWAY 402 LOVELAND, COLORADO 80537 Phone: 970-567-4670 FAX: 970-669-0289 REGION 4	As Constructed No Revisions: Revised: 6-30-2010 Void:	Project No./Code BR 0341-068 15548 Designer: D. Deschamps Detailer: D. Deschamps Structure Numbers: C-15-AL Sheet Number: 87 Subst. Sheet: Bridge Subst. Sheets: BA 5 of 21
-----------------------------------------------------------------------------------------------	--	------------------------------------------------------------------	--------------------------------------------------------------------------------------------------------------------------------------------------------	----------------------------------------------------------------	--------------------------------------------------------------------------------------------------------------------------------------------------------------------------------------------------




Design	DATE	DESCRIPTION
Checked By	MC	11/08
Designed By	MC	11/08
Checked By	MC	11/08
Designed By	MC	11/08
Checked By	MC	11/08
Designed By	MC	11/08
Checked By	MC	11/08
Designed By	MC	11/08

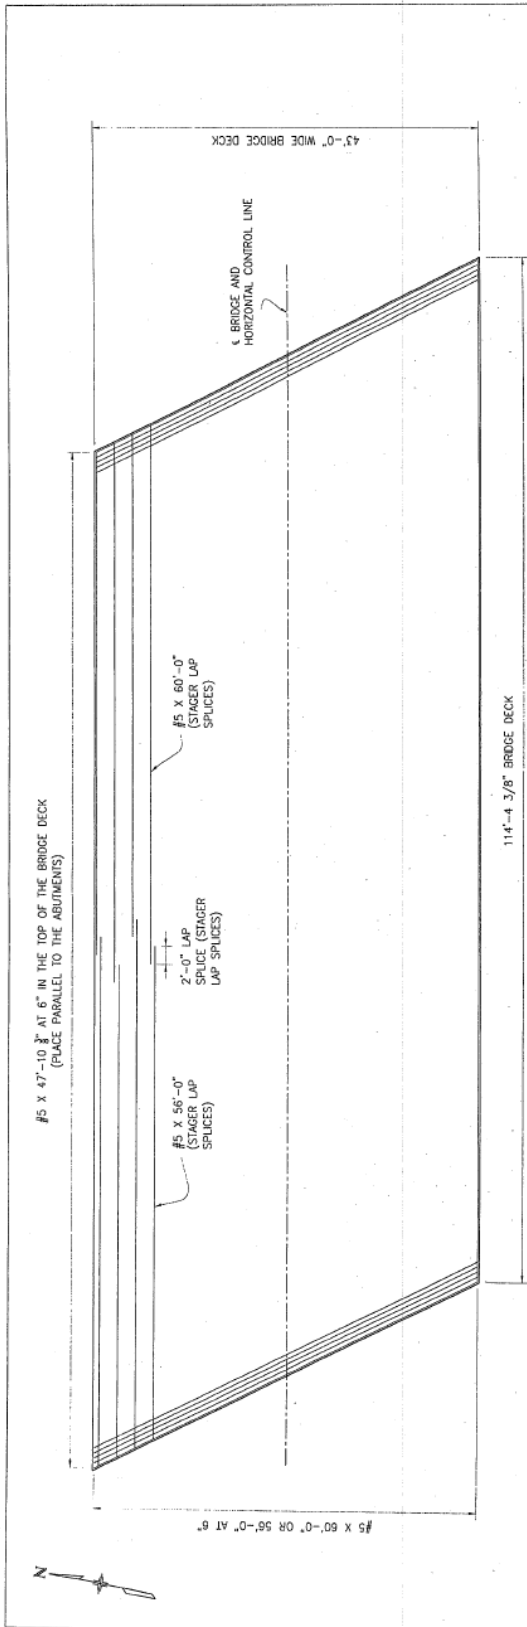

BRIDGE DECK PLAN VIEW

NOTES
 THE BRIDGE DECK CONCRETE SHALL BE CONCRETE CLASS 304.
 THE BRIDGE DECK HAS BEEN DESIGNED FOR AN I.C. OF 100 PSI. THE CONCRETE SHALL BE AT LEAST 10% OVERSTRENGTH WHEN THE CONCRETE HAS ATTAINED A MINIMUM FIELD COMPRESSIVE STRENGTH OF 4500 PSI AND IT HAS CURED FOR A MINIMUM OF 5 DAYS. THE BRIDGE DECK SHALL BE CURING COVERED FROM TEST CYLINDERS MADE AND CURED AT THE STRUCTURE SITE IN ACCORDANCE WITH ASTM C 318 AND TESTED IN ACCORDANCE WITH ASTM C 22 OR A SIMILAR TEST METHOD ESTABLISHED IN ACCORDANCE WITH THE SPECIFICATIONS.
 FOR BRIDGE RAIL REINFORCING SEE THE BRIDGE RAIL TYPE 10M DRAWINGS.

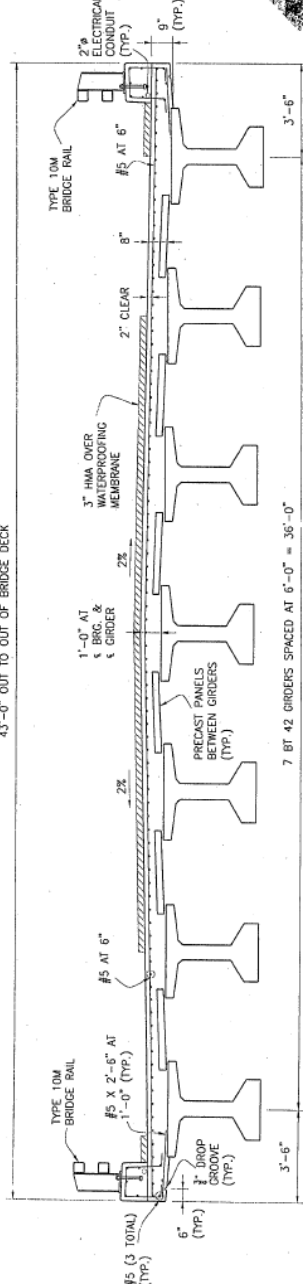

TYPICAL BRIDGE CROSS SECTION




Print Date: \$DATE\$	As Constructed	Project No./Code
Drawing File Name: \$FILES\$	No Revisions: 6-30-2010	BR 0341-068
Horiz. Scale: \$SCALEHORIZ\$	Revised:	BR 0341-068
Unit:	Void:	15548
Design: D. Deschamps	Structure Numbers	C-15-AL
Detailer: D. Deschamps	Bridge Subsets	BR 0341-068
Sheet Subsets: Bridge	Sheet Number	92
Sheet Subsets: BA 10 of 21		

Colorado Department of Transportation
 2207 EAST HIGHWAY 60, SUITE 317
 Phone: 970-667-4670 FAX: 970-669-0289
 REGION 4


Sheet Revisions	Date:	Comments

Design	DATE	DATE	DATE
Checked By:	11/23	11/23	11/23
Created By:	11/23	11/23	11/23
Checked By:	11/23	11/23	11/23
Created By:	11/23	11/23	11/23
Checked By:	11/23	11/23	11/23
Created By:	11/23	11/23	11/23

DESIGNED BY	MC 12/08	CHECKED BY	MC 12/08
DRAWN BY	MC 12/08	DATE	12/08
DATE	12/08	DATE	12/08
DATE	12/08	DATE	12/08
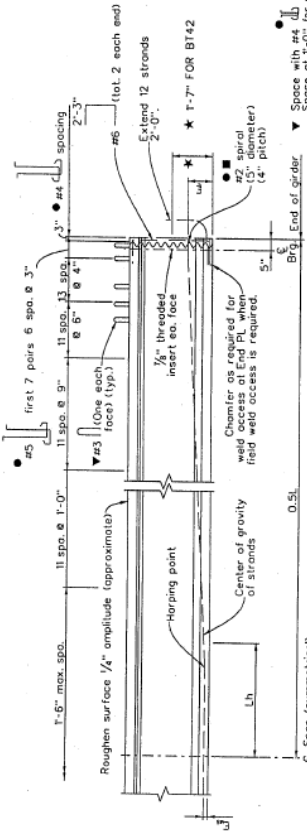

GIRDER ELEVATION
The Contractor may submit an alternate cross tie arrangement, at the end of the web, for approval by the Engineer.

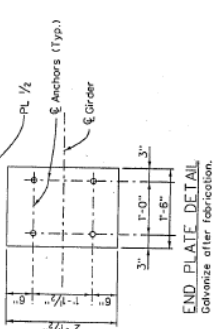

GIRDER SCHEDULE

Girder No.	Span No.	L (feet)	Lh (feet)	A _{sc} (square inch)	E _{sp} (inch)	E _w (inch)	F _y (ksi)	F _t (ksi)	F _w (ksi)	Concrete Strength (psi)	Predicted Release Comber (inch)	Predicted Comber (inch)	
B1 42	1	111.83	11.2	8.68	5.2	13.6	1758	1240	7000	9000	3.5	3.4	6.5

TYPICAL GIRDER SECTION
A - girder depth - 3' - 3 3/4"

END PLATE DETAIL
Galvanize after fabrication.

NOTES:

Always necessary to fabricate and install the integral parts of the girder (including the intermediate diaphragms, 1/4" threaded rods, and leveling plates), as shown on the plans, shall be included in the bill of materials. The weight of these items shall be measured with a pay unit of feet which shall be measured by dimension L.

When approved by the Engineer, a minimum of tack welding will be permitted on ASTM A706 weather reinforcing steel.

Reinforcing projecting from the top of the girder and reinforcing epoxy coated. Damaged coating on girder reinforcing need not be repaired. The minimum cover for reinforcing steels 1".

At girder ends not embedded in concrete diaphragms, cut strands off 1" below the surface of the concrete and finish with an approved epoxy coating. The epoxy coating shall be applied to the strands (to project 3" except as shown. Do not make cosmetic repairs (damage less than 1/2" deep) to the parts of the girders embedded in concrete.

Use low relaxation strands meeting the requirements of ASTM A-416 Grade 270 with a minimum clear distance between groups or individual strands of 1/4". The minimum cover for prestressing steels 1/2".

A minimum of two bearing points shall be used per girder. Hazard strands shall be welded/distributed at the girder ends, starting within 4" of the top of the girder and distributed such that there is no space between strands. The Contractor may place #4 x 10'-0" in the sides of the end of the web parallel to the bearing strands such that there is no space greater than 1'-0".

A** - minimum area of the prestressing steel.
 d - nominal strand diameter (assumed 0.6 inch diameter).
 F_y - yielding strength of prestressing steel.
 F_t - tensile strength of prestressing steel.
 F_w - working force per girder.
 F_u - ultimate force per girder.
 F_v - required concrete strength at 28 days of age.
 L - length of girder along the grade of the girder.
 Δ - section modulus of girder due to cast-in-place slab, diaphragms, asphalt, curb, rails and road.

Concrete shall be Class PS.

Entrained air is not required for girder concrete.



Use 1/2" chamfer on all corners, except as noted.

Predicted comber is the comber for the girder alone at 30 days. The predicted comber plus 1" prior to the deck pour by weighing, scheduling fabrication, post tensioning, or other means and must report to the Engineer. Remedial measures, as approved by the Engineer, shall be taken if the predicted comber plus 1" is exceeded. The approved remedial measures shall be free of any impact on the structure. The cost associated with all remedial measures shall be borne by the Contractor.




Project No./Code	PRESTRESSED CONCRETE I	
BR 341-068	Structure Numbers	C-15-AL
Designer: D. DESCHAMP	Detailer: D. DESCHAMP	Sheet Number: 93
As Constructed	No. Revisions: 6-30-2010	Revised: Void
Colorado Department of Transportation		
2207 EAST HIGHWAY 402		
LOVELAND, COLORADO 80537		
Phone: 970-687-1670 FAX: 970-689-0289		
REGION 4 SCE		
Sheet Revisions	Date:	Comments
Print Date: 30/ATE5		
Drawing File Name: PLE53		
Plot Scale: SCALE: 1/8" = 1'-0"	Vert. Scale: As Noted	
Unit Information		
Unit Leader initials		

Design	DATE	BY	CHECKED BY	DATE
Checked By: MC	12/09	Checked By: MC	12/09	12/09
Checked By: D.O.	12/09	Checked By: D.O.	12/09	12/09
Checked By: MC	12/09	Checked By: MC	12/09	12/09
Checked By: D.O.	12/09	Checked By: D.O.	12/09	12/09
Checked By: MC	12/09	Checked By: MC	12/09	12/09
Checked By: D.O.	12/09	Checked By: D.O.	12/09	12/09

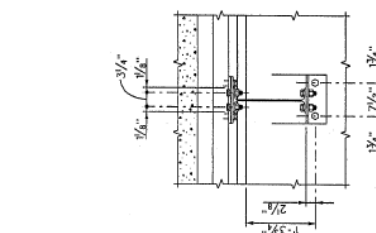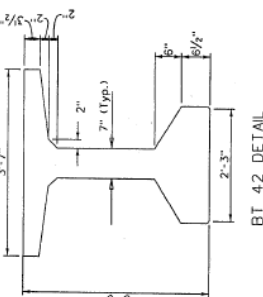

SECTION A-A

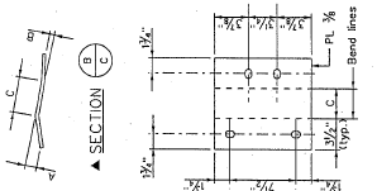


SECTION B-B




SECTION C-C

PLAN (Before bending) PLATE DETAIL

NOTES
 All diaphragm materials, including bolts, nuts, and washers shall be galvanized.
 * If the construction layout does not specify diaphragms, there shall be at least one diaphragm at mid span.
 Bolts, nuts and lock washers may be zinc plated in lieu of being galvanized.
 ▲ Dimensions A, B and C shall be shown on the shop drawings.
 The diaphragms may be placed on a skew such that they are between 90° and 100° to the girders. Additionally, all diaphragms shall be installed level.
 The Contractor is responsible for determining necessary bracing requirements and for providing adequate bracing for the specific wind and weather conditions to be encountered for each specific project.
 When bracing or diaphragms are required, no girders shall be used to support the intermediate diaphragms. When used, girders shall be connected to the adjacent girders simultaneously with the erection of the girders.
 Use and installation of the intermediate diaphragms shall not relieve the Contractor of full responsibility to construct the work in a manner which provides adequate bracing for the structure and girders under the finished structure the lines and grades indicated on the plans.

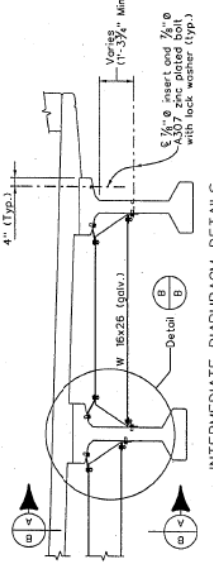

INTERMEDIATE DIAPHRAGM DETAILS
 * For location of diaphragms, see Construction Layout.

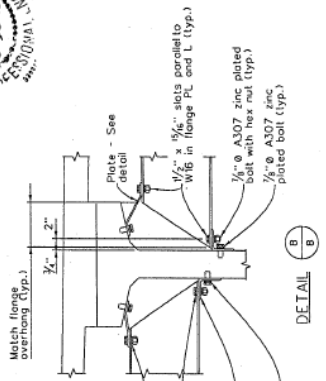


DETAIL B-B



Print Date: 8/21/15	Project No./Code: BR 0341-068
Drawn File Name: BELLES	PRESTRESSED CONCRETE I (MISC.)
North Scale: 1/8"=1'-0"	Designer: D. DESCHAMP
Unit Information:	Structure: C-15-AL
	Detailer: D. DESCHAMP
	Numbers: 15548
	Sheet Subset: Bridge
	Sheet No.: 94
	Sheet No. of 21
As Constructed: 6-30-2010	Revised:
Revisions:	Void:
Sheet Revisions:	Date:
Comments:	Comments:
Colorado Department of Transportation	REGION 4
2207 EAST HIGHWAY 402	LOVELAND, COLORADO 80537
Phone: 970-667-4670 FAX: 970-669-0289	SCE


Checked By: MC	12/08	Checked By: MC	12/08	Checked By: MC	12/08	Checked By: MC	12/08	Checked By: MC	12/08
Checked By: DLD	12/08	Checked By: DLD	12/08	Checked By: DLD	12/08	Checked By: DLD	12/08	Checked By: DLD	12/08
Checked By: M	12/08	Checked By: M	12/08	Checked By: M	12/08	Checked By: M	12/08	Checked By: M	12/08
Checked By: J/94	3/99	Checked By: J/94	3/99	Checked By: J/94	3/99	Checked By: J/94	3/99	Checked By: J/94	3/99
Checked By: 2/03	12/91	Checked By: 2/03	12/91	Checked By: 2/03	12/91	Checked By: 2/03	12/91	Checked By: 2/03	12/91
Checked By: 12/91	12/91	Checked By: 12/91	12/91	Checked By: 12/91	12/91	Checked By: 12/91	12/91	Checked By: 12/91	12/91
Checked By: 12/08	12/08	Checked By: 12/08	12/08	Checked By: 12/08	12/08	Checked By: 12/08	12/08	Checked By: 12/08	12/08

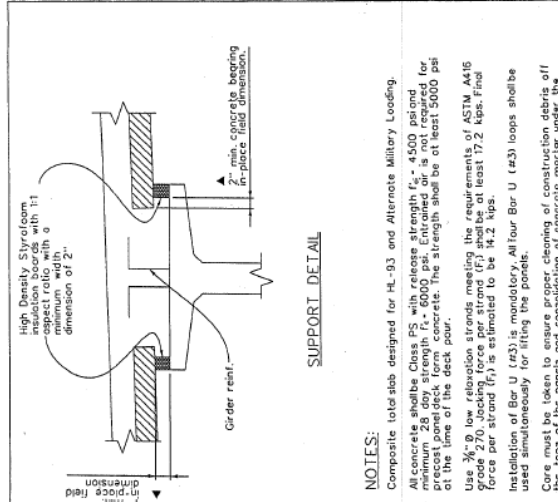

SUPPORT DETAIL

NOTES:

Composite slab designed for HL-93 and Alternate Military Loading. All concrete shall be Class F5 with release strength $f_c = 4500$ psi and minimum 28 day strength $f_c = 6000$ psi. Unrestrained air is not to exceed 0.015 at the time of the deck pour. Use 3/8" low relaxation strands meeting the requirements of ASTM A416 grade 270. Lacking force per strand (F_s) shall be at least 17.2 kips. Final force per strand (F_r) is estimated to be 14.2 kips. Installation of Bar U (#3) is mandatory. All four Bar U (#3) loops shall be used simultaneously for lifting the panels. Care must be taken to ensure proper cleaning of construction debris off the tops of the panels and consolidation of concrete mortar under the panels. The contractor is responsible for providing adequate space to fit the adequate space (Δ min. 1" x 2") is provided for the concrete to fit the space under the panels the slab concrete is placed. Panels shall be cast and width shall be determined by the contractor and shown on the shop plans. The Contractor is responsible for the stability of the panels on the girders. The Contractor is responsible for meeting the total slab thickness shown on the Superstructure Details.

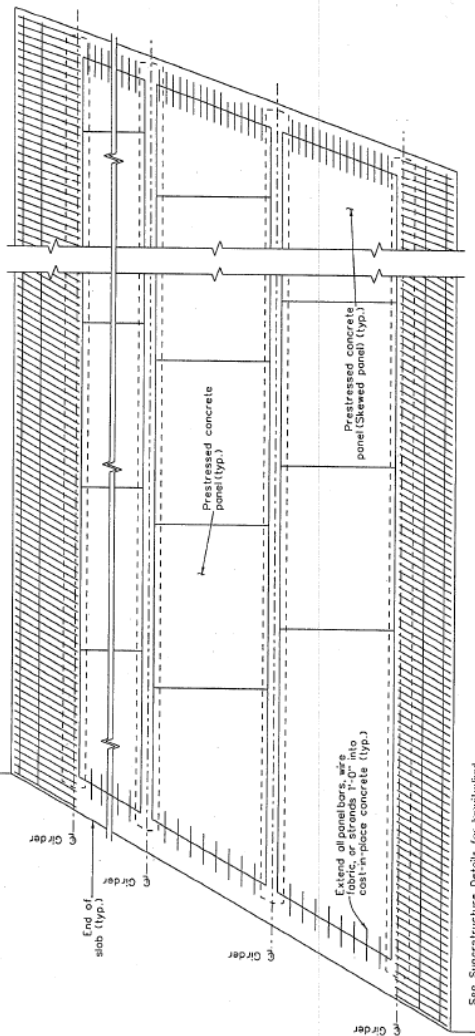

PART PLAN



Print Date: 8/24/08
Drawing File Name: FILE33
Horiz. Scale: 1/8"=1'-0"
Unit Information: Unit Leader Initials

Sheet Revisions

Date:	Comments	Rev.

Colorado Department of Transportation
2207 EAST HIGHWAY 402
LOVELAND, COLORADO 80537
Phone: 970-667-4670 FAX: 970-669-0289
REGION 4 SCE

AS Constructed
No Revisions: 6-30-2010
Revised:
Void:

PRECAST PANEL DECK FORM
(SHEET 2 of 2)

Project No./Code
BR 0341-068
Designer: D. DESCHAMP
Structure Numbers: C-15-AL
Detailer: D. DESCHAMP
Sheet Number: 96
Sheet Subset: Bridge Subset Sheets BA 14 of 21

C-15-O Construction Drawings

GENERAL NOTES

BEFORE AS SHOWN IN THE PLANS, STRAIGHTENING, EROSION AND BACKFILL SHALL BE IN ACCORDANCE WITH M-206P-1 FOR CAST-IN-PLACE RETAINING WALLS.

EXPANSION JOINT MATERIAL SHALL MEET ASTM SPECIFICATION M-211.

A COLORED STRUCTURAL CONCRETE COATING FINISH WILL BE REQUIRED AS SHOWN ON THE PLANS. 2565B COLOR NO. 33446, AND IS TO BE SELECTED FROM TEST PANELS PROVIDED BY THE CONTRACTOR.

GRADE 60 REINFORCING STEEL IS REQUIRED.

ALL REINFORCING STEEL SHALL BE EPOXY COATED UNLESS OTHERWISE NOTED.

THE FOLLOWING TABLE GIVES THE MINIMUM LAP SPlice LENGTH FOR EPOXY COATED REINFORCING BARS PLACED IN ACCORDANCE WITH SUBSECTION 802.06. THESE SPlice LENGTHS SHALL BE INCREASED BY 25% FOR BARS SPACED AT LESS THAN 6" ON CENTER.

BAR SIZE	#4	#5	#6	#7	#8	#9	#10	#11
SPlice LENGTH FOR CLASS D CONCRETE	1'-3"	1'-5"	1'-10"	2'-2"	3'-8"	4'-8"	5'-11"	7'-3"

WHEN THE CONTRACTOR ELECTS TO SUBSTITUTE EPOXY COATED REINFORCEMENT FOR BLACK REINFORCING BARS, THE MINIMUM LAP SPlice LENGTH SHALL BE AS DESCRIBED ABOVE.

THE FOLLOWING TABLE GIVES THE MINIMUM LAP SPlice LENGTH FOR BLACK REINFORCING BARS PLACED IN ACCORDANCE WITH SUBSECTION 802.06. THESE SPlice LENGTHS SHALL BE INCREASED BY 25% FOR BARS SPACED AT LESS THAN 6" ON CENTER.

BAR SIZE	#4	#5	#6	#7	#8	#9	#10	#11
SPlice LENGTH FOR CLASS D CONCRETE	1'-0"	1'-4"	1'-7"	1'-10"	2'-5"	3'-1"	3'-11"	4'-10"

THE ABOVE SPlice LENGTHS SHALL BE INCREASED BY 20 PERCENT FOR 3 BAR BUNDLES AND 33 PERCENT FOR 4 BAR BUNDLES.

THE CONTRACTOR SHALL BE RESPONSIBLE FOR THE STABILITY OF THE STRUCTURE DURING CONSTRUCTION.

B.F. = BACK FACE
H.F. = HEAD FACE
F.F. = FILL FACE
N.F. = NON-FACE

PERMANENT BECK FORMS ~~NON-PERMANENT~~ **WERE USED**

FOR STRUCTURE NUMBER INSTALLATION, SEE STANDARD S-114-12.

STAIRS, ELEVATIONS, AND DIMENSIONS CONTAINED IN THESE PLANS ARE CALCULATED FROM A CENTERLINE OF GRADE. CONTRACTOR SHALL VERIFY ALL DIMENSIONAL MEASUREMENTS IN THE FIELD BEFORE ORDERING OR FABRICATING ANY MATERIAL.

THE INFORMATION SHOWN ON THESE PLANS CONCERNING THE TYPE AND LOCATION OF UNDERGROUND UTILITIES IS NOT GUARANTEED TO BE ACCURATE. THE CONTRACTOR IS RESPONSIBLE FOR MAKING HIS OWN DETERMINATIONS AS TO THE LOCATION AND DEPTH OF ALL UTILITIES AS SHOWN ON THESE PLANS. THE CONTRACTOR SHALL CONTACT THE UTILITIES AS NOTIFIED BY THE UTILITY COMPANIES AT LEAST 14 DAYS PRIOR TO THE START OF CONSTRUCTION. NOTIFICATION CENTER OF COLORADO AT 1-800-992-1887 AT LEAST 2 DAYS (NOT INCLUDING THE DAY OF NOTIFICATION) PRIOR TO ANY EXCAVATION OR OTHER EARTHWORK.

INDEX OF DRAWINGS

- B 01 General Information
- B 02 Summary of Quantities
- B 03 General Layout
- B 04 Engineering Geology Sit 34 Crossing Big Thompson River
- B 05 Bridge Hydraulic Information
- B 06 Bridge Hydraulic Information Details
- B 07 Construction Layout
- B 08 Foundation Plan
- B 09 Foundation Details
- B 10 Abutment 1 Details
- B 11 Abutment 2 Details
- B 12 Abutment 3 Details
- B 13 Wingwall Details
- B 14 Retaining Walls A, B, and C
- B 15 Retaining Wall Details (1 of 2)
- B 16 Retaining Wall Details (2 of 2)
- B 17 See Wall Details
- B 18 Pier 2 Details (1 of 3)
- B 19 Pier 2 Details (2 of 3)
- B 20 Pier 2 Details (3 of 3)
- B 21 Superstructure Details (1 of 3)
- B 22 Superstructure Details (2 of 3)
- B 23 Superstructure Details (3 of 3)
- B 24 Precast Box Girder Details
- B 25 Precast Panel Deck Forms (Optional)
- B 26 Precast Panel Deck Forms (Optional)
- B 27 Approach Slab Details (1 of 2)
- B 28 Approach Slab Details (2 of 2)
- B 29 Bridge Expansion Device (E-4)
- B 30 Bridge Expansion Device (E-4) (Tech)
- B 31 Bridge Rail Type 10M (1 of 4)
- B 32 Bridge Rail Type 10M (2 of 4)
- B 33 Bridge Rail Type 10M (3 of 4)
- B 34 Bridge Rail Type 10M (4 of 4)
- B 35 Excavation and Backfill for Bridges in Fill
- B 36 Excavation and Backfill for Bridges in Cut
- B 37 Mechanically Stabilized Earthfill
- B 38 Decking Mechanical And Electrical Vault
- B 39 Bridge Deck Elevations (1 of 8)
- B 40 Bridge Deck Elevations (2 of 8)
- B 41 Bridge Deck Elevations (3 of 8)
- B 42 Bridge Deck Elevations (4 of 8)
- B 43 Bridge Deck Elevations (5 of 8)
- B 44 Bridge Deck Elevations (6 of 8)
- B 45 Bridge Deck Elevations (7 of 8)
- B 46 Bridge Deck Elevations (8 of 8)

BRIDGE DESIGN DATA

ASHTO, SECOND EDITION LRFD WITH 2000 INTERIMS

DESIGN METHOD: LOAD AND RESISTANCE FACTOR DESIGN

TRAFFIC LOAD: HS-20 DESIGN TRUCK OR TANDEN, AND DESIGN LANE LOAD

LEAD LOAD: ASSUMES 38 LBS. PER SQ. FT. FOR BRIDGE DECK OVERLAY

ASSUMES 5 LBS. PER SQ. FT. FOR PERMANENT STEEL DECK FORMS

REINFORCED CONCRETE (BRIDGE)

CLASS D CONCRETE: $f'_c = 4,500$ psi

REINFORCING STEEL: $f_y = 60,000$ psi

CLASS B2 CONCRETE: $f'_c = 4,000$ psi

REINFORCING STEEL: $f_y = 60,000$ psi

CLASS 3 CONCRETE: $f'_c = 4,000$ psi

REINFORCING STEEL: $f_y = 60,000$ psi

SEA WALL DESIGN DATA

DESIGN METHOD: LOAD AND RESISTANCE FACTOR DESIGN

EQUIVALENT FLUID PRESSURE = 60.0 LB/FT.

CLASS D CONCRETE: $f'_c = 4,500$ psi

LIVE LOAD SURCHARGE = 2 FT.


BRIDGE DESCRIPTION

2-Span Bridge, 66'-11.5"
64'-5.5" Concrete Box and
Prestressed Box Girder, Continuous.
Over Big Thompson River, on U.S.
Highway 40, 40'-0" Curb to Curb,
45'-0" to 47'-0" Slew, Bridge,
Rail Type 10M.

CROSS-REFERENCE DRAWING NUMBER
(IF BLANK, REFERENCE IS TO SAME SHEET)
SECTION OR DETAIL IDENTIFICATION

Computer File Information		Sheet Revisions		As Constructed		GENERAL INFORMATION	
Creation Date:	11/25/89	7-3-01	Revised notes	No Revisions:		Project No./Code	BR 0341-053
Last Modification Date:	07/02/01			Revised:	4/13/04	Designer:	A. Herzog/Structure
Full Path:	C:\13488-PROJ\4VC-15-O\			Revised:		Reviser:	T. Gowers/Number
Drawing File Name:	07Zerc.dwg			Year:		Sheet Submitter:	Bridge
Assoc. Ver.:	13.0	Scale:	Scale varies	Unit:	Feet	Sheet Number:	28
						Subtotal Sheets:	B1 of 46

Colorado Department of Transportation		Design and Construction	
4201 East Arapahoe Avenue, Room 300 Denver, Colorado 80202 Phone: 303-757-3392 FAX: 303-757-9197		From Station 19+83.75 To Station 19+89.17	

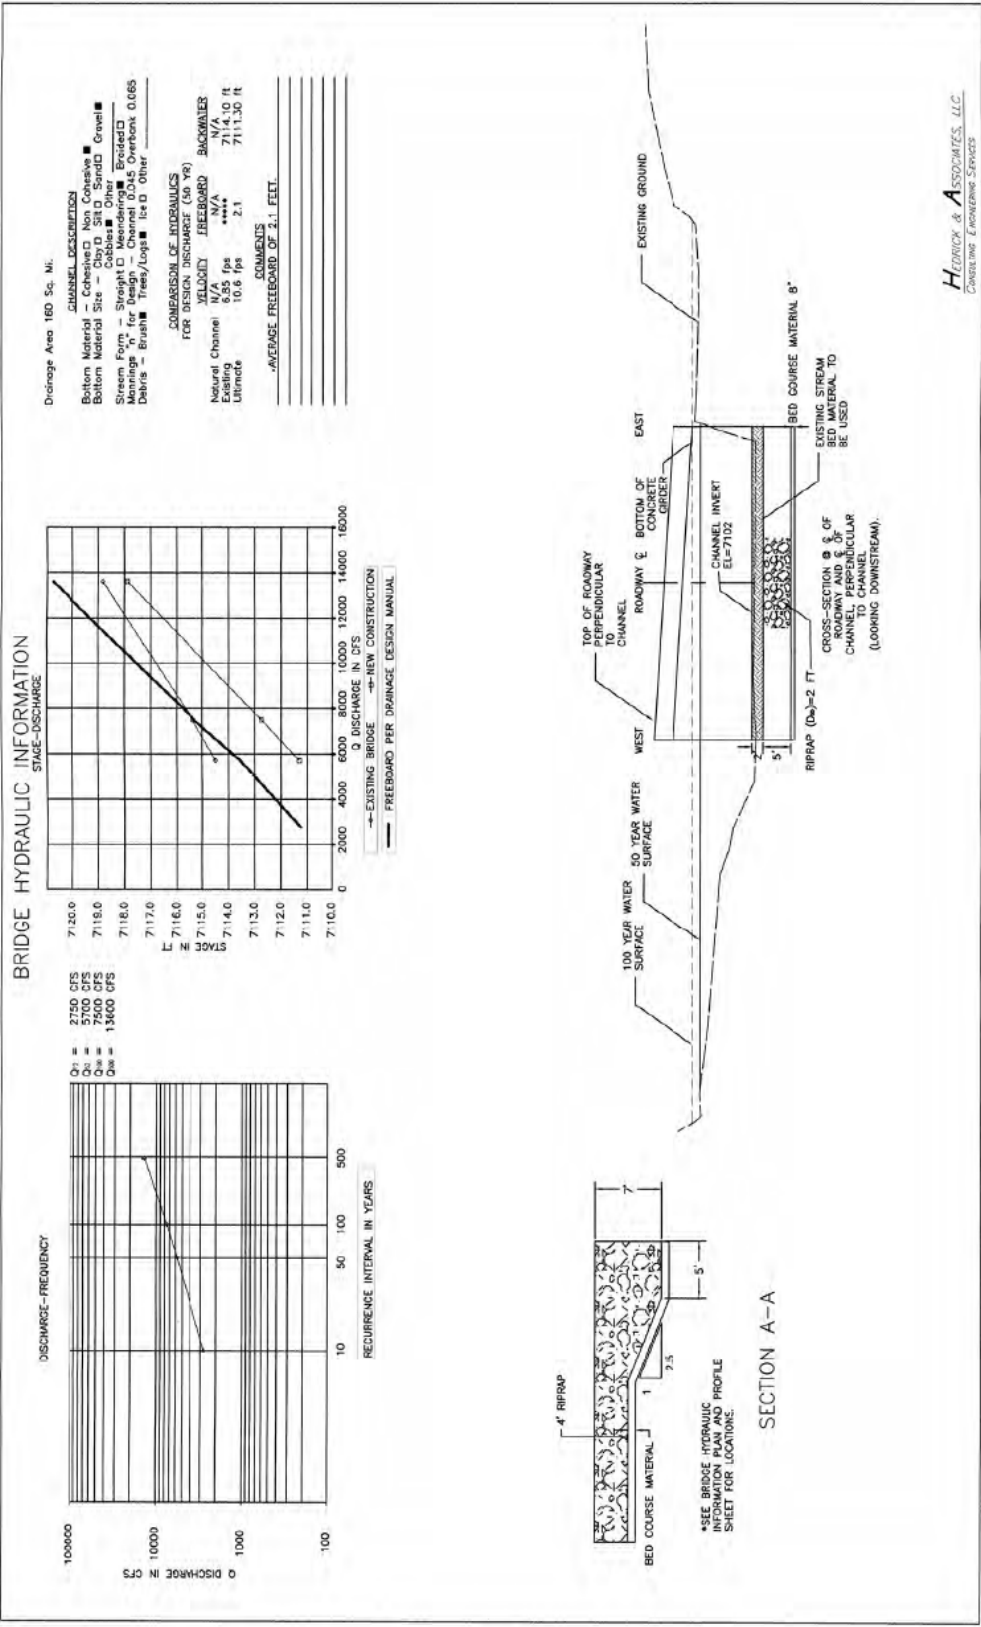

Computer File Information		Sheet Revisions		As Constructed		BRIDGE HYDRAULIC INFORMATION		Project No./Code	
Creation Date:	06/01/00	Rev:	06/01/00	No. Revisions:	1	Designer:	C. DRESEN	Structure:	C-15-0
Last Modification Date:	1/13/2001	Rev:	06/01/00	Revised:	mm/dd/yy	Drafter:	C. DRESEN	E. SAN Numbers:	C-15-H (old)
Full Path:	\\MPS4\SHD4_Big_Thompson\VC_15_H\cwg	Rev:	06/01/00	Revised:	mm/dd/yy	Checker:	C. DRESEN	Sheet Number:	34
Drawing File Name:	br_Ju-hyd1.dwg	Rev:	06/01/00	Revised:	mm/dd/yy	Sheet Subst:	BRIDGE	Subst Sheet:	807 of 39
App. Ver.:	R14	Rev:	06/01/00	Revised:	mm/dd/yy	Colorado Department of Transportation Region 4 - Loveland Residency 2207 East Highway 402 Loveland, Colorado 80537 Phone: 970-687-6976 FAX: 970-669-9189 S.C.E. Reg. or. 4			
Code:	AS SHOWN	Units:	English						

SECTION A-A

*SEE BRIDGE HYDRAULIC INFORMATION PLAN AND PROFILE SHEET FOR LOCATIONS.

RIPRAP (D₅₀) = 2 FT

BED COURSE MATERIAL 8"

EXISTING STREAM BED MATERIAL TO BE USED

CROSS-SECTION @ 1/2 OF CHANNEL PERPENDICULAR TO CHANNEL (LOOKING DOWNSTREAM)

TOP OF ROADWAY PERPENDICULAR TO CHANNEL

ROADWAY @ BOTTOM OF CONCRETE GRIBER

CHANNEL INVERT EL=7102

100 YEAR WATER SURFACE

50 YEAR WATER SURFACE


WEST

EAST

EXISTING GROUND

LEGEND: --- EXISTING BRIDGE DISCHARGE IN OLD CONSTRUCTION
 ——— FREEBOARD PER DRAINAGE DESIGN MANUAL

HEDRICK & ASSOCIATES, LLC
CONSULTING ENGINEERING SERVICES

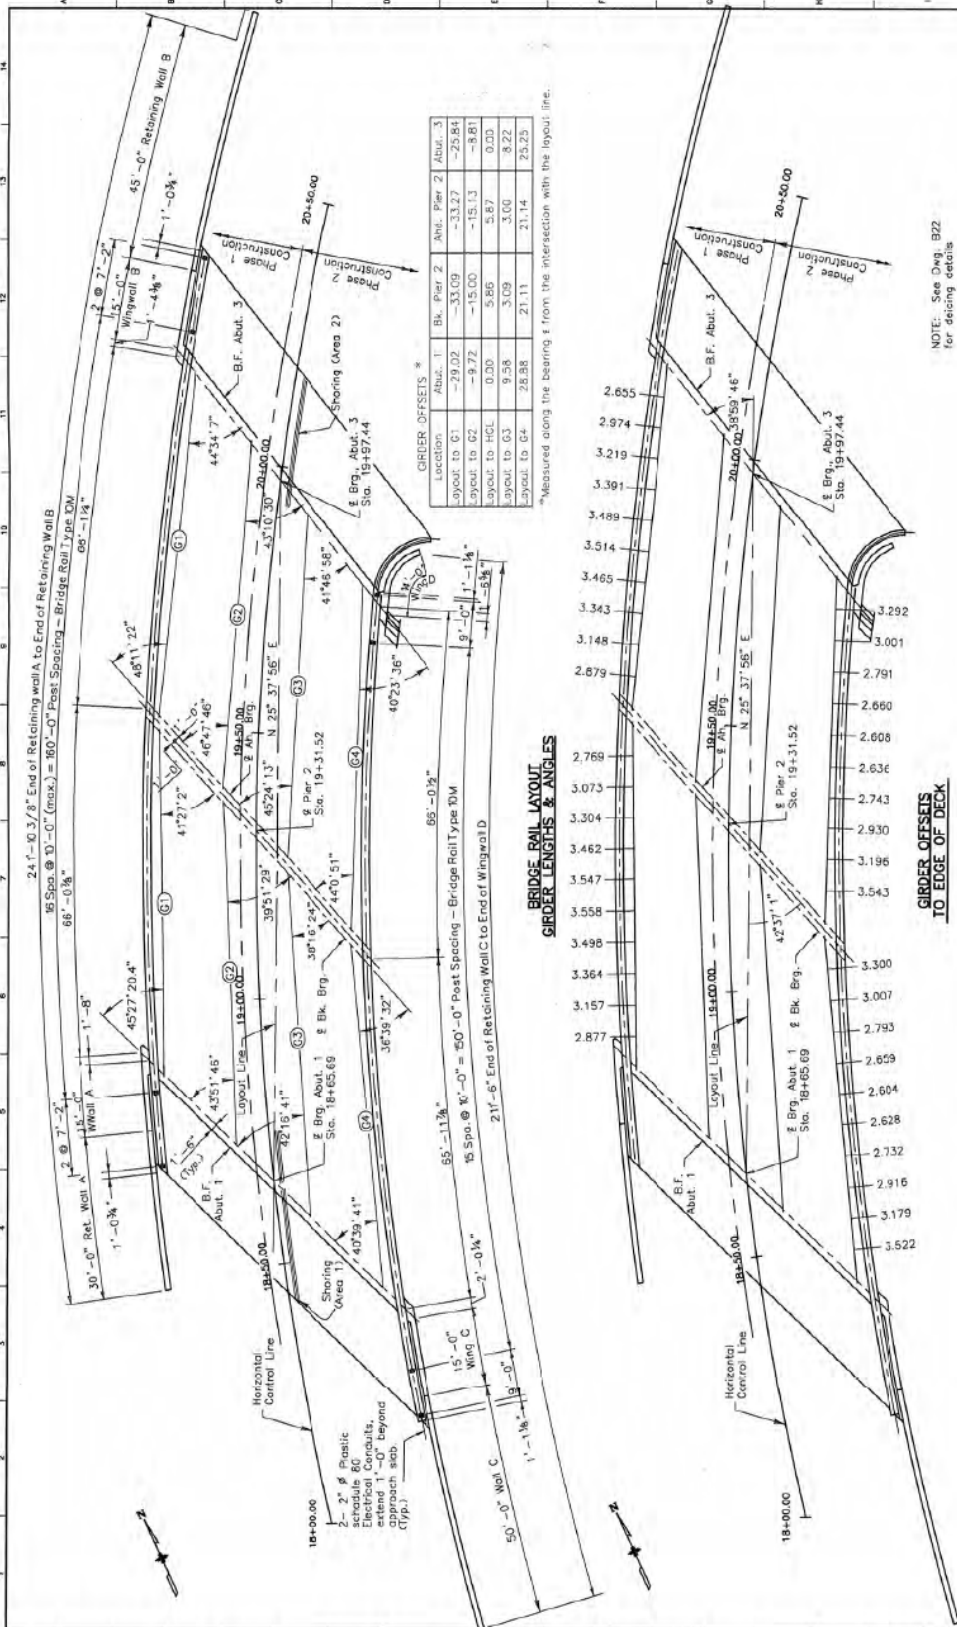


GIRDER OFFSETS *			
Location	Abut. 1	Bk. Pier 2	Abut. 3
Layout to G1	-29.02	-33.09	-25.84
Layout to G2	-9.72	-15.00	-8.81
Layout to HCL	0.00	5.86	0.00
Layout to G3	9.58	3.09	3.00
Layout to G4	28.38	21.13	23.25

*Measured along the bearing ± from the intersection with the layout line.

NOTE: See Dwg. B22 for detailing details


Computer File Information Creation Date: 01/89 Last Modification Date: 05/01/01 Full Path: C:\Pro_S\SH\341m\br from Term\15-0 Drawing File Name: 08ccr01a.dwg Acad Ver.: 15.0		Sheet Revisions 0000		As Constructed No Revisions <i>12/04</i> Review:		CONSTRUCTION LAYOUT Designer: A. Hoag Drafter: T. Edwards Sheet No.: 11 BIDD# Sublet Sheets: B 8 of 48		Project No./Code BR 0341-053 13488 Sheet Number	
Colorado Department of Transportation 4201 East Arkansas Avenue, Room 330 Denver, Colorado 80222-3400 Phone: 303-797-3552 Fax: 303-757-9197				Design and Construction		35		35	

DESIGN	DATE	BY	CHECKED BY	DATE	QUANTITIES
Checked by	A.H.	08/00	Checked by	T.O.E.	08/01
Checked by	S.H.D.	01/01	Checked by	T.O.E.	08/01
Checked by	J.S.V.	01/01	Checked by	T.O.E.	08/01


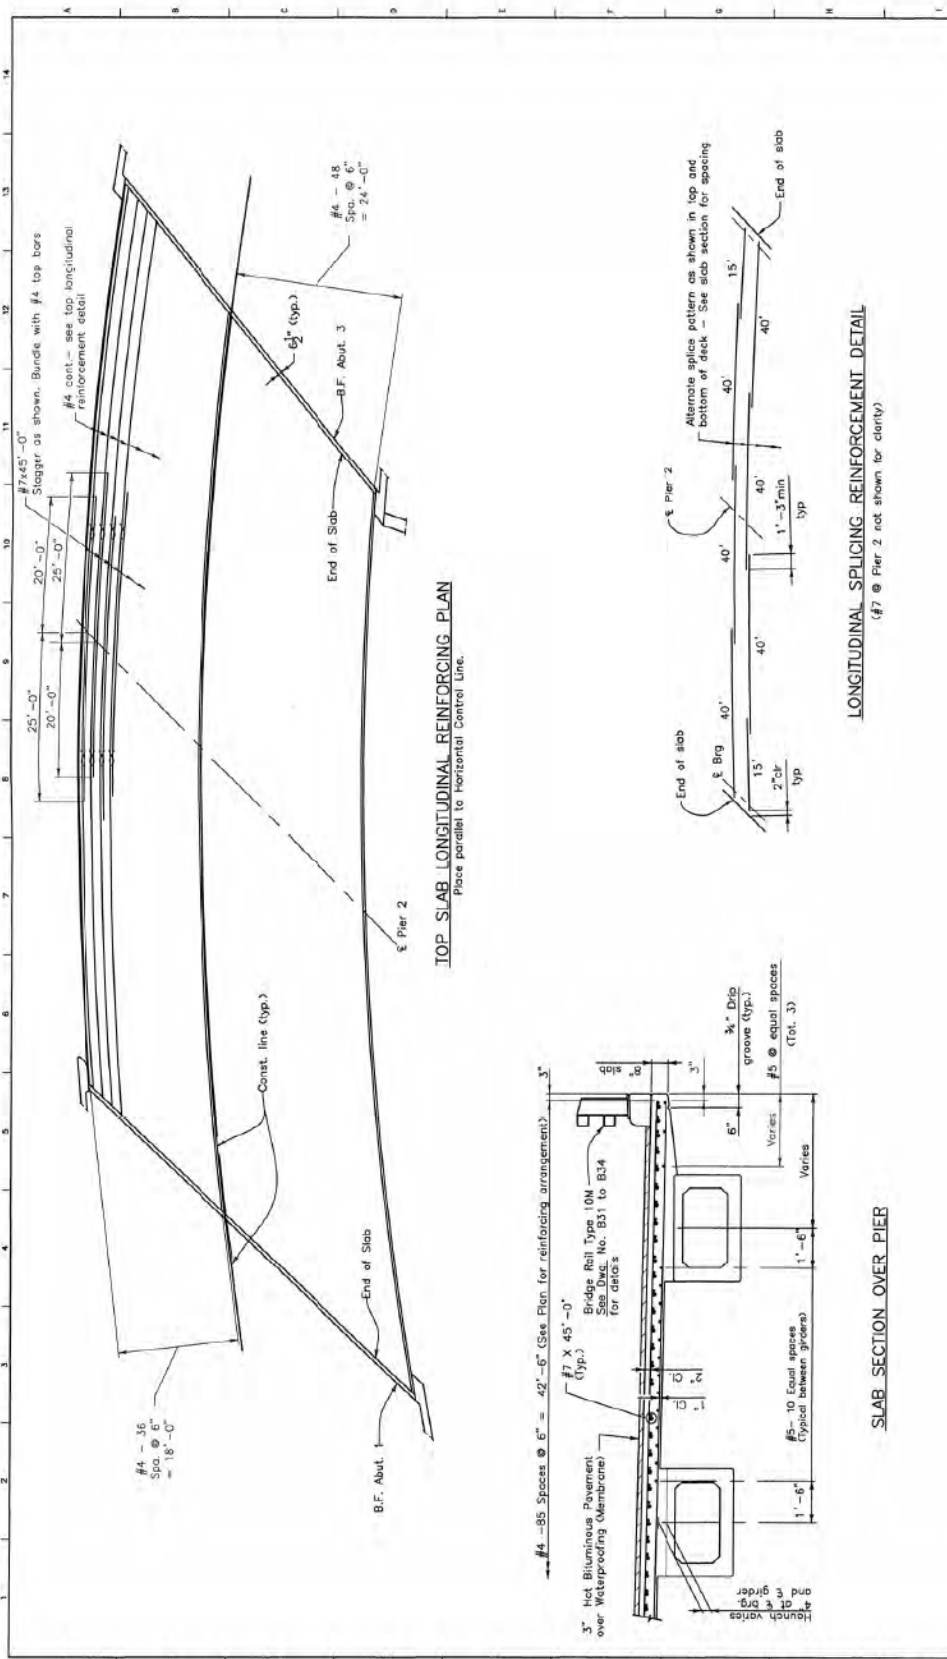


Computer File Information		Sheet Revisions	
Creation Date: 11/25/99	Revised: A A 14		
Last Modification Date: 05/14/01	Revised: T O E		
Full Path: C:\PROJ\SH3\rrmrst\from Tom\G-13-GA	Revised: C E Z		
Drawing File Name: 215SuperDwg	Revised: C E Z		
Acad Ver.: 15.0	Scale: Scale varies	Unit: Feet	Feet

Colorado Department of Transportation		SUPERSTRUCTURE DETAILS	
1501 East Arkansas Avenue, Room 310 Denver, Colorado 80272-0000 Phone: 303-757-4352 FAX: 303-757-9197		(1 of 3)	
Design and Construction		Project No./Code BR 0341-053	
As Constructed		13488	
No Revisions: 4/2/04		Sheet Number: 48	
Revised:		Sheet Subst: B21 of 46	
Veld:		Sheet Number: 48	

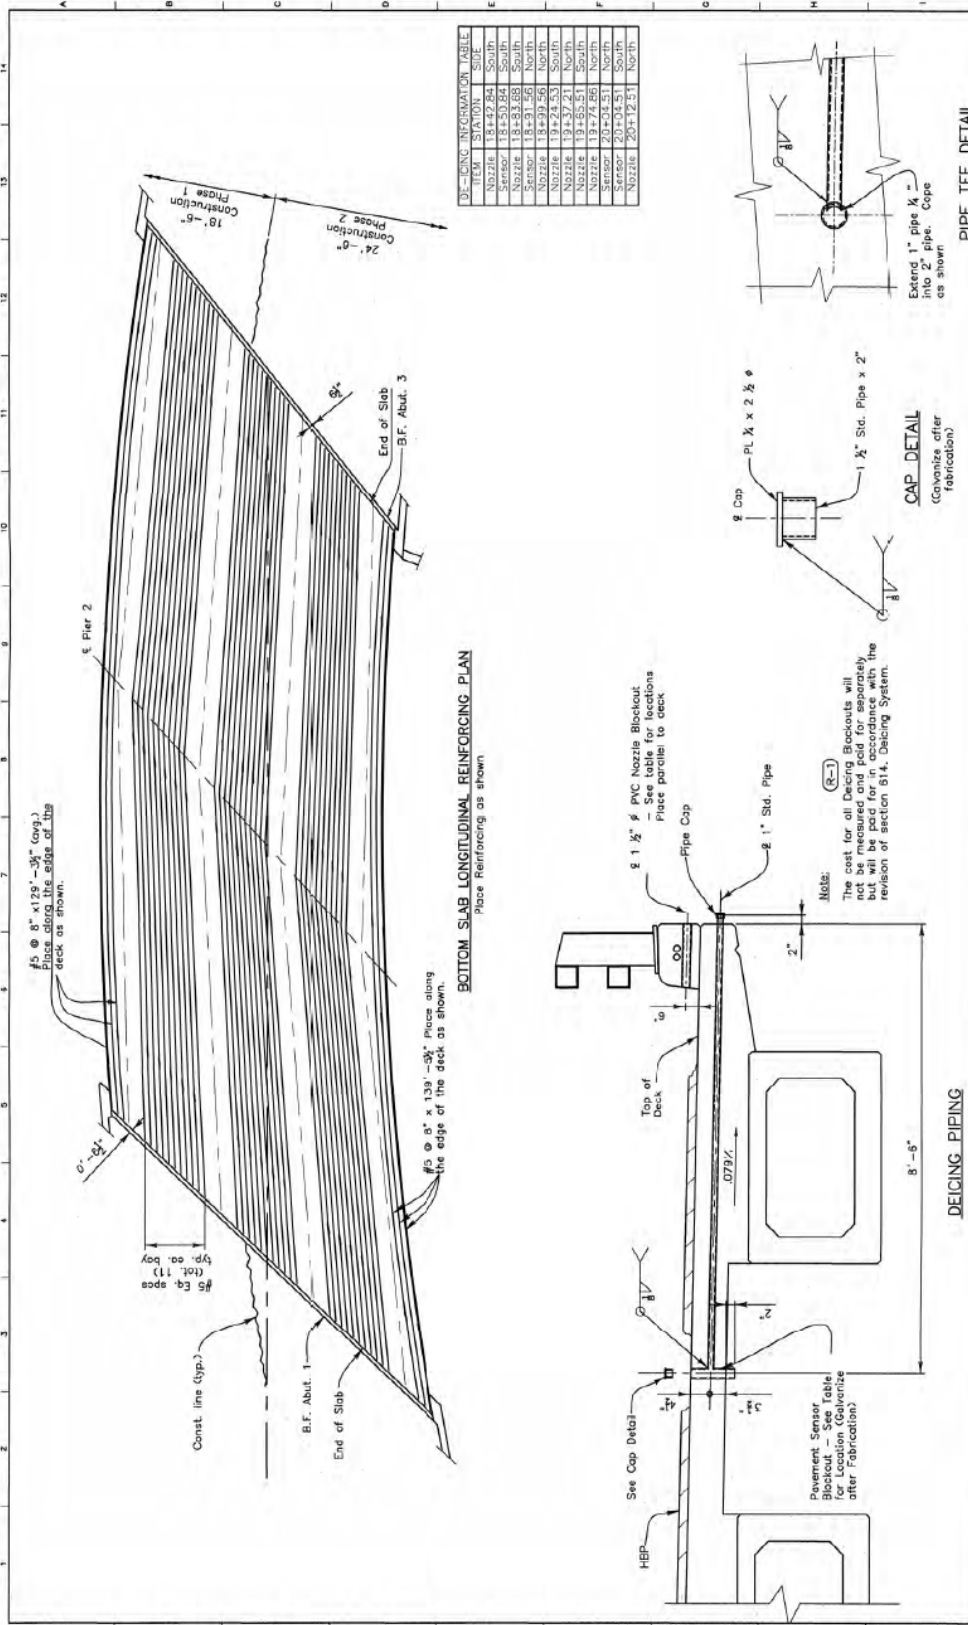

Computer File Information		SUPERSTRUCTURE DETAILS		PIPE TEE DETAIL	
Creation Date:	11/25/99	As Constructed	(2 of 3)	Project No./Code	BR 0341-053
Last Modification Date:	07/02/01	No Revisions: 4/7/01		Designer:	A. Harrell
Full Path:	C:\13488-proj\SAC-18-CN	Revised:		Detailer:	T. General
Drawing File Name:	225super.dwg	Notes:		Sheet Number	49
Acad Ver:	15.0	Scale:	Scale: 1/8" = 1'-0"	Sheet Subst:	B22 of 46
Units:	Feet	Notes:		Sheet Subst:	B22 of 46

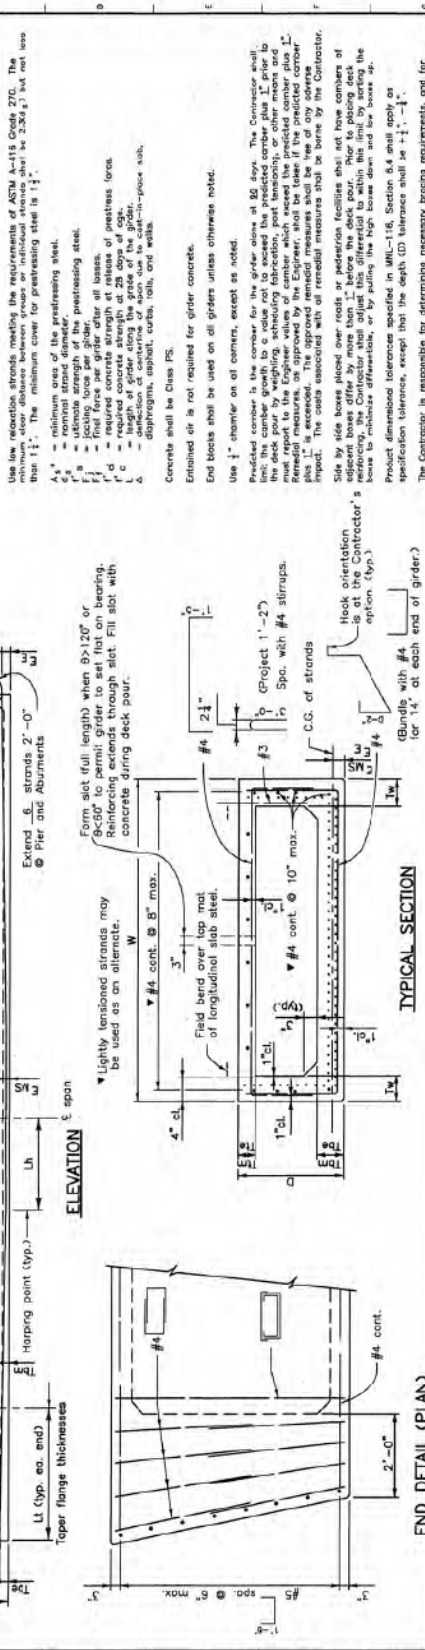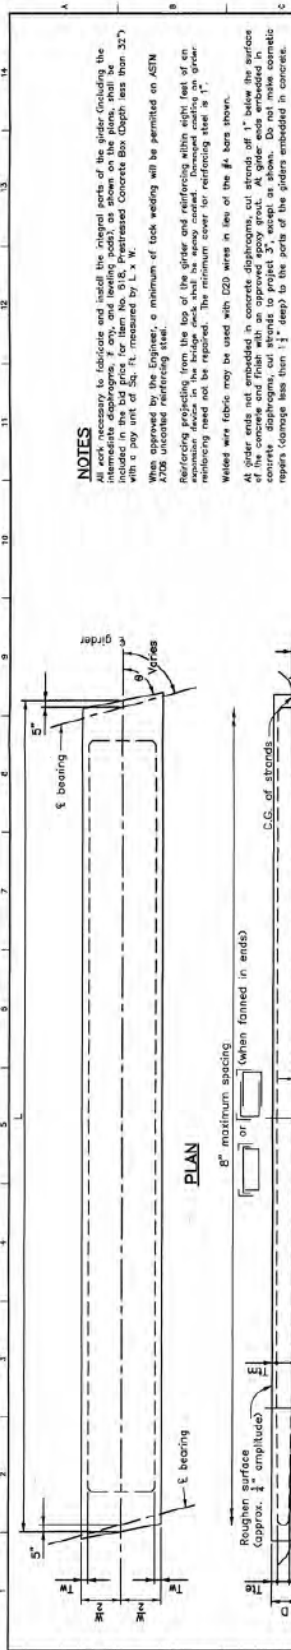

GIRDER SCHEDULE

Span No.	L (Feet)	W (Inch)	D (Inch)	θ (Deg)	T _e (Inch)	T _m (Inch)	T _{1/2} (Inch)	T _{1/4} (Inch)	L _t (Feet)	L _h (Feet)	L _s (Inch)	A _s (Inch ²)	Diabond Strands (percent)	E ₁ (Inch)	E ₂ (Inch)	E ₃ (Inch)	F ₁ (KIPS)	F ₂ (KIPS)	F ₃ (KIPS)	Concrete Strength (PSI)	Concrete Strength (PSI)	Δ (Inch)	Predicted Camber (Inch)	
1	65.140	48	30	45	6	6	4	0	7	8.26	0	5.40	5.44	1.673	1.214	6.5	8.5	8.5	3.0	3.39				
1	65.152	48	30	45	6	6	4	0	7	8.26	0	5.40	5.44	1.673	1.214	6.5	8.5	8.5	3.0	3.39				
1	65.207	48	30	45	6	6	4	0	7	8.26	0	5.40	5.44	1.673	1.214	6.5	8.5	8.5	3.0	3.39				
1	65.303	48	30	45	6	6	4	0	7	8.26	0	5.40	5.44	1.673	1.214	6.5	8.5	8.5	3.0	3.39				
2	65.315	48	30	45	6	6	4	0	7	8.26	0	5.40	5.44	1.673	1.214	6.5	8.5	8.5	3.0	3.39				
2	65.326	48	30	45	6	6	4	0	7	8.26	0	5.40	5.44	1.673	1.214	6.5	8.5	8.5	3.0	3.39				
2	65.381	48	30	45	6	6	4	0	7	8.26	0	5.40	5.44	1.673	1.214	6.5	8.5	8.5	3.0	3.39				

NOTES

All work necessary to fabricate and install the integral parts of the girder including the intermediate diaphragms, top and bottom flanges, as shown on the plans, shall be performed in accordance with the Bridge Deck and Girder Details shown on sheet BR 0341-053 with a panel of 50' x 14' measured by L x W.

When approved by the Engineer, a minimum of back welding will be permitted on ASTM A706 uncased reinforcing steel.

Reinforcing projecting from the top of the girder and extending within eight feet of an expansion joint in the bridge deck, shall be epoxy coated. Epoxy coating on girder reinforcing need not be repeated. The minimum cover for reinforcing steel is 1".

Welded wire fabric may be used with I20 wires in lieu of the #4 bars shown.

All girder ends not embedded in concrete diaphragms, cut strands off 1" below the surface of the concrete and finish with an approved epoxy grout. All girder ends embedded in concrete diaphragms, cut strands to project 3", except as shown. Do not make cosmetic repairs (distance less than 1 1/2" deep) to the ports of the girders embedded in concrete.

Use low relaxation strands meeting the requirements of ASTM A-418 Grade 270. The minimum cover for prestressing steel is 1 1/2".

A_s = minimum area of the prestressing steel.
 A_s' = nominal strand diameter.
 f_u = ultimate strength of the strand.
 f_y = yield strength of the strand.
 F₁ = first force per girder after all losses.
 F₂ = required concrete strength at losses of prestress force.
 F₃ = required concrete strength at losses of prestress force.
 Δ = camber of girder along the grade of the girder.
 Δ = deflection of concrete of span due to cast-in-place slab, diaphragm, asphalt, curbs, walls, and walk.

Concrete shall be Class FS.

Enriched air is not required for girder concrete.

End blocks shall be used on all girders unless otherwise noted.

Use 1" chamfer on all corners, except as noted.

Provided camber is the camber for the girder shown at 80 days. The Contractor shall provide camber to the contractor for the deck pour by scheduling fabrication, post tensioning or other means so that report to the Engineer values of camber which exceed the predicted camber plus 1" (measurements to be approved by the Engineer). All camber shall be measured on the center line of the girder. The camber shall be the net camber after the impact. The camber associated with all remedial measures shall be borne by the Contractor.

Side by side boxes placed over roads or pedestrian facilities shall not have cambers of adjacent boxes differ by more than 1/4" before the deck pour. Prior to placing deck concrete, the Contractor shall provide the camber to the contractor by providing the camber to the contractor's site by adjusting the camber, or by jacking the high boxes down and by leveling the camber to the contractor's specification tolerances specified in MIL-158, Section 6.4 shall apply as specified tolerances, except that the depth (D) tolerances shall be +1/4" - 1/4".

The Contractor is responsible for determining necessary bearing requirements, and for providing adequate bearing for the specific wind and weather conditions to be encountered for each specific project.

When a girder is shown with both a tapered design and a deboned design for a girder, the choice of design is the contractor's option. If only a tapered or a deboned design is shown, the contractor shall design the girder to be tapered or deboned design respectively. When used, abutting shall extend to uniformly varying heights to 3 ft. before the tapering point, but not closer than 12 ft. to the center of the span.

DEAD LOAD DEFLECTION DIAGRAM

PRECAST BOX GIRDER DETAILS

Project No./Code: BR 0341-053

Designer: A. Borogol/Structure C-15-0

Checker: T. Edwards/Numbers 13488

Sheet Number: 51

As Constructed

No. Revisions: 1/1/04

Revised: 1/1/04

By: 1/1/04

Computer File Information

Revision Date: 11/25/99

Last Modification Date: 05/11/01

Full Path: C:\Program Files\Bentley\Bentley\Drawings\11-01-01\0101.dwg

Drawing File Name: 24BoxGir.dwg

Acad Ver.: 15.0

Scale: Scale varies

Units: Feet

Colorado Department of Transportation


1601 East Adams Avenue, Room 330

Denver, Colorado 80202-3000

Phone: 303-757-9352 FAX: 303-797-9187

Design and Construction

Revised By	DATE	DESCRIPTION
AMH	5/95	Revised
AMH	1/97	Revised
AMH	3/98	Revised
AMH	11/98	Revised
AMH	1/00	Revised

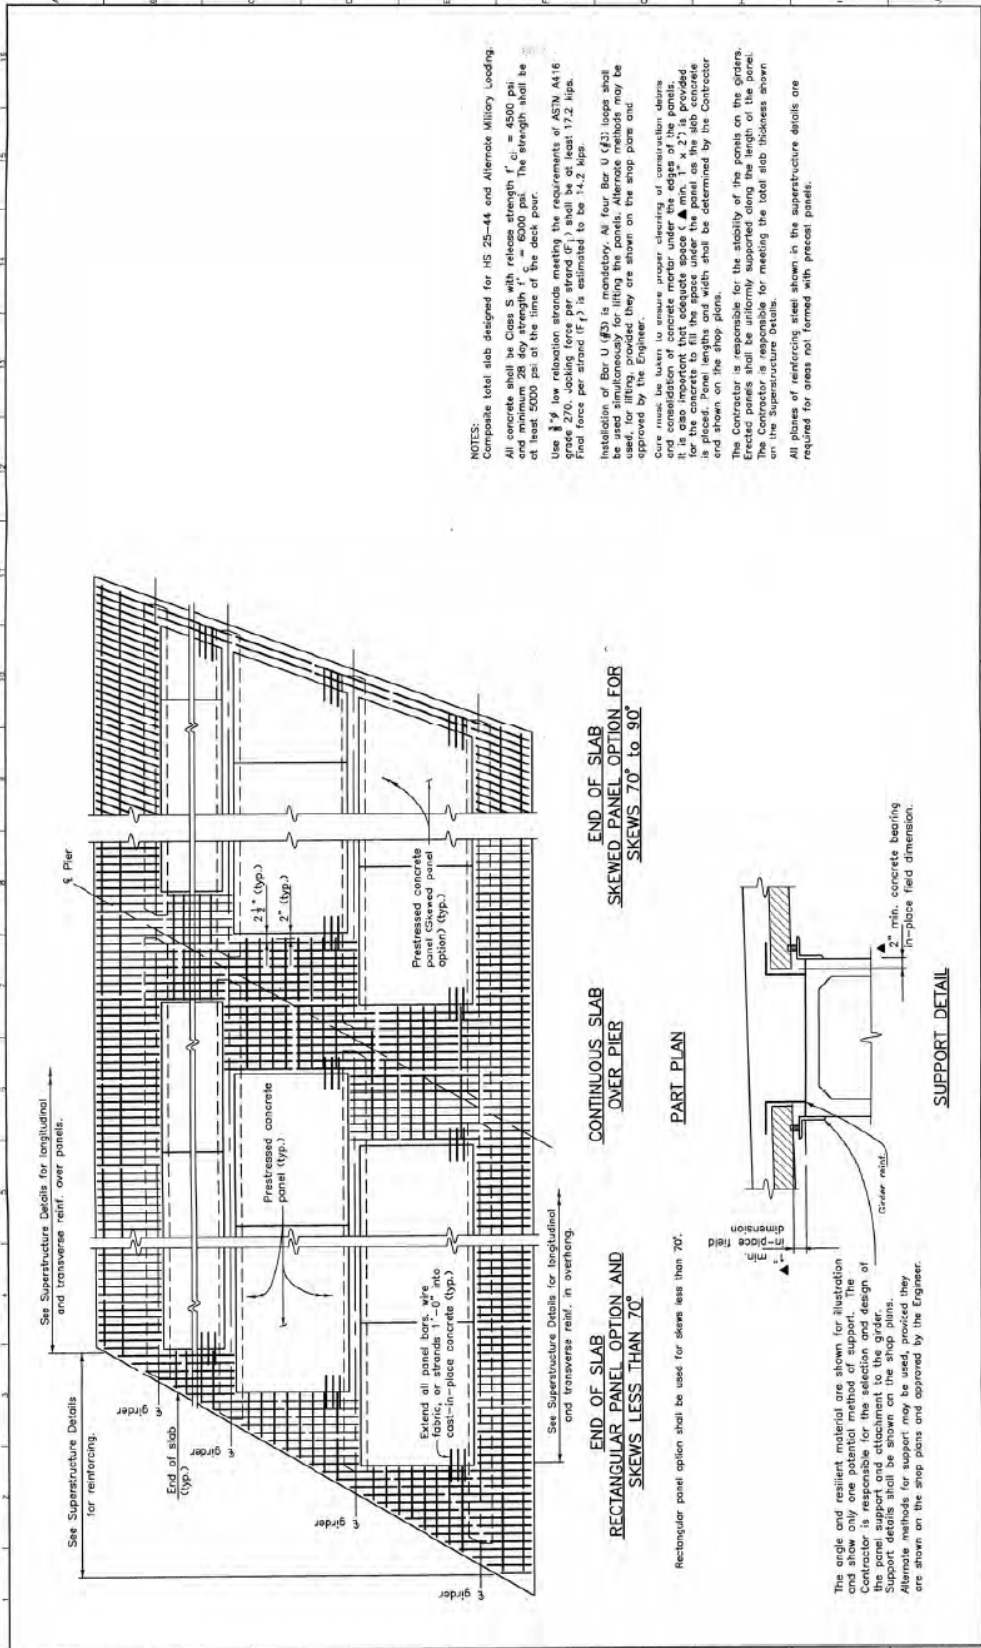

NOTES:

Composite total slab designed for HS 25-44 and Alternate Military Loading.

All concrete shall be Class S with release strength $f'_{ci} = 4500$ psi and minimum 28 day strength $f'_c = 6000$ psi. The strength shall be at least 5000 psi at the time of the deck pour.

Use $\frac{3}{8}$ " low relaxation strands meeting the requirements of ASTM A416 Grade 270. Working force per strand (F_p) shall be at least 17.2 kips. Final force per strand (F_{ps}) is estimated to be 14.2 kips.

Installation of Bar U (#5) is mandatory. All four Bar U (#5) loops shall be used simultaneously for lifting the panels. Alternate methods may be used, provided they are shown on the shop plans and approved by the Engineer.

Cure mass the basin to ensure curing of construction joints and consolidation of concrete mortar under the edges of the panels. It is also important that adequate space (Δ , min. 1" x 2") is provided for the concrete to be placed. Panel lengths and width shall be determined by the Contractor and shown on the shop plans.

The Contractor is responsible for the stability of the panels on the girders. Erected panels shall be uniformly supported along the length of the panel. The Contractor is responsible for meeting the total slab thickness shown on the Superstructure Details.

All phases of reinforcing steel shown in the superstructure details are required for areas not formed with precast panels.

Computer File Information		Colorado Department of Transportation		As Constructed		Project No./Code	
Creation Date:	5/95	4201 East Inverness Avenue, Room 330		No Revisions:	0	BR 0341-053	
Last Modification Date:	05/11/01	Denver, Colorado 80222-2400		Revised:			
Full Path:	C:\proj\stla_mstr from tom\0-15-0\	Phone: 303-757-5552 FAX: 303-757-9197		Work:			
Drawing File Name:	26precast2.dwg						
App. Ver.:	15.0						
Scale:							
Units:	English						
Sheet Revisions				PRECAST PANEL DECK FORMS (OPTIONAL)		Project No./Code	
				Designer: A. HARALI		BR 0341-053	
				Checker: A. HARALI		13488	
				Sheet Submittal: Bridge		Sheet Number	
				Submittal Sheets: 3 of 45		53	

C-15-U Construction Drawings

GENERAL NOTES

EXCEPT AS SHOWN IN THE PLANS, STRUCTURE EXCAVATION AND BACKFILL SHALL BE IN ACCORDANCE WITH M-206-11 FOR CAST-IN-PLACE RETAINING WALLS.

EXPANSION JOINT MATERIAL SHALL MEET ASPHO SPECIFICATION M-213.

A COLORED STRUCTURAL CONCRETE FINISH SHALL BE REQUIRED, AS SHOWN ON THE PLANS. THE FINISH SHALL BE IN ACCORDANCE WITH THE SPECIFICATIONS EQUIVALENT TO FEDERAL STANDARD SPEC COLOR NO. 331-09, AND IS TO BE SELECTED FROM TEST PANELS PROVIDED BY THE CONTRACTOR.

GRADE AND REINFORCING STEEL IS REQUIRED.

ALL REINFORCING STEEL SHALL BE DRYWY COATED UNLESS OTHERWISE NOTED.

① DENOTES IRON EPOXY COATED REINFORCING STEEL.

THE FOLLOWING TABLE GIVES THE MINIMUM LAP SPlice LENGTH FOR BARS SPACED IN ACCORDANCE WITH SUBSECTION 602.09. THESE SPlice LENGTHS SHALL BE INCREASED BY 25% FOR BARS SPACED AT LESS THAN 8" ON CENTER.

BAR SIZE	#4	#5	#6	#7	#8	#9	#10	#11
SPlice LENGTH FOR CLASS D CONCRETE	1'-3"	1'-8"	1'-10"	2'-2"	3'-0"	4'-8"	5'-11"	7'-3"

WHEN THE CONTRACTOR ELECTS TO SUBSTITUTE EPOXY COATED REINFORCEMENT FOR BLACK REINFORCING BARS, THE MINIMUM LAP SPlice SHALL BE AS DESCRIBED ABOVE.

THE FOLLOWING TABLE GIVES THE MINIMUM LAP SPlice LENGTH FOR BLACK REINFORCING BARS PLACED IN ACCORDANCE WITH SUBSECTION 602.09. THESE SPlice LENGTHS SHALL BE INCREASED BY 25% FOR BARS SPACED AT LESS THAN 8" ON CENTER.

BAR SIZE	#4	#5	#6	#7	#8	#9	#10	#11
SPlice LENGTH FOR CLASS D CONCRETE	1'-0"	1'-4"	1'-7"	1'-10"	2'-5"	3'-3"	3'-11"	4'-10"

THE ABOVE SPlice LENGTHS SHALL BE INCREASED BY 20 PERCENT FOR 3 BAR BUNDLES AND 35 PERCENT FOR 4 BAR BUNDLES.

THE CONTRACTOR SHALL BE RESPONSIBLE FOR THE STABILITY OF THE STRUCTURE DURING CONSTRUCTION.

E.F. = EACH FACE
N.F. = NEAR FACE
B.F. = BACK FACE

PERMANENT DECK FORMS ARE OPTIONAL. (E)

FOR STRUCTURE NUMBER INSTALLATION, SEE STANDARD S-414-12.

STATIONS, ELEVATIONS, AND DIMENSIONS CONTAINED IN THESE PLANS ARE CALCULATED BY THE CONTRACTOR. THE CONTRACTOR SHALL VERIFY ALL DIMENSIONS IN THE FIELD BEFORE BEGINNING ANY MATERIAL.

THE INFORMATION SHOWN ON THESE PLANS CONSTITUTES THE ENTIRE BASIS OF UNDERGROUND UTILITIES IS NOT GUARANTEED TO BE ACCURATE OR ALL INCLUDING THE LOCATION OF UNDERGROUND UTILITIES. THE CONTRACTOR SHALL VERIFY THE TYPE AND LOCATION OF UNDERGROUND UTILITIES AND IS RESPONSIBLE FOR THE LOCATION OF UNDERGROUND UTILITIES. THE CONTRACTOR SHALL CONTACT THE UTILITY NOTIFICATION CENTER OF DOWNSIDE AT 311-3333 FOR INFORMATION INCLUDING THE DATE OF NOTIFICATION PRIOR TO ANY EXCAVATION OR OTHER EarthWORK.

DESIGN DATA

ASPHTO, SECOND EDITION UPTO WITH 2000 INTERIMS

DESIGN METHOD: LOAD AND RESISTANCE FACTOR DESIGN

WIND LOAD: H-43 DESIGN WINDS FOR TOWN AND REGION, WIND SPEED ASSUMES 39 LBS. PER SQ. FT. FOR BRIDGE DECK OVERLAY

BEAD LOAD: ASSUMES 5 LBS. PER SQ. FT. FOR PERMANENT STEEL DECK FORMS

REINFORCED CONCRETE:

CLASS D CONCRETE: $f'_c = 4,000$ psi
REINFORCING STEEL: $f_y = 60,000$ psi

CLASSIC CONCRETE:

CLASS BC CONCRETE: $f'_c = 4,000$ psi
REINFORCING STEEL: $f_y = 60,000$ psi

PRESTRESSED CONCRETE: CLASS 8 CONCRETE $f'_c =$ (SEE DETAILS)
 $f_p = 270,000$ psi

INDEX OF DRAWINGS

DWG. NO. B 1 GENERAL INFORMATION

DWG. NO. B 2 SUMMARY OF QUANTITIES

DWG. NO. B 3 GENERAL LAYOUT

DWG. NO. B 4 GENERAL LAYOUT

DWG. NO. B 5 ENGINEERING GEOLOGY

DWG. NO. B 6 BRIDGE HYDRAULIC INFORMATION

DWG. NO. B 7 BRIDGE HYDRAULIC INFORMATION

DWG. NO. B 8 CONSTRUCTION LAYOUT

DWG. NO. B 9 CONSTRUCTION PHASING

DWG. NO. B10 CAISSON AND FOOTING LAYOUT

DWG. NO. B11 ABUTMENT 1 DETAILS

DWG. NO. B12 ABUTMENT 2 DETAILS

DWG. NO. B13 WINDOW WALL DETAILS ABUTMENT 1

DWG. NO. B14 WINDOW WALL DETAILS ABUTMENT 2

DWG. NO. B15 RETAINING WALL DETAILS ABUT. 1 AND ABUTMENT 2

DWG. NO. B16 RETAINING WALL INFORMATION

DWG. NO. B17 RETAINING WALL DETAILS

DWG. NO. B18 SUPERSTRUCTURE DETAILS

DWG. NO. B19 SUPERSTRUCTURE DETAILS

DWG. NO. B20 SUPERSTRUCTURE DETAILS

DWG. NO. B21 SUPERSTRUCTURE DETAILS

DWG. NO. B22 PRESTRESSED CONCRETE I

DWG. NO. B23 PRESTRESSED CONCRETE I

DWG. NO. B24 PRECAST PANEL DECK FORM

DWG. NO. B25 PRECAST PANEL DECK FORM

DWG. NO. B26 BRIDGE RAIL TYPE 104

DWG. NO. B27 BRIDGE RAIL TYPE 104

DWG. NO. B28 BRIDGE RAIL TYPE 104

DWG. NO. B29 APPROACH SLAB DETAILS

DWG. NO. B30 APPROACH SLAB DETAILS

DWG. NO. B31 EXCAVATION AND BACKFILL FOR BRIDGES IN CUT

DWG. NO. B32 EXCAVATION AND BACKFILL FOR BRIDGES IN FILL

DWG. NO. B33 MECHANICALLY STABILIZED BACKFILL

DWG. NO. B34 DECORATIVE MECHANICAL AND ELECTRICAL VALL

DWG. NO. B35 BRIDGE DECK ELEVATIONS

DWG. NO. B36 BRIDGE DECK ELEVATIONS

DWG. NO. B37 BRIDGE DECK ELEVATIONS

DWG. NO. B38 BRIDGE DECK ELEVATIONS

DWG. NO. B39 BRIDGE DECK ELEVATIONS

BRIDGE DESCRIPTION

1 - Span 125'-0" Bridge
Concrete Sub and Prestressed Concrete Slab,
Near Home Street Park, on U.S. 109, St.
Near Home Street Park, on U.S. 109, St.
Bridge No. 13488

Station 34+48.21 to
Station 35+76.53

Project No./Code
BR 0341-053

Design: L. Sonner, Structural
Checker: J. Vid, Structural
Number: 13488

Sheet Number: 74
Sub: 1 of 35

As Constructed

No Revisions: 4/13/07

Revised:

Notes:

Colorado Department of Transportation

4201 East Arkansas Avenue, Room 330
Denver, Colorado 80222-1400
Phone: 303-757-4352 FAX: 303-757-9197

Staff Bridge Branch

Computer File Information

Creation Date:	2/92	Unit:	FEET
Last Modification Date:	04/18/01	Model:	BR
Branding File Name:	C:\BRIDGE\PROJ\14	Units:	English
Acad Ver.:	R2000	Scale:	

Sheet Revisions

Rev	Revised info
7-3-01	



CROSS REFERENCE DRAWING NUMBER

(IF BLANK, REFERENCE IS TO SAME SHEET)

SECTION OR DETAIL IDENTIFICATION


Checked By:	DATE:	Checked By:	DATE:
MAT 1/15/03	1/15/03	J. S. V.	1/15/03
J. S. V.	1/15/03	J. S. V.	1/15/03

BRIDGE HYDRAULIC INFORMATION

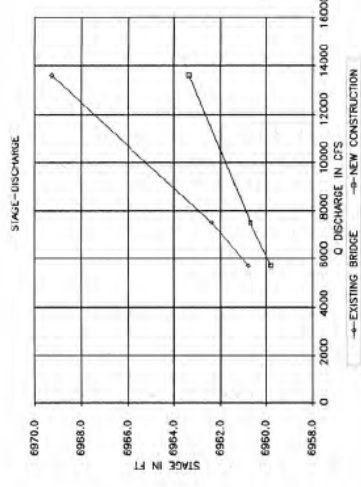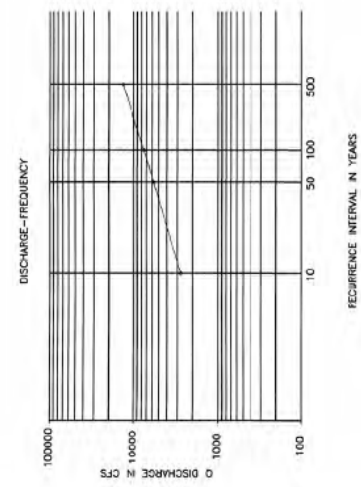

Drainage Area 53.53 Mi.
CHANNEL DESCRIPTION
 Channel Material - Cobble/Gravel
 Bottom Material - Clay/Silt/Sand
 Bottom Material Size - Clay/Silt/Sand
 Stream Form - Straight
 Manning's "n" for Design - Channel 0.045
 Manning's "n" for Existing - Channel 0.045
 Debris - Brush
 Trees/Logs - Ice
 Other -
COMPARISON OF HYDRAULICS
 FOR DESIGN DISCHARGE (50 YR)
 VELOCITY - EXISTING BACKWATER
 Natural Channel 10.10 fps 4.12 ft 8961.75 ft
 Existing Channel 7.50 fps 3.52 ft 8860.10 ft
 Ultimate


← EXISTING BRIDGE → NEW CONSTRUCTION
 TOP OF ROADWAY PERPENDICULAR TO CHANNEL

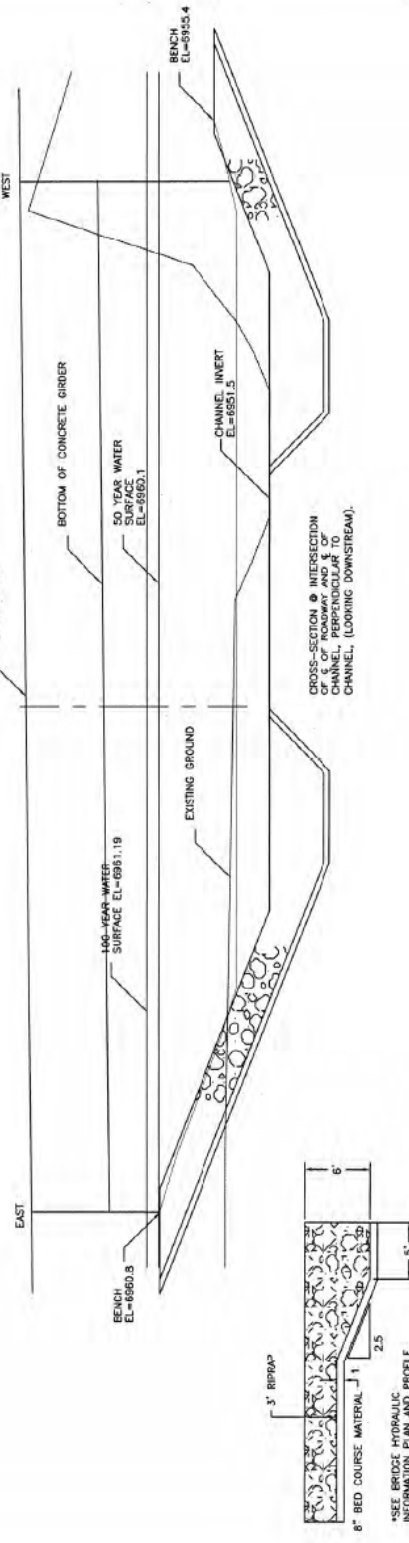


SECTION A-A

HERGENROT & ASSOCIATES, LLC
 CONSULTING ENGINEERING SERVICES

Computer File Information Creation Date: 09/01/00 User Modification Date: 1/18/2001 Full Path: \\VMP5A\SH-54_Big Thompson\C-15_CVDwg Drawing File Name: br-9-ly1.dwg Acad Ver.: R14 Scale: AS SHOWN Units: English		Sheet Revisions (Grid) mm/dd/yy xxxxx (Grid) mm/dd/yy xxxxx (Grid) mm/dd/yy xxxxx (Grid) mm/dd/yy xxxxx (Grid) mm/dd/yy xxxxx		Colorado Department of Transportation Region 4 - Loveland Residency 2207 East Highway 402 Loveland, Colorado 80537 Phone: 970-561-4673 FAX: 970-686-0188 SCE Region 4		As Constructed No Revisions: 4 mm/dd/yy Revised: mm/dd/yy Vld: mm/dd/yy		BRIDGE HYDRAULIC INFORMATION DETAILS Designer: C. DREESSEN Checker: E. SAN Sheet Subst: BRIDGE Sheet Sheets: B7 of 38		Project No./Code BR 0341-053 13488 Sheet Number 80	
------------------------------------------------------------------------------------------------------------------------------------------------------------------------------------------------------------------------------------------------	--	-----------------------------------------------------------------------------------------------------------------------------------------------------	--	-----------------------------------------------------------------------------------------------------------------------------------------------------------------------------------------	--	-----------------------------------------------------------------------------------------	--	---------------------------------------------------------------------------------------------------------------------------------------------	--	-------------------------------------------------------------	--

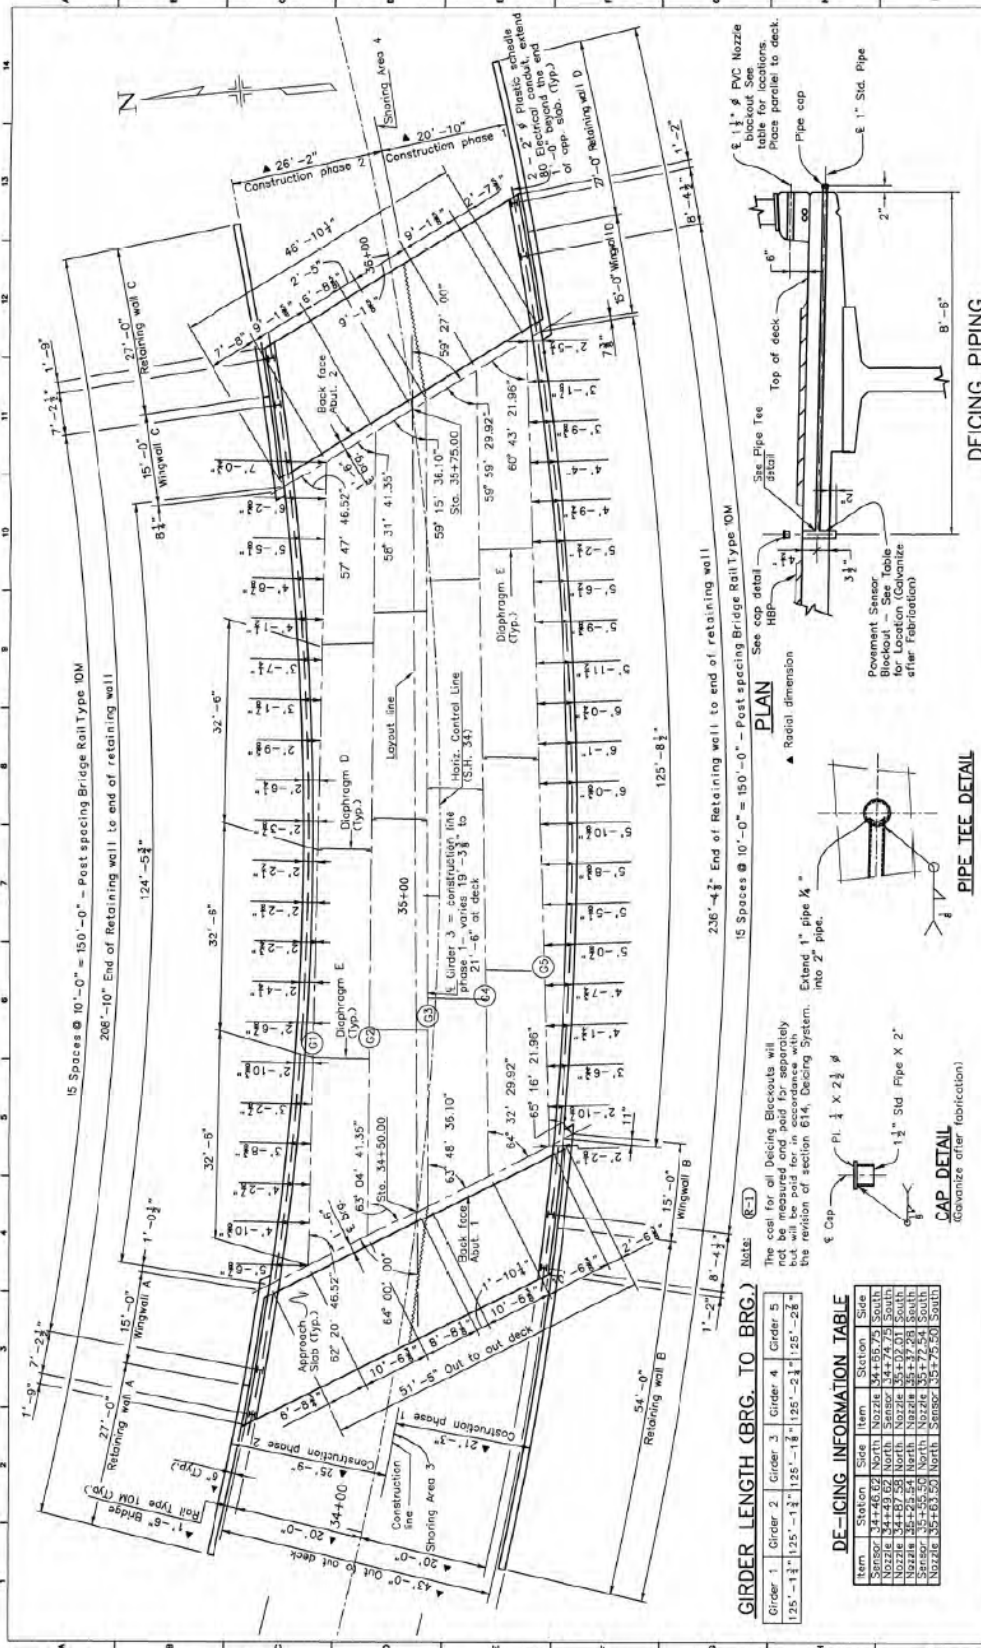


Computer File Information		Sheet Revisions		Design and Construction		As Constructed		CONSTRUCTION LAYOUT		Project No./Code	
Creation Date:	04/05/00	Initials:	JSW	7-3-01	Changed note	RLO	No Revisions:	4/1/04	Colorado Department of Transportation		BR 0341-053
Last Modification Date:	04/19/01	Initials:	JSW				Revision:		4201 East Arapahoe Avenue, Room 330 Denver, Colorado 80222-3400 Phone: 303-757-5552 FAX: 303-757-9197		13488
Drawing File Name:	CONSTR14.DWG						Author:	L. Sanchez/Structure	Bridge/ Subst. Sheets: B8 of 39		Sheet Number: 81
Acad File:	ADOTR	Scale:	SCALE	Units:	UNITS		Checker:	J. Ward/Numbers			

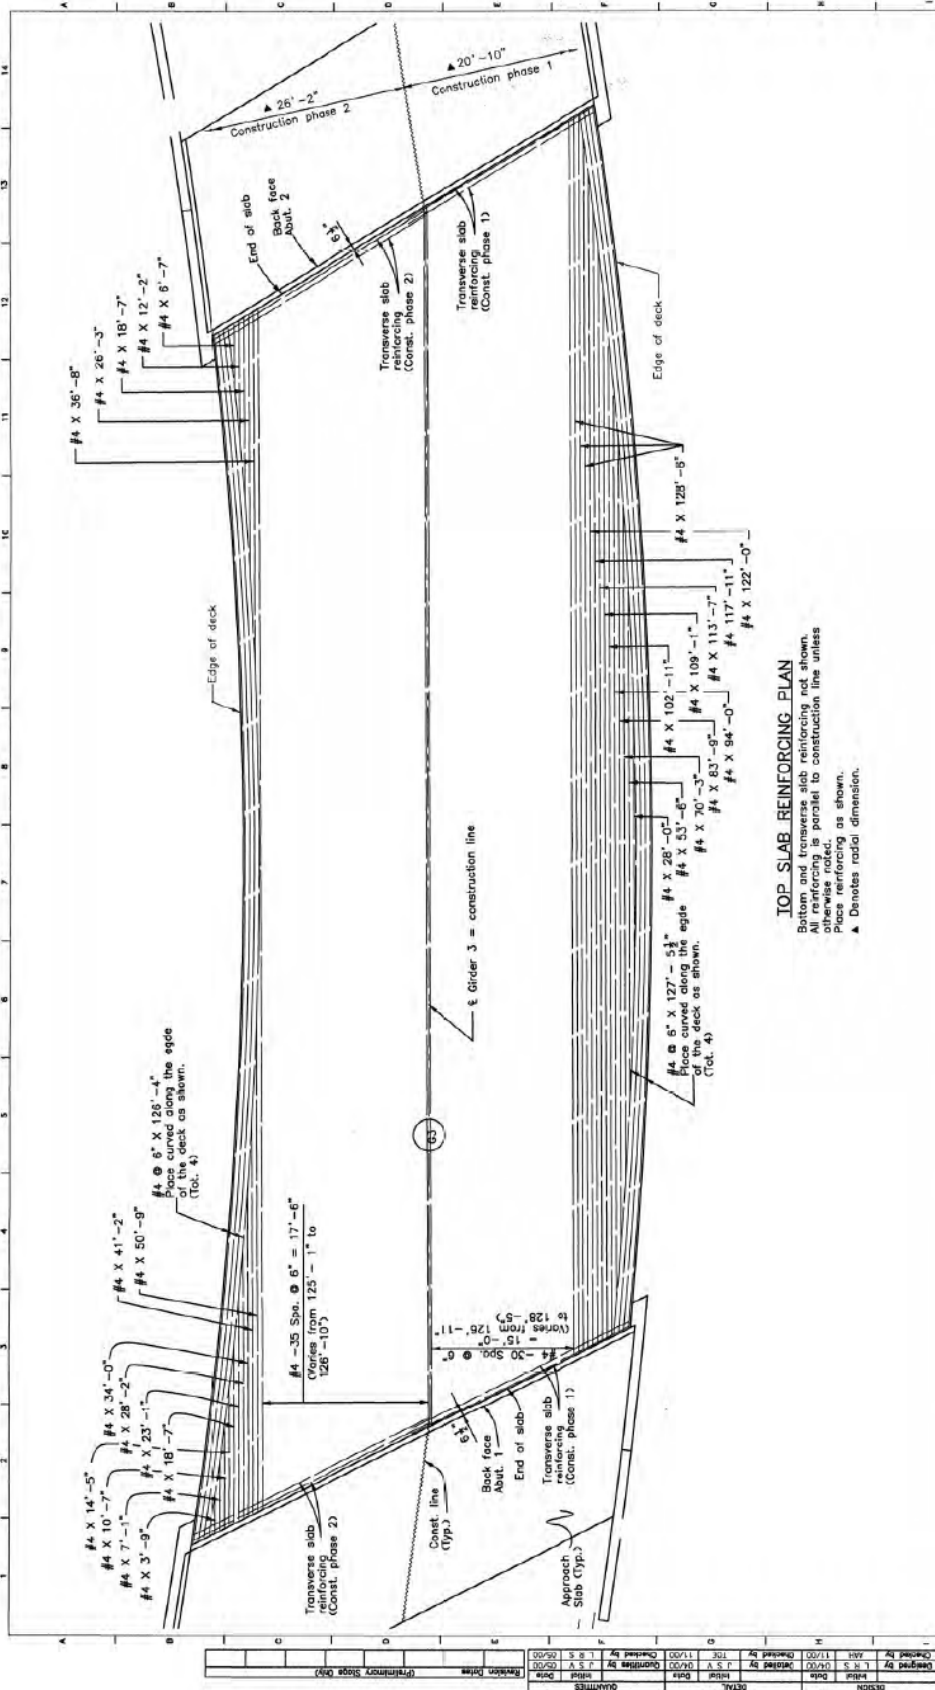

TOP SLAB REINFORCING PLAN
 Bottom and transverse slab reinforcing not shown.
 All reinforcing is percol to construction line unless
 otherwise noted.
 Reinforcing as shown.
 ▲ Denotes radii dimension.


Computer File Information		Sheet Revisions		Colorado Department of Transportation		As Constructed		SUPERSTRUCTURE DETAILS		Project No./Code	
Creation Date:	04/06/00	initial:	JSV	No. Revisions:	42/04	Designer:	L. Sanchez/Structure	BR 0341-053	Project No./Code BR 0341-053 Sheet Number 91		
Last Modification Date:	04/16/01	initial:	JSV	Revised:		Checker:	J. Valenzuela	C-15-U			
Full Path:	C:\VIBRAN\PROJ.M			Revised:		Sheet Suber:	Bridge Suber Sheets B18 of 39				
Drawing File Name:	SUPERBLDG	Scale:	SCALE	Units:	UNITS	Design and Construction					
Acad Ver:	AD2000										

DATE	DESCRIPTION	BY	DATE	DATE
04/06/00	DESIGNED BY L.S.V.	04/06/00	04/06/00	
04/16/01	DESIGNED BY L.S.V.	04/16/01	04/16/01	
04/16/01	DESIGNED BY L.S.V.	04/16/01	04/16/01	
04/16/01	DESIGNED BY L.S.V.	04/16/01	04/16/01	

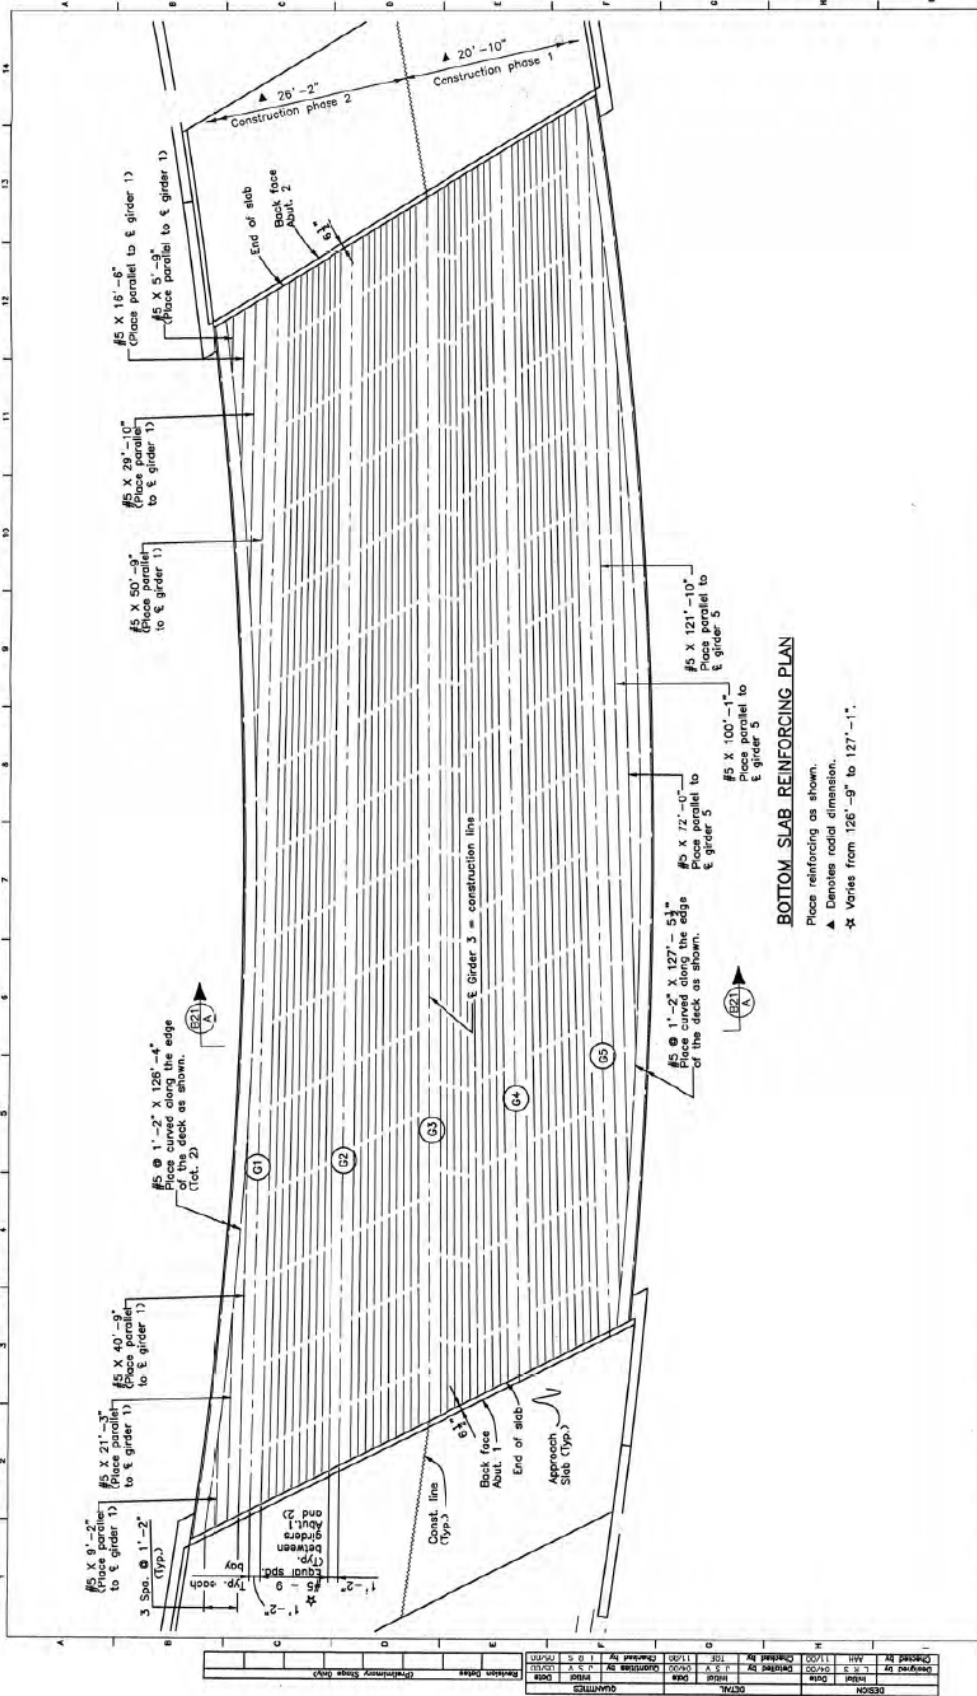


NOTES:

- A1. Work necessary to fabricate and install the integral parts of the girder shall be shown on the plans and shall be included in the Bid Item No. 618, Prestressed Concrete (BTL), with a pay unit of Feet which shall be measured by dimension L.
- When approved by the Engineer, a minimum of tack welding will be permitted on ASTM A705 uncoated reinforcing steel.
- Reinforcing projecting from the top of the girder and reinforcing within eight feet of an expansion device in the bridge deck shall be epoxy coated. Damaged coating on girder reinforcing need not be repaired. The minimum cover for reinforcing steel is 1".
- A1. Girder ends not embedded in concrete diaphragms, cut strands off 1" below the surface of the concrete and finish with an approved epoxy joint. All ends of strands shall be coated with epoxy. Embedment shall be 3", except as shown. Do not make cosmetic repairs damage less than 1/4" deep to the parts of the girders embedded in concrete.
- Use low relaxation strands meeting the requirements of ASTM A-416 Grade 270. The minimum clear distance between groups of individual strands shall be 2.5d_s, but not less than 1 1/4". The minimum cover for prestressing steel is 1 1/4".
- A minimum of two harping points shall be used per girder. Harped strands shall be well distributed at the girder ends, starting within 4" of the top of the girder and distributed such that there is no space between strands between harping points. The minimum clear distance between strands shall be 1 1/4" at the ends of the girder and shall be 1 1/4" to the end of the web parallel to the harped strands such that there is no space greater than 1'-0".
- A_s* = minimum area of the prestressing steel.
 d_s = nominal strand diameter.
 U = ultimate strength of prestressing steel.
 F_j = jacking force per girder.
 F_p = final force per girder after all losses.
 f' = ultimate concrete strength at release of prestress force.
 f'_{ci} = required concrete strength at 28 days of age.
 L = length of girder along the grade of the girder.
 Δ = diaphragm, asphalt, curbs, rabi, and walks.
 Concrete shall be Class PS.
- Embedded abut is not required for girder concrete.
- Use 3/4" diameter on all corners, except as noted.
- Predicted camber is the camber for the girder alone at 90 days. The Contractor shall limit the camber growth to a value not to exceed the predicted camber plus 1/4" prior to the deck pour by weighing, scheduling and supporting the girders. The Contractor shall adjust the camber values of camber which exceed the predicted camber plus 1/4" remedial measures, as approved by the Engineer, shall be taken if the predicted camber plus 1/4" is exceeded. The approved remedial measures shall be free of voids and honeycombing. The Contractor shall be responsible for all remedial measures shall be borne by the Contractor.
- Predict dimensional tolerances specified in MK-116, Section 6.4 shall apply as specification tolerance.

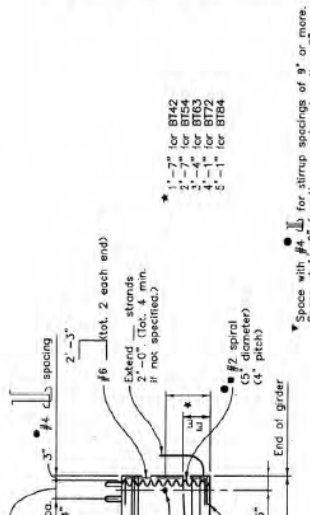

GIRDER ELEVATION

- 1. The Contractor may submit on alternate cross tie arrangement, at the end of the web, for approval by the Engineer.
- 2. 2 - D20 wires may be used in lieu of #3.
- 3. #3 wires may be used in lieu of #2.

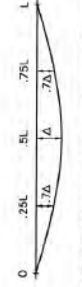

DEAD LOAD DEFLECTION DIAGRAM

END PLATE DETAIL
Girderize after fabrication.

Girder Type	Span No.	L (Feet)	A _s * (Square Inches)	E _{MS} (Inch)	E-E (Inch)	F (kipFS)	F _p (kipFS)	F _j (kipFS)	Concrete Strength (psi)	Predicted Camber (Inch)	Δ (Inch)	
B772	1	125.83	3.5	7.80	6	1580	1192	6500	7670	3	3.1	
B772	1	2.34	125.83	3.5	7.80	6	1580	1192	6500	7670	3	3.1
B772	1	5	125.83	3.5	8.16	5	1652	1171	6500	7670	3.4	3.4

TYPICAL GIRDER SECTION

A = girder depth - 3"

Weld permitted at this location.

#4 cont. (typ.)

#3 space with stirrups. (tot. 20 of each end.)

#4 cont. (typ.)

#3

#4

#4 sp. with stirrups

Project 1'-6"

#3

#4 cont.

#4 cont., type

#4 cont. (typ.)

#3

#3

#4

#4


#4

#4

#4

#4

Computer File Information		Sheet Revisions		Colorado Department of Transportation		Project No./Code					
Creation Date:	11/29/99	Issue:	L R 5	4301 East Arapaho Avenue, Room 330 Denver, Colorado 80222-3400 Phone: 303-757-6352 FAX: 303-757-8197		Prestressed Concrete I		BR0341-053			
Last Modification Date:	05/10/01	Issue:	T O E			Designer: L. Soatney/Structural Detailer: T. Edwards/Numbers		C-15-U		13488	
File Path:	C:\VOC\Joe\c3d\3A	Issue:	3 A			Sheet Subject: Bridge/ Subst Sheets: B 22 of 39		B 22 of 39		915	
Drawing File Name:	B16 BR7.dwg	Scale:	Scale varies	Units:	Feet						
Acad Ver:	15.0	Scale:	Scale varies	Units:	Feet						
				Design and Construction							

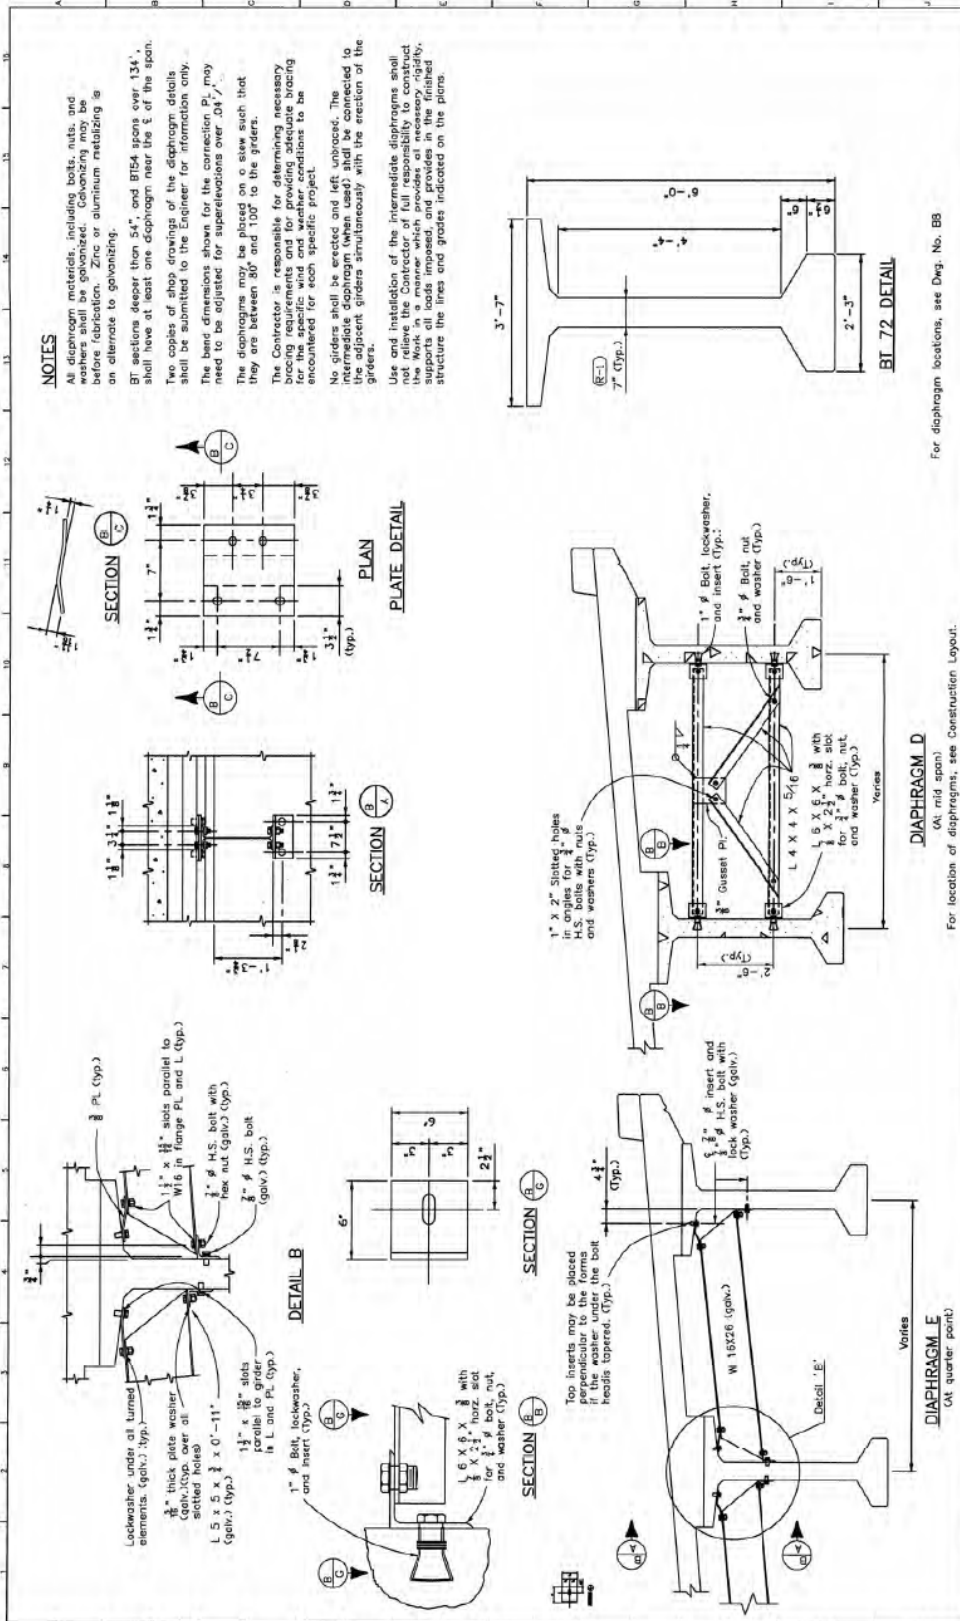

NOTES

All diaphragm materials, including bolts, nuts, and washers shall be galvanized. Galvanizing may be before fabrication. Zinc or aluminum plating is an alternate to galvanizing.

BT sections deeper than 54" and BT54 spans over 134" shall have at least one diaphragm near the E of the span.

Two copies of shop drawings of the diaphragm details shall be submitted to the Engineer for information only.


The hand dimensions shown for the connection PL may need to be adjusted for super-elevations over .04%.

The diaphragms may be placed on to steel such that they are between 90" and 150" to the girders.

The Contractor is responsible for determining necessary bracing for the diaphragm. The Contractor shall provide bracing for the specific wind and seismic conditions to be encountered for each specific project.

No girders shall be erected and left unbraced. The intermediate diaphragm (when used) shall be connected to the adjacent girders simultaneously with the erection of the girders.

Use and installation of the intermediate diaphragms shall not relieve the Contractor of full responsibility to construct the diaphragm. The Contractor shall provide the necessary supports all loads imposed, and provides in the finished structure the lines and grades indicated on the plans.

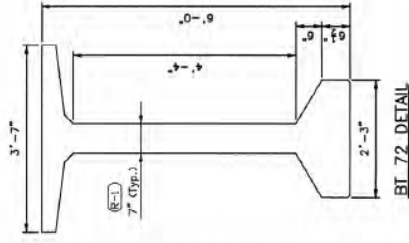

For diaphragm locations, see Dwg. No. B8


Computer File Information Creation Date: 12/28 Last Modification Date: 04/18/01 File Path: C:\VIBRO\PROJ\35 Drawing File Name: BR BR7.DWG Acad Ver: R2000 Scale: English		Sheet Revisions <table border="1"> <tr> <th>Rev</th> <th>Added dimension</th> <th>By</th> </tr> <tr> <td>7-3-01</td> <td></td> <td>RLD</td> </tr> </table>	Rev	Added dimension	By	7-3-01		RLD	As Constructed No Revisions: 4/2/01 Revised: Void:	PRESTRESSED CONCRETE I Designer: L Sanchez Checker: J. Vid Submitter: Bridge Sheet No.: 23 of 39	Project No./Code BR 0341-053 13488 Sheet Number: 96
Rev	Added dimension	By									
7-3-01		RLD									

Colorado Department of Transportation
 4501 East Missouri Avenue, Room 330
 Denver, Colorado 80222-4000
 Phone: 303-757-3352 FAX: 303-757-3197

Staff Bridge Branch

DIAPHRAGM D
 (At mid span)
 For location of diaphragms, see Construction Layout.

DIAPHRAGM E
 (At quarter point)

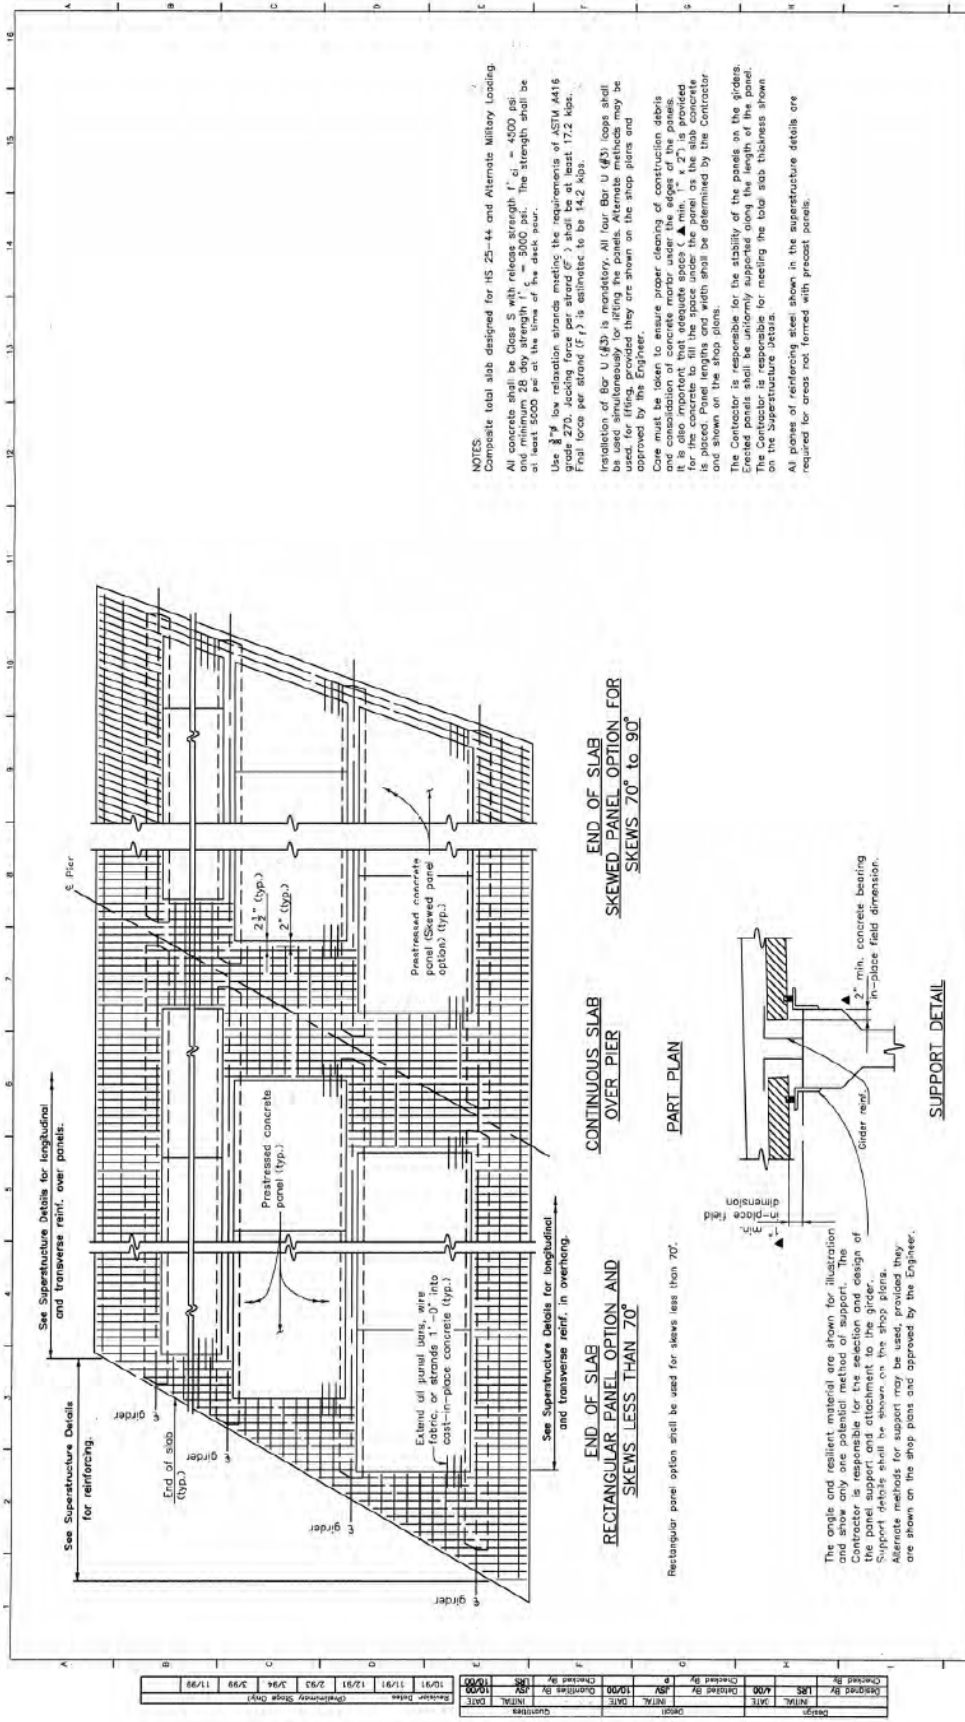

Revision: 10/21/01 Date: 10/21/01 Drawn By: JLN Checked By: JLN Title: PRECAST DECK FORM		Project No./Code BR 0341-063 13488	
Revision: 04/29/01 Date: 04/29/01 Drawn By: C.V. ROJAS Checked By: JLN Title: PRECAST DECK FORM		PRECAST PANEL DECK FORM Designer: L. Sanchez Number: C-15-U Drafter: J. Virdi Structure Number:	
Revision: 02/01/01 Date: 02/01/01 Drawn By: JLN Checked By: JLN Title: PRECAST DECK FORM		Sheet No. of 39 Sheet Subst.: B 25 of 39 Sheet Number: 018	

Computer File Information

Revision: 10/21/01
 Date: 10/21/01
 Drawn By: JLN
 Checked By: JLN
 Title: PRECAST DECK FORM

Colorado Department of Transportation
 401 East Michigan Avenue, Room 130
 Denver, Colorado 80202-3400
 Phone: 303-751-9352 FAX: 303-757-9197

Staff Bridge Branch

C-15-Y Construction Drawings

GENERAL NOTES

EXCEPT AS SHOWN IN THE PLANS, STRUCTURE EXCAVATION AND BACKFILL SHALL BE IN ACCORDANCE WITH M-206-1 FOR CAST-IN-PLACE RETAINING WALLS.

A. COLORED STRUCTURAL CONCRETE FINISH WILL BE REQUIRED, AS SHOWN ON THE PLANS, ON EXPOSED CONCRETE SURFACES TO ONE FOOT BELOW THE GROUND LINE.

EXPANSION JOINT MATERIAL SHALL MEET AASTHC SPECIFICATION M-213.

THE COLOR SHALL BE BEIGE, EQUIVALENT TO FEDERAL STANDARD 5958 COLOR NO. 33446, AND IS TO BE SELECTED FROM TEST PANELS PROVIDED BY THE CONTRACTOR.

GRADE OF REINFORCING STEEL IS REQUIRED.

ALL REINFORCING STEEL SHALL BE EPOXY COATED UNLESS OTHERWISE NOTED.

(N) DENOTES NON COATED REINFORCING STEEL.

THE FOLLOWING TABLE GIVES THE MINIMUM LAP LENGTH FOR BARS, COATED REINFORCING BARS PLACED IN ACCORDANCE WITH SUBSECTION 602.06. THESE LAP LENGTHS SHALL BE INCREASED BY 25% FOR BARS SPACED AT LESS THAN 8" ON CENTER.

BAR SIZE	#4	#5	#6	#7	#8	#9	#10	#11
SPACE LENGTH FOR CLASS 0 CONCRETE	1'-3"	1'-6"	1'-10"	2'-2"	3'-6"	4'-8"	5'-11"	7'-3"

WHEN THE CONTRACTOR BELIEVES TO SUBSTITUTED EPOXY COATED REINFORCEMENT FOR BLACK REINFORCING BARS, THE MANUFACTURER SHALL BE AS REFERENCED ABOVE.

THE FOLLOWING TABLE GIVES THE MINIMUM LAP LENGTH FOR BARS, UNCOATED REINFORCING BARS PLACED IN ACCORDANCE WITH SUBSECTION 602.06. THESE LAP LENGTHS SHALL BE INCREASED BY 25% FOR BARS SPACED AT LESS THAN 8" ON CENTER.

BAR SIZE	#4	#5	#6	#7	#8	#9	#10	#11
SPACE LENGTH FOR CLASS 0 CONCRETE	1'-0"	1'-4"	1'-7"	1'-10"	2'-5"	3'-1"	3'-11"	4'-10"

REINFORCING BARS AND DIMENSIONS CONTAINED IN THESE PLANS ARE CALCULATED FROM A RECENT FIELD SURVEY. THE CONTRACTOR SHALL VERIFY ALL DIMENSIONAL DIMENSIONS IN THE FIELD BEFORE ORDERING OR FABRICATING ANY MATERIAL.

THE INFORMATION SHOWN ON THESE PLANS CONCERNING THE TYPE AND LOCATION OF UNDERSTRAINS IS FOR INFORMATION ONLY. THE CONTRACTOR SHALL VERIFY THE TYPE AND LOCATION OF UNDERSTRAINS FROM A RECENT FIELD SURVEY. THE CONTRACTOR SHALL VERIFY ALL DIMENSIONAL DIMENSIONS IN THE FIELD BEFORE ORDERING OR FABRICATING ANY MATERIAL.

THE CONTRACTOR SHALL BE RESPONSIBLE FOR THE STABILITY OF THE STRUCTURE DURING CONSTRUCTION.

L.F. = LEAN FACE
F.F. = FAR FACE
N.F. = NEAR FACE

PERMANENT BECK FORMS ARE OPTIONAL (SEE 5-14-12).

FOR STRUCTURE NUMBER INSTALLATION, SEE STANDARD S-814-12.

STATIONS, ELEVATIONS, AND DIMENSIONS CONTAINED IN THESE PLANS ARE CALCULATED FROM A RECENT FIELD SURVEY. THE CONTRACTOR SHALL VERIFY ALL DIMENSIONAL DIMENSIONS IN THE FIELD BEFORE ORDERING OR FABRICATING ANY MATERIAL.

DESIGN DATA

ASHTO, SECOND EDITION UFDH WITH 1989 INTERMS

DESIGN METHOD: LMD AND RESISTANCE FACTOR DESIGN

LIVE LOAD: HL-93 (DESIGN TRUCK OR TANDEN, AND DESIGN LANE LOAD)

DECK LOAD: ASSUMES 3" IR. FOR 30' FT. FOR REMAINING STEEL DECK FORMS

REINFORCED CONCRETE:

CLASS 0 CONCRETE: $f'_c = 4,500$ psi

REINFORCING STEEL: $f_y = 60,000$ psi

CAISSON CONCRETE:

CLASS 0Z CONCRETE: $f'_c = 4,000$ psi

REINFORCING STEEL: $f_y = 60,000$ psi

PRESTRESSED CONCRETE:

CLASS S CONCRETE: $f'_c =$ (SEE DETAILS)

$f_s = 270,000$ psi

INDEX OF DRAWINGS

- B 01 General Information - Summary of Quantities
- B 02 General Layout
- B 03 Engineering Geology
- B 04 Bridge Hydraulic Information
- B 05 Bridge Construction Information
- B 06 Construction Layout
- B 07 Construction Paving
- B 08 Abutment Layout
- B 09 Abutment, 3 Details
- B 10 Wingwall Details
- B 11 Pier Miscellaneous Details
- B 12 Superstructure Details
- B 13 Precast Box Girder Details
- B 14 Precast Panel Deck Forms (optional)
- B 15 Bridge Rail Type 10 Details
- B 16 Bridge Rail Type 10 Details
- B 17 Bridge Expansion Device (G-4 inch)
- B 18 Approach Sub Details
- B 19 Approach Sub Details for Bridges in Fill
- B 20 Mechanically Stabilized Backfill
- B 21 Drilling Mechanical/Electrical Vault
- B 22 Bridge Deck Elevations
- B 23 Bridge Deck Elevations
- B 24 Bridge Deck Elevations
- B 25 Bridge Deck Elevation

SUMMARY OF QUANTITIES

ITEM NUMBER	DESCRIPTION	UNITS EACH	SUPERC.	ABUT. 1	PIER 2	ABUT. 3	APPROACH SLABS (BOTH)	TOTALS
206	STRUCTURE EXCAVATION	CY		443		351		794
206	STRUCTURAL BACKFILL (CLASS 1)	CY		221		193		414
206	STRUCTURE BACKFILL (CLASS 2)	CY		30		42		72
206	MECHANICAL REINFORCEMENT OF SOIL	CY		221		133		414
206	SHORING (AREA 5)	LS		1				1
206	SHORING (AREA 6)	LS		1				1
403	MC-BITUMINOUS PAVEMENT (S) (75) (PG 84-28)	T	104			1	28	132
503	DRILLED CAISSON (30 INCH)	LF		58		92		120
503	DRILLED CAISSON (42 INCH)	LF			80			80
515	WATERPROOFING (MEMBRANE)	SY	647				189	816
518	BRIDGE EXPANSION DEVICE (G-4 INCH)	FT.					80	80
601	CONCRETE CLASS D (BRIDGE)	CY	181	46	29	13	83	383
601	STRUCTURAL CONCRETE COATING	SY	399	46	120	48		611
602	REINFORCING STEEL	LB			4119			4119
602	REINFORCING STEEL (EPOXY COATED)	LB	54859	4607		4381	12659	78408
609	BRIDGE RAIL TYPE 10M	FT.	382					382
613	2 INCH ELECTRICAL CONDUIT	FT.	773					773
614	DEGAS SYSTEM	EA	1					1
618	PRESTRESSED CONCRETE BOX (DEPTH LESS THAN 32 INCHES)	SF	2275					2275

GENERAL INFORMATION

Project No./Code: BR 0341-053
 Drawing No.: 13488

Design: A. Hanzl/Structure

Checker: T. Eleva/Numbers

Sheet Number: 113 of 32

Bridge Sheet: B 1 of 32

Station: 54+87.29 to Station 54+87.79



BRIDGE HYDRAULIC INFORMATION

Drainage Area 85 Sq. Mi.
CHANNEL DESCRIPTION
 Bottom Material - Cohesive Non Cohesive
 Bottom Material Size - Clay Silt Sand Gravel
 Stream Form - Straight D Meandering
 Mennings "n" for Design - Channel 0.045 Overbank 0.085
 Debris - Brush Trees/Logs Ice Other



COMPARISON OF MORPHOLOGIES FOR DESIGN DISCHARGE (50 YR)

VELOCITY	FREEBOARD	BACKWATER
N/A	N/A	N/A
6.95 fpa	****	7114.10 FT
6.30 fpa	****	7114.72 FT

COMMENTS
 FREEBOARD IS BASED ON 15% ADJUSTMENT RESTRICTIONS.
 AVERAGE FREEBOARD IS 1.5 FT.
 APPROXIMATELY 4.8 FT OF FREEBOARD BEYOND THE FREEBOARD.

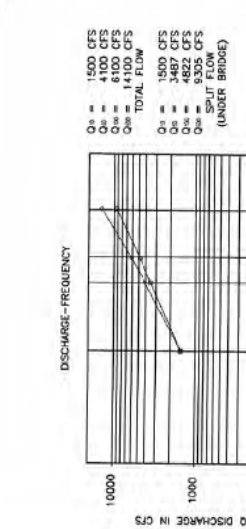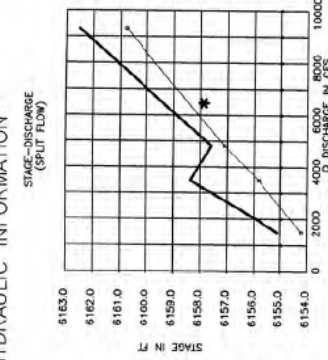


→ EXISTING BRIDGE → NEW CONSTRUCTION
 *EXISTING AND NEW CONSTRUCTION CONTAIN THE SAME STAGE-DISCHARGE VALUES.

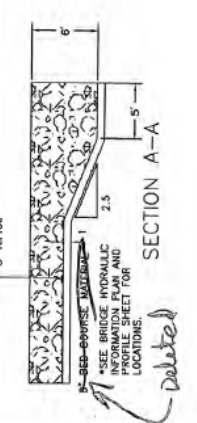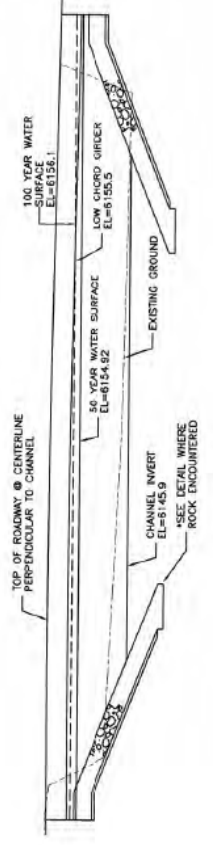

RIPRAP AT ROCK DETAIL

HEDRICK & ASSOCIATES, LLC
 CONSULTING ENGINEERING SERVICES

<p>Computer File Information</p> <p>Revision Date: 09/01/00 Last Modification Date: 1/18/2001 File Path: \\VPS4\SH34_Big Thompson\C_15_0\dwg Drawing File Name: br_d_hyrl.dwg Acad Ver.: R 14</p>	<p>Sheet Revisions</p> <table border="1"> <tr><td>XXX</td><td>mm/dd/yy</td><td>XXXXX</td></tr> <tr><td>XXX</td><td>mm/dd/yy</td><td>XXXXX</td></tr> <tr><td>XXX</td><td>mm/dd/yy</td><td>XXXXX</td></tr> <tr><td>XXX</td><td>mm/dd/yy</td><td>XXXXX</td></tr> <tr><td>XXX</td><td>mm/dd/yy</td><td>XXXXX</td></tr> </table>	XXX	mm/dd/yy	XXXXX	XXX	mm/dd/yy	XXXXX	XXX	mm/dd/yy	XXXXX	XXX	mm/dd/yy	XXXXX	XXX	mm/dd/yy	XXXXX	<p>As Constructed</p> <p>No Revisions: mm/dd/yy Revisions: mm/dd/yy Date: mm/dd/yy</p>	<p>BRIDGE HYDRAULIC INFORMATION DETAILS</p> <p>Project No./Code: BR 0341-053 Sheet Number: 13488 Designer: C. DREESSEN Checker: E. SAN Date: mm/dd/yy</p>
XXX	mm/dd/yy	XXXXX																
XXX	mm/dd/yy	XXXXX																
<p>Colorado Department of Transportation 200 West Lincoln Loveland, Colorado 80537 Phone: 970-667-6670 FAX: 970-669-0288 Region 4</p>	<p>Department of Transportation 200 West Lincoln Loveland, Colorado 80537 Phone: 970-667-6670 FAX: 970-669-0288 SCE</p>	<p>Department of Transportation 200 West Lincoln Loveland, Colorado 80537 Phone: 970-667-6670 FAX: 970-669-0288 SCE</p>	<p>Department of Transportation 200 West Lincoln Loveland, Colorado 80537 Phone: 970-667-6670 FAX: 970-669-0288 SCE</p>															

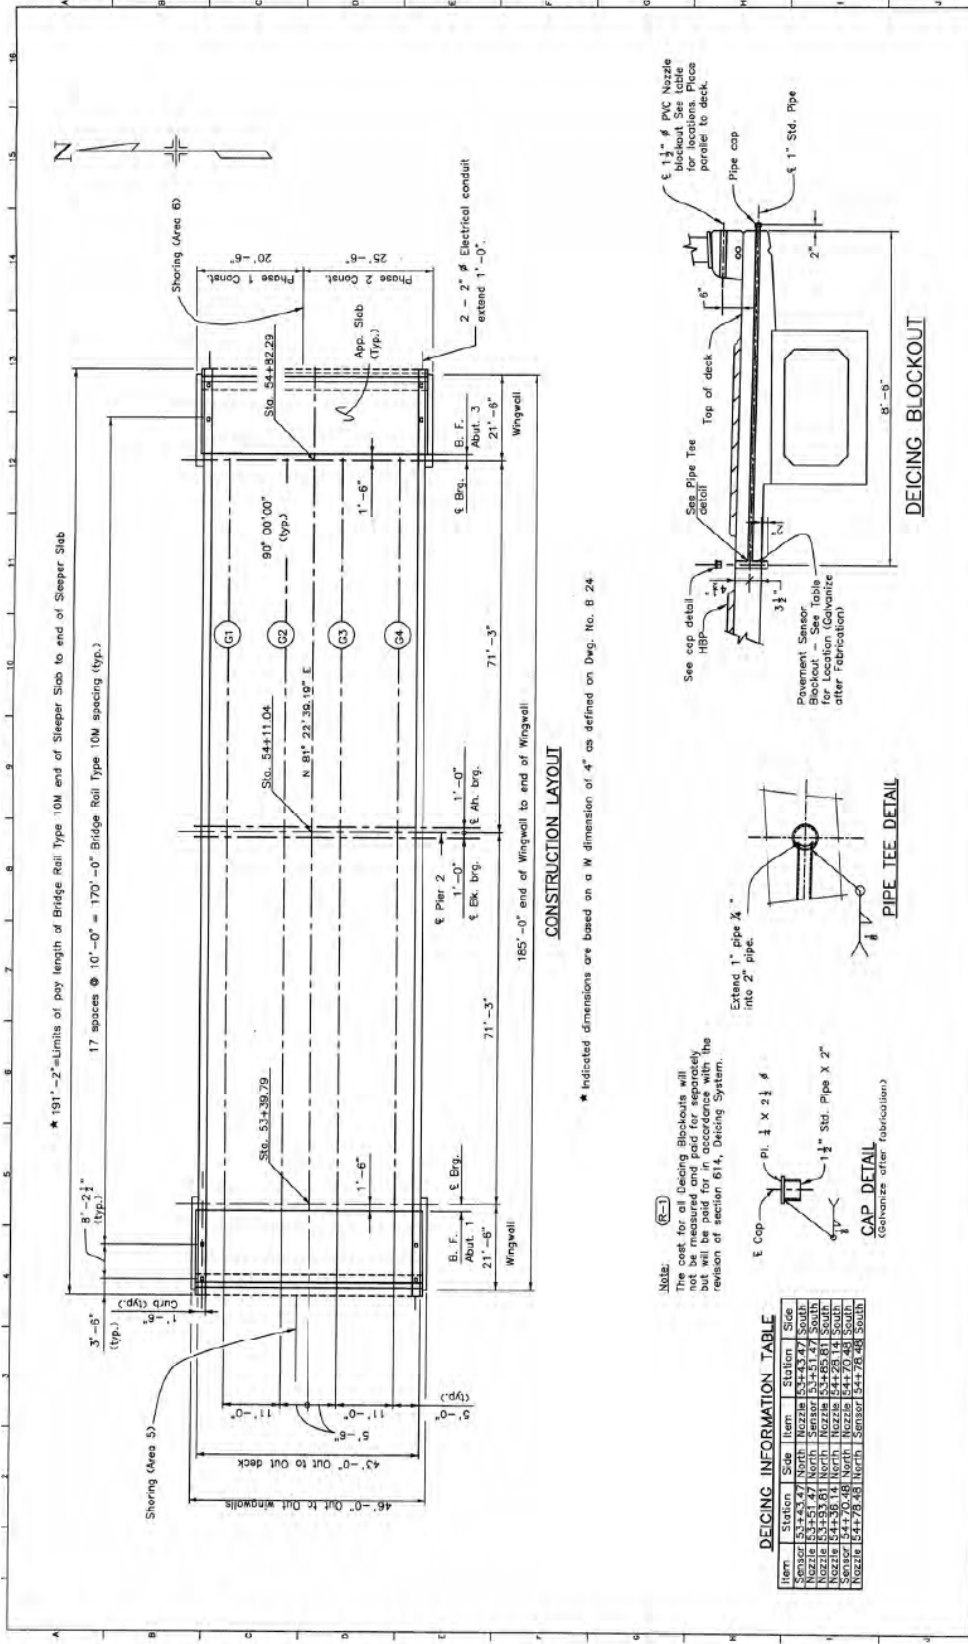

* 191'-2" = Limits of pay length of Bridge Rail Type 10M end of Sleeper Slab to end of Sleeper Slab

17 spaces @ 10'-0" = 170'-0" Bridge Rail Type 10M spacing (typ.)

Station	Item	Station	Scale
53+39.79	Shoring Area 5	54+82.29	Shoring Area 6
54+82.29	Phase 1 Const.	55+25.79	Phase 2 Const.
55+25.79	App. Slab (Typ.)	56+68.29	Wingwall




CONSTRUCTION LAYOUT

* Indicated dimensions are based on a W dimension of 4" as defined on Dwg. No. B 24


Note:
The cost for all Deicing Blockouts will not be measured and paid for separately but will be paid for in accordance with the revision of section 614, Deicing System.

DEICING INFORMATION TABLE

Item	Station	Scale	Station	Scale
Nozzle	53+39.79	North	54+82.29	South
Nozzle	54+82.29	North	55+25.79	South
Nozzle	55+25.79	North	56+68.29	South
Nozzle	56+68.29	North	57+10.79	South
Nozzle	57+10.79	North	58+53.29	South
Nozzle	58+53.29	North	59+95.79	South

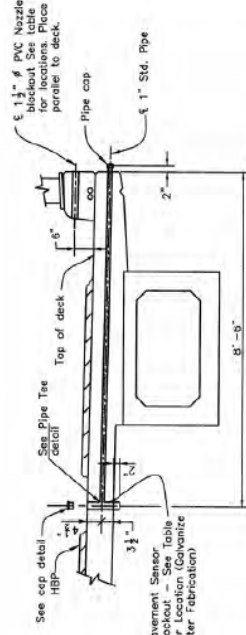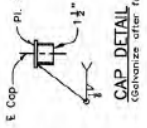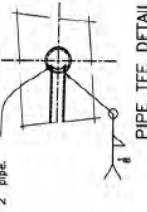

Computer File Information Creation Date: 10/00 incls: MH Last Modification Date: 07/00/01 incls: MH Full Path: C:\AC-11-Y Drawing File Name: Y-CONSTLAWG Acad Ver.: R14.01 Scale: WAKES Units: English		Sheet Revisions 7-3-01 Changed note RLD		Colorado Department of Transportation 4201 East Avenue Avenue, Room 330 Denver, Colorado 80222-3400 Phone: 303-757-4332 FAX: 303-757-9197		As Constructed No Revisions: 4/2/04 Permet:		CONSTRUCTION LAYOUT Designer: A. HANCOCK Checker: A. HANCOCK Sheet Subst: Bridge Subst Sheets: B 7 of 32		Project No./Code BR 0341-053 13498	
				Staff Bridge Branch		Void		Sheet Number 419			

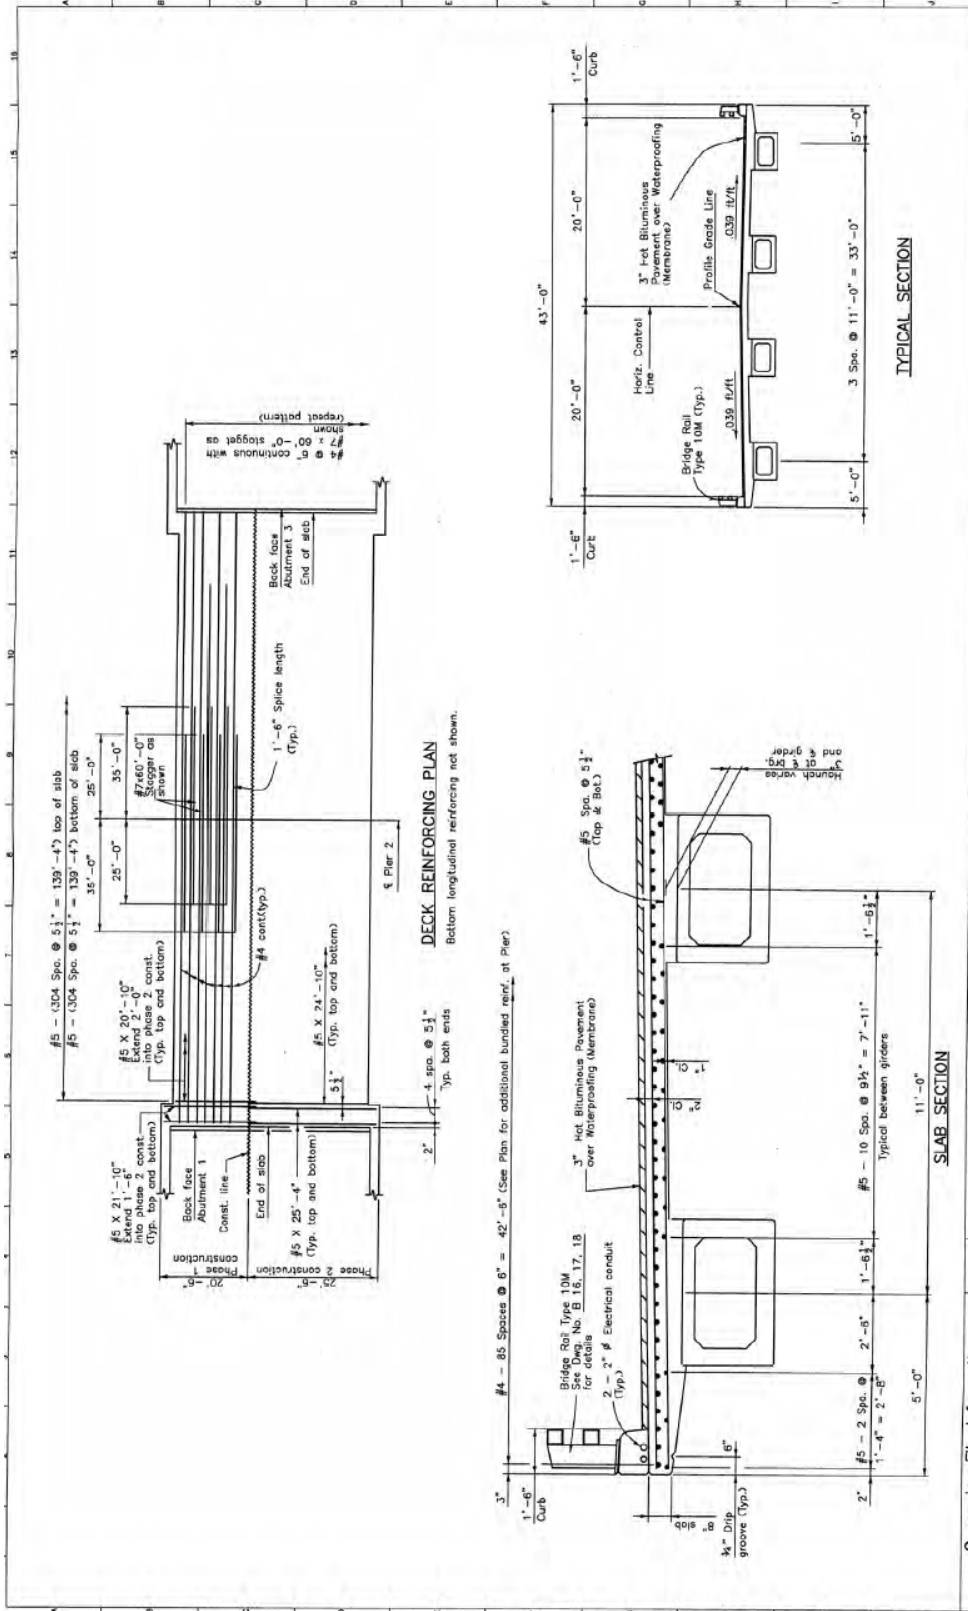

Computer File Information		Sheet Revisions		Colorado Department of Transportation		As Constructed		SUPERSTRUCTURE DETAILS		Project No./Code	
Revision Date	9/95	Revised	RDH	201 East Arkansas Avenue, Room 330 Denver, CO 80202 Phone: 303-767-8322 FAX: 303-757-9147		No. Revisions	4/2/04	Designer: A. WRAJU Structure C-15-Y		BR 0.541-053	
Revision Date	07/14/01	Revised	LDJ	Staff Bridge Branch		Revised		Detailer: A. WRAJU Numbers		13488	
Revision Date	02/14/01	Revised	SN			Valid		Sheet Subject: Bridge		Sheet Number	
Revision Date	02/14/01	Revised	SN			Valid		Subst. Sheets: B 15 of 32		127	
Revision Date	02/14/01	Revised	SN			Valid		Subst. Sheets: B 15 of 32		127	

DESIGNED BY	DATE	INITIALS
CHK'D BY	DATE	INITIALS
APPROVED BY	DATE	INITIALS

NOTES

At work necessary to locate and install the integral parts of the girder including the intermediate diaphragms, if any, and welding joints, as shown on the plans, shall be in accordance with Section No. 615, "Reinforced Concrete Box" with a pay unit of \$0.15 per square foot.

When approved by the Engineer, a minimum of each welding will be permitted as ASTM A108 uncoated reinforcing steel.

Reinforcing projecting from the top of the girder and extending within eight feet of an expansion joint in the bridge deck shall be epoxy coated. Broomed coating on girder reinforcing need not be repeated. The minimum cover for reinforcing steel is 1".

Welded wire fabric may be used with Q20 wires in lieu of the #4 bars above.

At girder ends not embedded in concrete diaphragms, cut strands off 1" below the surface of the concrete and finish with an approved epoxy grout. At girder ends embedded in concrete diaphragms, cut strands off 1" below the surface of the concrete.

Use the reaction strands meeting the requirements of ASTM A-115 Grade 270. The maximum clear distance between groups of individual strands shall be 2.0d, but not less than 12". The minimum cover for prestressing steel is 1 1/2".

A₁ = minimum area of the prestressing steel.
A₂ = total area of the prestressing steel.
f₁ = prestressing force per strand.
f₂ = ultimate strength of the prestressing steel.
f_c = required concrete strength at release of prestress force.
t_c = required concrete strength at 28 days of age.
d = effective depth of the concrete.
d' = effective depth of strands in a span-to-plate web.
δ = deflection of strands of span due to cast-in-place web.
Concrete shall be Class F5.

Entired or is not required for girder concrete.

End locus shall be used on all girders unless otherwise noted.

Use 1" chamfer on all corners, except as noted.

Predicted corner in the corner for the girder along of 90 days. The Contractor shall limit concrete growth to a value not to exceed the predicted corner plus 1/4" prior to the casting of the concrete. The Contractor shall be responsible for determining the predicted corner plus 1/4" must report to the Engineer within a period which exceeds the predicted corner plus 1/4" is acceptable. The Contractor shall be responsible for the predicted corner plus 1/4" is acceptable. The Contractor shall be responsible for the predicted corner plus 1/4" is acceptable.


The costs calculated with all remedial measures shall be borne by the Contractor.

Side by side boxes placed over roads or pedestrian facilities shall not have corners of adjacent boxes differ by more than 1/4" before the deck pour. Prior to placing deck concrete, the Contractor shall take steps to level the top surfaces of the concrete boxes to minimize differentials, or by pulling the high boxes down and by boxes up.

Product dimensional tolerances specified in MN-116, Section 6.4 shall apply to all cast-in-place concrete.

The Contractor is responsible for determining necessary bracing requirements, and for providing adequate bracing for the specific wind and weather conditions to be encountered for each specific project.

When a girder is shown with both a tapered design and a rounded design for a girder, or a combination design is shown, that design shall be used with no contractor option or modification. The tapered design shall be used if the drawing shows it before the rounding point shown, but not closer than 12 ft. to the center of the span.

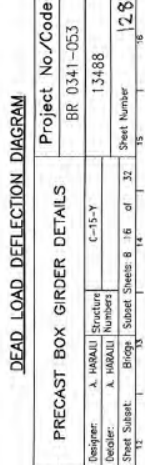

DEAD LOAD DEFLECTION DIAGRAM

Project No./Code
BR 0341-053

Designer: A. HARAU / Structure
C-15-Y

Checker: A. HARAU / Numbers
13468

Sheet No./Total
18 of 32

PRECAST BOX GIRDER DETAILS

As Constructed
No. Revisions: 4 / 2 / 04


Colorado Department of Transportation
4201 East Arkansas Avenue, Room 330
Denver, Colorado 80231
Phone: 303-792-0302 FAX: 303-792-9197

Staff Bridge Branch


Computer File Information	Sheet Revisions
Revision Date: 10/90	
Last Modification Date: 07/19/01	
Full Path: C:\C-15-Y	
Drawing File Name: Y-800GR	
Acad Ver. R14.01	Scale: 1/8" = 1'-0"

GIRDER SCHEDULE

Span	Girder No.	L (Feet)	W (Inch)	D (Inch)	θ (Deg)	T _w (Inch)	T _m (Inch)	T _{th} (Inch)	T _{th} (Inch)	The (Inch)	T _{th} (Inch)	The (Inch)	T _{th} (Inch)	T _{th} (Inch)	Rebar Strands (Square Inch)	Predicted Comber (Inch)	Concrete Strength (KPSI)	Concrete Strength (KPSI)	Concrete Strength (KPSI)	Predicted Comber (Inch)						
ALL	1-4	71.08	48	30	90	6	6	6	4	4	6	4	0	7	5.893	0	3.47	3.14	1115	654	6.5	8.5	3.0	3.2		

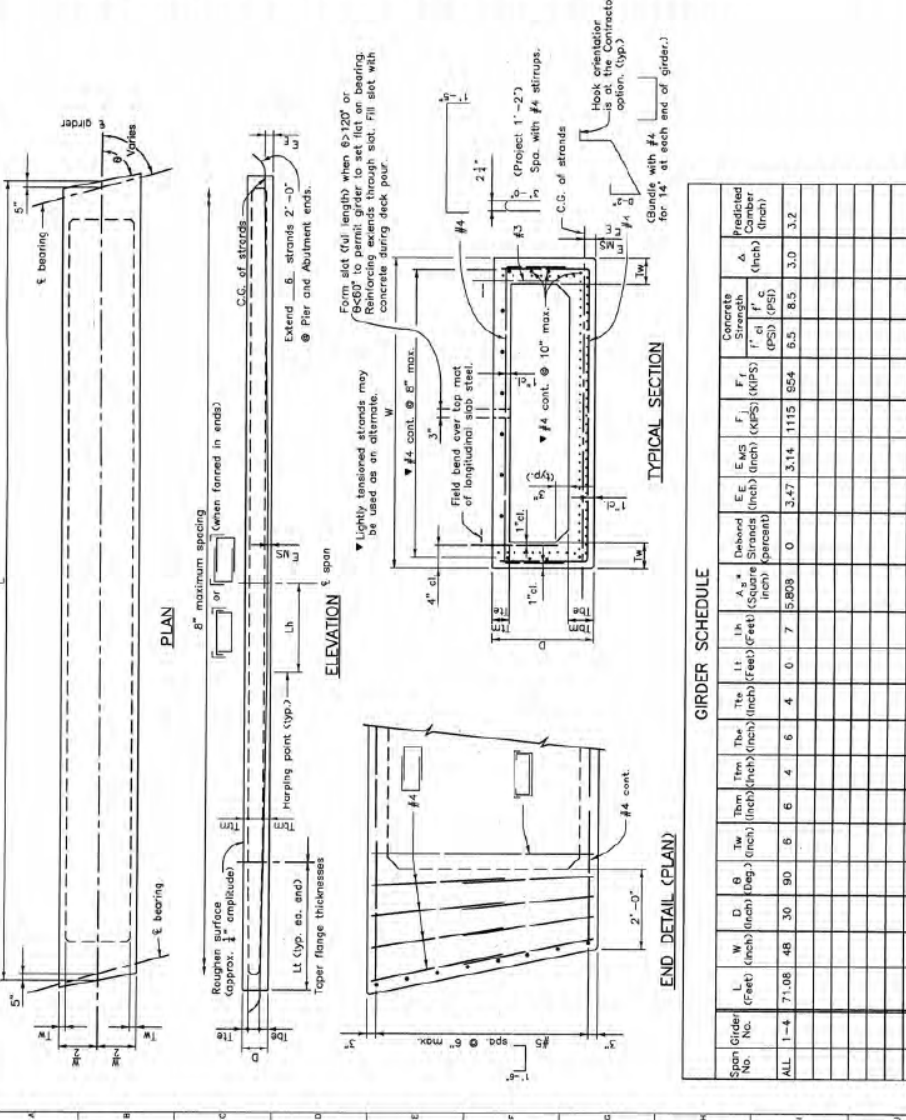

Checked By	Date	Checked By	Date	Checked By	Date
MS	10/90	MS	10/90	MS	10/90
MS	10/90	MS	10/90	MS	10/90
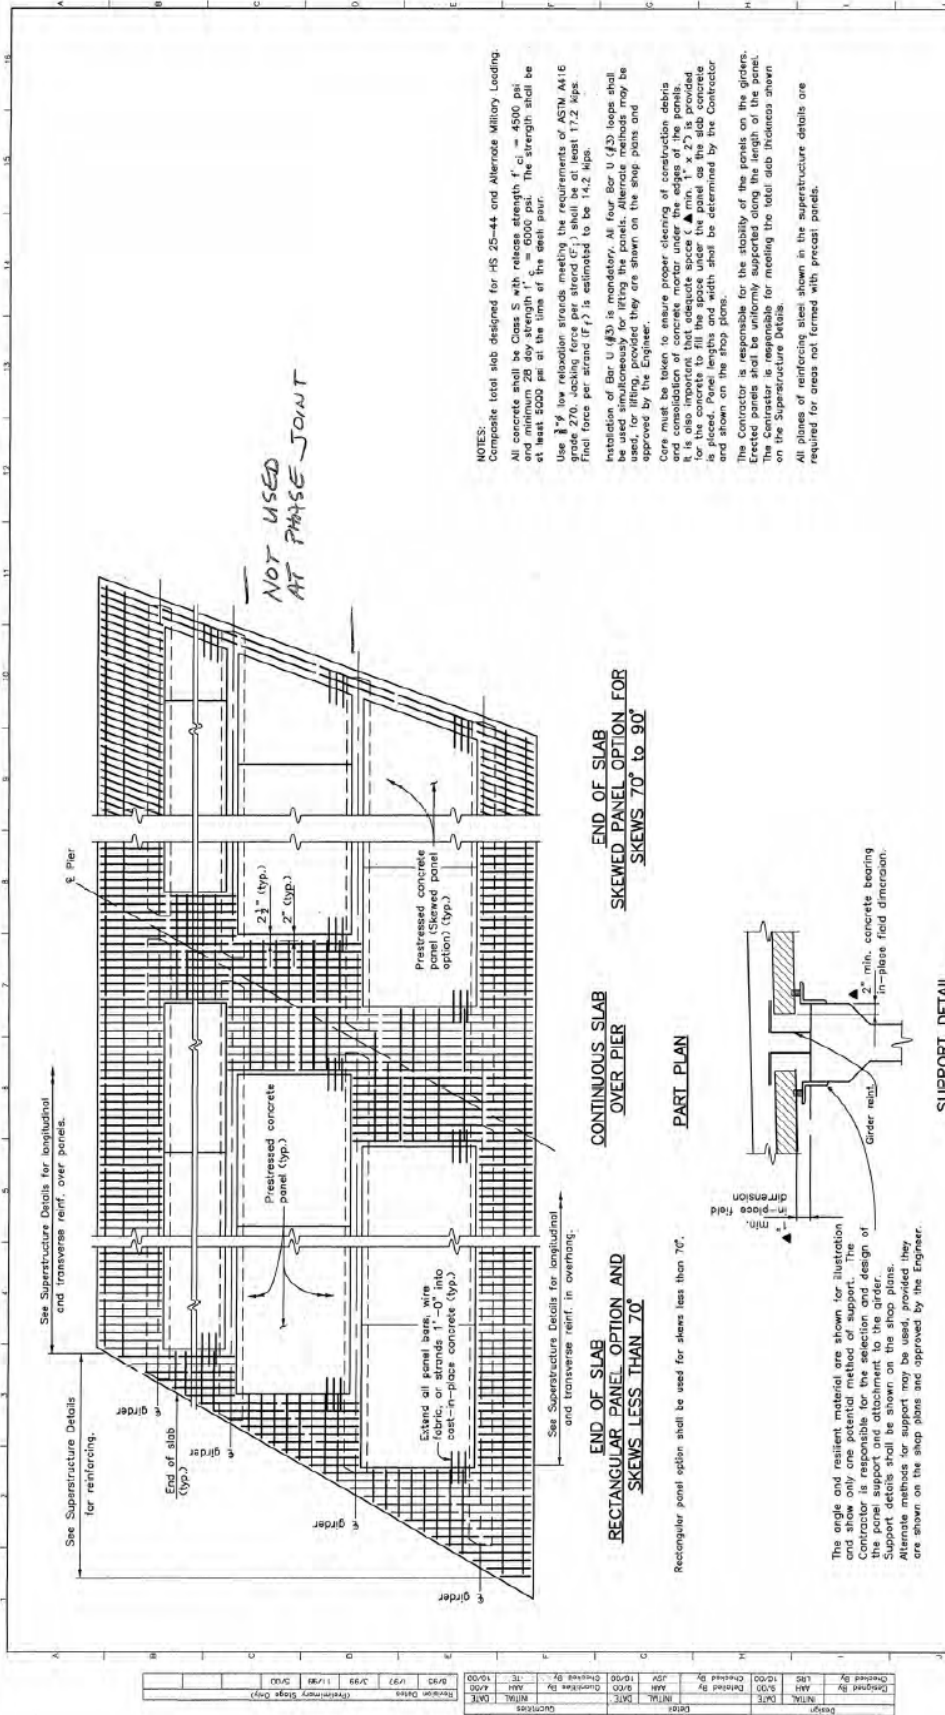

NOTES:

Composite total slab designed for HS 25-44 and Alternate Military Loading. All concrete shall be Class S with release strength $f'_{ci} = 4500$ psi and minimum 28 day strength $f'_c = 6000$ psi. The strength shall be at least 5000 psi at the time of the deck pour.

Use $\frac{3}{4}$ " low relaxation strands meeting the requirements of ASTM A416 grade 270. Jacking force per strand (F_j) shall be at least 17.2 kips. Final force per strand (F_f) is estimated to be 14.2 kips.

Installation of Bar U (#3) is mandatory. All four Bar U (#3) loops shall be used simultaneously for jacking the panels. Alternate methods may be used, for jacking, provided they are shown on the shop plans and approved by the Engineer.

Care must be taken to ensure proper clearing of construction debris from the deck before concrete is placed. Adequate spacing (Δ min. $1' \times 2'$) is provided for the concrete to fill the space under the panel as the slab concrete is placed. The lengths and width shall be determined by the Contractor and shown on the shop plans.

The Contractor is responsible for the stability of the panels on the girders. Erected panels shall be uniformly supported along the length of the panels. The Contractor is responsible for meeting the total slab thickness shown on the Superstructure Details.

All planes of reinforcing steel shown in the superstructure details are required for areas not formed with precast panels.

Computer File Information		Sheet Revisions		Colorado Department of Transportation 4701 East Arkansas Avenue, Room 330 Denver, Colorado 80222-3400 Phone: 303-757-8352 FAX: 303-757-9197		As Constructed	Precast Panel Deck Forms (Optional)	Project No./Code
Revision	Description	By	Checked By	When	Why	No Revisions	Designer: A. HABAUJ	BR 0341-053
1	Issue	MM	JVM	01/03		Revised: 4/2/04	Checker: A. HABAUJ	13488
2	Issue	MM	JVM	01/03		Revised: 4/2/04	Number	
3	Issue	MM	JVM	01/03			Structure	
4	Issue	MM	JVM	01/03			Blotter	
5	Issue	MM	JVM	01/03			Sheet Subst:	Sheet Sheets 9 of 30
6	Issue	MM	JVM	01/03				Sheet Number
7	Issue	MM	JVM	01/03				130

C-15-C Construction Drawings

PROJECT NO. 15-0000000000

DATE 03/11/1998

DESIGNER J. Anderson

DATE 03/11/1998

BRF 034-1(37)

SECTION 15-0000000000

SECTION 15-0000000000

GENERAL NOTES

STRUCTURE EXCAVATION AND BACKFILL SHALL BE IN ACCORDANCE WITH DMC, NO. B 21.

EXPANSION JOINT MATERIAL SHALL MEET AASHTO SPECIFICATION M-213.

ALL STRUCTURAL STEEL SHALL BE A570 M-183 (ASTM A-36) UNLESS OTHERWISE NOTED.

ALL REINFORCING STEEL SHALL BE A615 (ASTM A-615) UNLESS OTHERWISE NOTED.

ALL REINFORCING STEEL SHALL BE EPXY COATED UNLESS OTHERWISE NOTED.

REINFORCING BARS PLACED IN ACCORDANCE WITH SUBSECTION 802.06. THESE BRIDGE LEADERS SHALL BE INCREASED BY 25% FOR BARS SPACED AT LESS THAN 8" ON CENTER.

BAR SIZE #4 #5 #6 #7 #8 #9 #10 #11

SPICE LENGTH FOR CLASS 0 CONCRETE 1'-3" 1'-6" 1'-10" 2'-0" 3'-0" 4'-0" 5'-11" 7'-3"

PERMANENT STEEL DECK FORMS ARE REQUIRED.

THE CONTRACTOR SHALL BE RESPONSIBLE FOR THE STABILITY OF THE STRUCTURE DURING CONSTRUCTION.

FOR STRUCTURE NUMBER INSTALLATION, SEE STANDARD S-814-12.

E.F. = EACH FACE

B.F. = BACK FACE

P.F. = FRONT FACE

THE INFORMATION SHOWN ON THESE PLANS CONCERNING THE TYPE AND LOCATION OF UNDERGROUND UTILITIES IS NOT GUARANTEED TO BE ACCURATE. DETERMINATION AS TO THE TYPE AND LOCATION OF UNDERGROUND UTILITIES SHALL BE THE RESPONSIBILITY OF THE CONTRACTOR. CONTACT THE UTILITY NOTIFICATION CENTER FOR COLORADO AT 1-800-822-1687 OR 303-733-1000 FOR FURTHER INFORMATION REGARDING THE LOCATION OF UTILITIES.

EXISTING BEARING 60% EXCAVATIONS AND REINFORCING COMPANIES IN THESE PLANS ARE CALCULATED FROM THE 2% CONTRACTED PLANE. THESE STATIONS, BEING 50% ALTERNATE, AND DIMENSIONS WILL BE ADJUSTED TO MEET THE EXISTING 50% ALTERNATE PLANE. THE CONTRACTOR SHALL BE RESPONSIBLE FOR VERIFYING THE EXISTING BEARING AND DIMENSIONS IN THE FIELD BEFORE ORDERING OR FABRICATING ANY MATERIAL.

EXISTING STRUCTURE C-15-C WAS CONSTRUCTED UNDER THE FOLLOWING PRODUCT 9-84 (SHEETS 3-7, 10, 17).

DECK ELEVATIONS CONTAINED IN THESE PLANS ARE CALCULATED FROM THE 2% CONTRACTED PLANE. THESE STATIONS, BEING 50% ALTERNATE, AND DIMENSIONS WILL BE ADJUSTED TO MEET THE EXISTING 50% ALTERNATE PLANE. THE CONTRACTOR SHALL BE RESPONSIBLE FOR VERIFYING ALL DEPENDENT DIMENSIONS IN THE FIELD BEFORE ORDERING OR FABRICATING ANY MATERIAL.

DESIGN DATA

AASHTO, 15th EDITION WITH 1992 INTERIMS.

DESIGN METHOD: LOAD FACTOR DESIGN.

LIVE LOAD: AASHTO HS-20-44 AND ALTERNATE MILITARY LOADING.

DEAD LOAD: ASSUMED 4 LB/SY. PER SQ. FT. FOR PERMANENT STEEL DECK FORMS.

REINFORCED CONCRETE: $f'_c = 4,350$ PSI

CLASS 0 CONCRETE: $f'_c = 6,000$ PSI

REINFORCING STEEL: $f_y = 60,000$ PSI

PRESTRESSED CONCRETE: $f'_c = 6,000$ PSI

CLASS 3 PRECAST DECK PANELS: $f'_c = 230,000$ PSI

STRUCTURAL STEEL: AASHTO M-183 (ASTM A-36) $F_y = 35,000$.

INDEX OF DRAWINGS

GENERAL INFORMATION - SUMMARY OF QUANTITIES

DWG. NO. B 1 GENERAL INFORMATION - SUMMARY OF QUANTITIES

DWG. NO. B 2 GENERAL LAYOUT

DWG. NO. B 3 GENERAL CONSTRUCTION LAYOUT

DWG. NO. B 4 CONSTRUCTION LAYOUT

DWG. NO. B 5 ABUTMENT 1 DETAILS

DWG. NO. B 6 ABUTMENT 2 DETAILS

DWG. NO. B 7 ABUTMENT 3 DETAILS

DWG. NO. B 8 ABUTMENT 1 WINDOW DETAILS

DWG. NO. B 9 PIER 2 DETAILS

DWG. NO. B 10 PIER 1 DETAILS

DWG. NO. B 11 FRAMING PLAN - GIRDER ELEVATION

DWG. NO. B 12 INTERMEDIATE DIAPHRAGM DETAILS

DWG. NO. B 13 INTERMEDIATE DIAPHRAGM DETAILS

DWG. NO. B 14 SUPERSTRUCTURE DETAILS

DWG. NO. B 15 SUPERSTRUCTURE DETAILS

DWG. NO. B 16 BEARING DEVICE (TYPE 1)

DWG. NO. B 17 BRIDGE RAIL TYPE 10

DWG. NO. B 18 BRIDGE RAIL TYPE 10

DWG. NO. B 19 BRIDGE RAIL TYPE 10

DWG. NO. B 20 APPROACH SLAB DETAILS

DWG. NO. B 21 APPROACH SLAB DETAILS

DWG. NO. B 22 BAR LISTS

BRIDGE DESCRIPTION

2-SHAN (32'-6" - 52'-6") BRIDGE.

REPLACEMENT OF ROLLED I-BEAM GIRDER AND CONCRETE DECK.

OVER BIG THOMPSON PIER.

31'-0" ROADWAY CURBS TO CURBS, 45° 00' 00" SKREW.

1'-0" CURB TYPE 10 BRIDGE RAIL.

DEPARTMENT OF TRANSPORTATION

GENERAL INFORMATION

SUMMARY OF QUANTITIES

Station 738+00.00 to 739+10.00

Project: Eastern Park, Sec. 1, T. 5N, R. 71W

Designer: J. Anderson, Structure Number: C-15-C

Checker: R. Dickey, Number: C-15-C

Drawing Number: 1 of 22

Duplicating

SUMMARY OF QUANTITIES

ITEM NO.	DESCRIPTION	UNIT	SUPER-STRUCTURE	ABUT. 1	PIER 2	ABUT. 3	APPROACH SLABS	TOTAL
202	REMOVAL OF PORTIONS OF PRESENT STRUCTURE	L. S.						1
205	STRUCTURE EXCAVATION	CU YD					46	46
203	10' RETAINMENT EXCAVATION (SEE SUBSECTION 802.06)	TON	42				19.24	61.24
509	STRUCTURAL STEEL	LB	108,695					108,695
512	BEARING DEVICE (TYPE 1)	EA	6	6	6			18
515	WATERPROOFING (MEMBRANE)	SQ YD	379					379
601	CONCRETE CLASS 0 (BRIDGE)	CU YD	95	15	1	15	48	172
602	REINFORCING STEEL (EPXY COATED)	LB	24,873	983	135	983	8720	35,259
608	BRIDGE RAIL TYPE 10	DIR FT	240					240

① INCLUDES BOTH APPROACH SLABS.

② EXCAVATION FOR APPROACH SLABS.


③ CARRIED TO SURFACING FABRICATION.

④ WORK SHALL CONSIST OF REMOVAL OF EXISTING GIRDERS, UPPER BEARINGS, BRIDGE DECK, CURBS AND CONCRETE RAILING.

CROSS REFERENCE DRAWING NUMBER

(IF BLANK, REFERENCE IS TO SAME SHEET)

SECTION OR DETAIL IDENTIFICATION

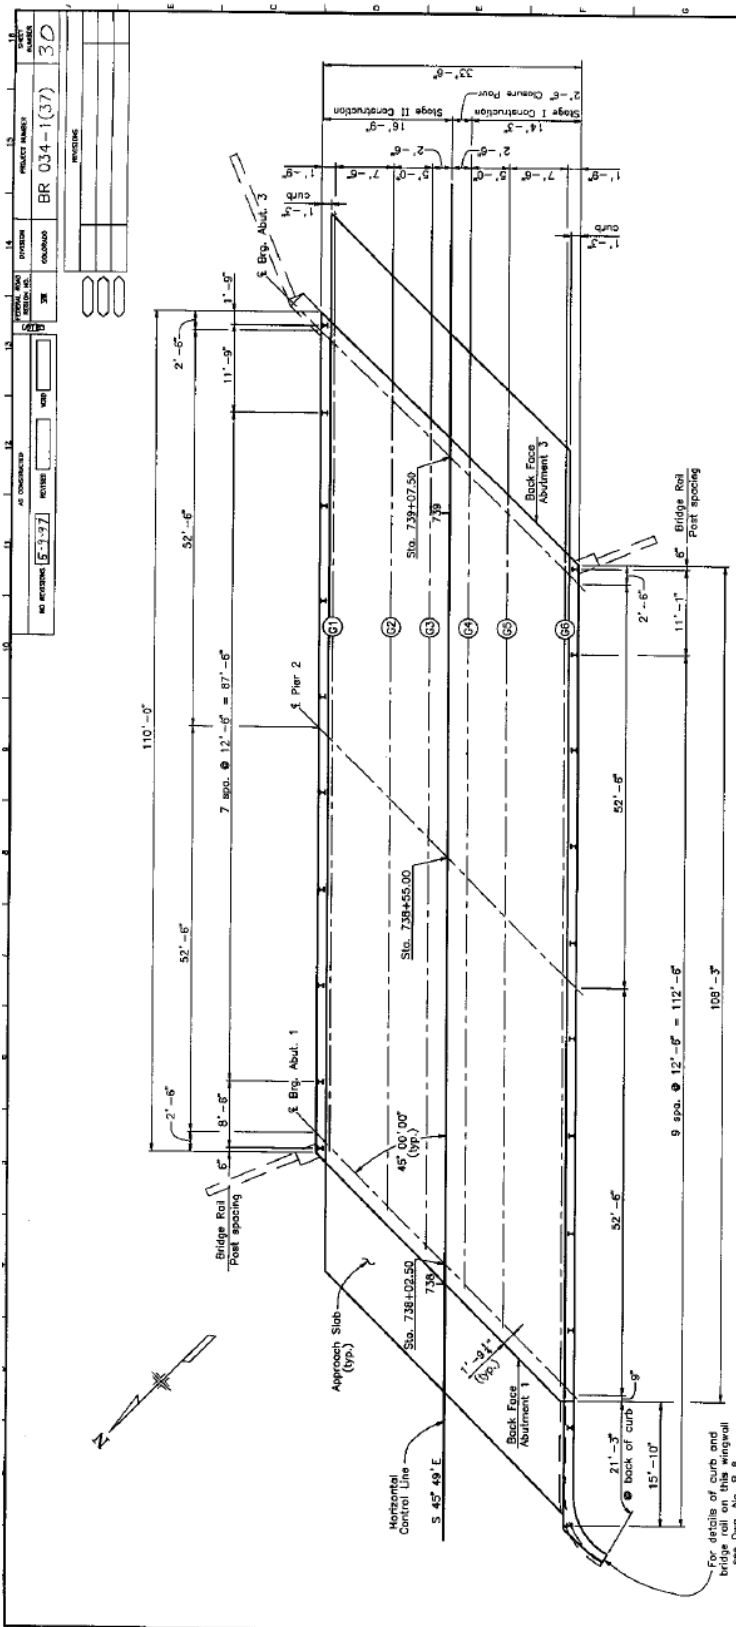

CONSTRUCTION LAYOUT

COLORADO DEPARTMENT OF TRANSPORTATION

CONSTRUCTION LAYOUT

Designer: J. Anderson
 Drafter: R. Dickey
 Drawing Number: B 4 of 22
 Structure Number: C-15-C
 Revision: 22
 Date: 11/22/1988

10 th Pt.	Abut. 1	1	2	3	4	Pier 2	6	7	8	9	Abut. 3
Left Edge of Deck	5802.49	5802.39	5802.24	5802.08	5801.99	5801.79	5801.60	5801.41	5801.26	5801.04	5800.86
Center Control Line	5803.00	5802.89	5802.76	5802.63	5802.49	5802.34	5802.18	5802.01	5801.83	5801.64	5801.45
Right Edge of Deck	5803.00	5802.83	5802.72	5802.50	5802.43	5802.30	5802.09	5801.86	5801.77	5801.62	5801.39

DECK ELEVATIONS



Deck elevations are at top of concrete deck.

For details of curb and bridge rail see original spec. No. B 8.

DESIGNED BY: J.A.A. (2/79)	CHECKED BY: J.A.D. (2/83)
DRAWN BY: J.A.A. (2/79)	CHECKED BY: J.A.D. (2/83)
IN CHARGE: J.A.A. (2/79)	CHECKED BY: J.A.D. (2/83)
DATE: 11/22/1988	SCALE: AS SHOWN

NO. REVISIONS	DATE	BY	REASON
5	5-3-77		
4			
3			
2			
1			

TOTAL PAGES	DATE	PROJECT NUMBER
37		BR 034-1(57)

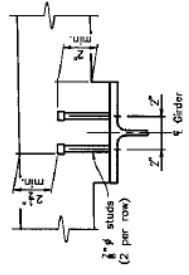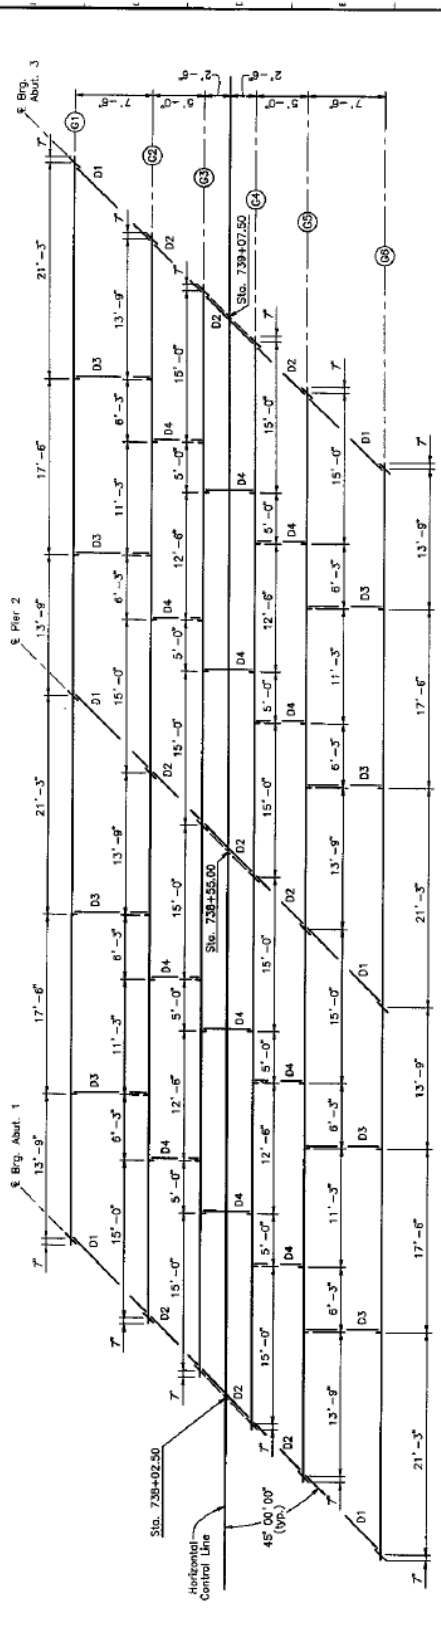


SHEAR CONNECTOR DETAIL

Shear Connector Stud spacing
See Detail this sheet

Cut end of girder
at 45° slope
(typ.)

FRAMING PLAN

GIRDER ELEVATION

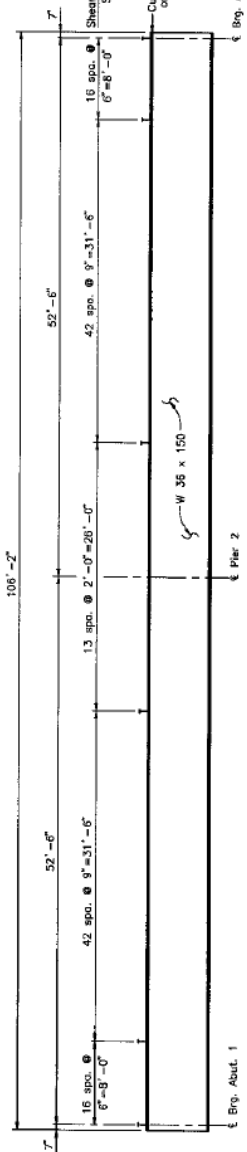

COLORADO
DEPARTMENT OF TRANSPORTATION

FRAMING PLAN AND
GIRDER ELEVATION


Designer	J. Anderson	Structural	C-15-C
Detailer	R. Decker	Number	
Drawing Number	B 11 of 22	Drawings	
Revision Date	(Prepared) (See Note)		

DESIGNED BY	J.A.A.	DATE	12/75
CHECKED BY	R.A.D.	DATE	1/76
APPROVED BY	R.A.D.	DATE	2/76
CONTRACT NO.	10-6000(0)000000(0)000000		

NO REVISIONS	5-3-77	BY	DATE
NO REVISIONS		BY	DATE
NO REVISIONS		BY	DATE
NO. OF SHEETS	38
PROJECT NUMBER	BR 034-1(37)
DATE	04/03/00
DESIGNED BY	J.A.S.
CHECKED BY	J.A.S.
IN CHARGE	J.A.S.
DATE	04/03/00

DESIGNED BY: J.A.S.
 CHECKED BY: J.A.S.
 IN CHARGE: J.A.S.
 DATE: 04/03/00

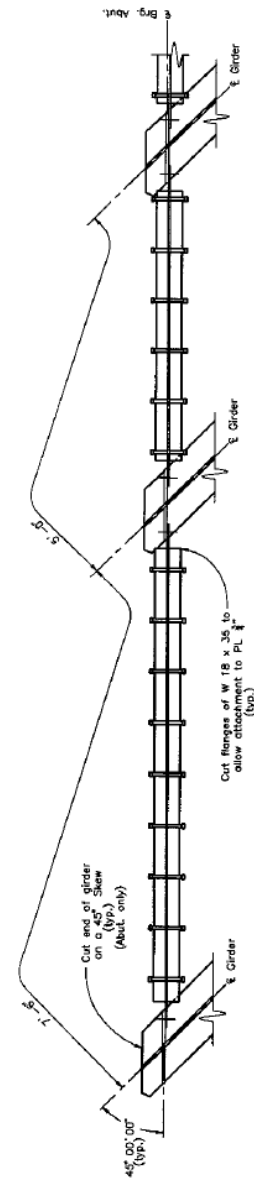


SECTION 3

Section of Pier 2 is identical except for the shear studs on Pier Bearing Diaphragm. There are no shear studs on Pier Bearing Diaphragm.




SECTION 2

$PL \frac{3}{4} \times 4 \frac{1}{2} \times 5$ (typ.)
 $\frac{3}{4}$ H.S. Bolt (tot. 2)(typ.)

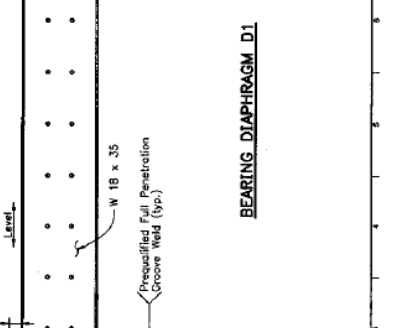

BEARING DIAPHRAGM D1

$PL \frac{3}{4} \times 8$ (typ.)
 $\frac{3}{4}$ H.S. Bolt (tot. 8)(typ.)
 W 18 x 35
 Cut Ranges of W 18 x 35 to allow attachment to $PL \frac{3}{4}$ (typ.)

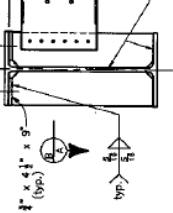

BEARING DIAPHRAGM D2

$PL \frac{3}{4} \times 8$ (typ.)
 $\frac{3}{4}$ H.S. Bolt (tot. 8)(typ.)
 W 18 x 35
 Cut Ranges of W 18 x 35 to allow attachment to $PL \frac{3}{4}$ (typ.)


04/03/1998 10:08:10 AM WORKING (12) COLO.DWG

DATE	04/03/00
BY	J.A.S.
CHECKED BY	J.A.S.
IN CHARGE	J.A.S.

DESIGNED BY: J.A.S.
 CHECKED BY: J.A.S.
 IN CHARGE: J.A.S.
 DATE: 04/03/00

COLORADO
 DEPARTMENT OF TRANSPORTATION
 BEARING DIAPHRAGM DETAILS

Designer: J. Anderson
 Detailer: R. Dickey
 Drawing Number: B-12 of 22
 Structure Numbers: C-15-C
 Revision: 04/03/00

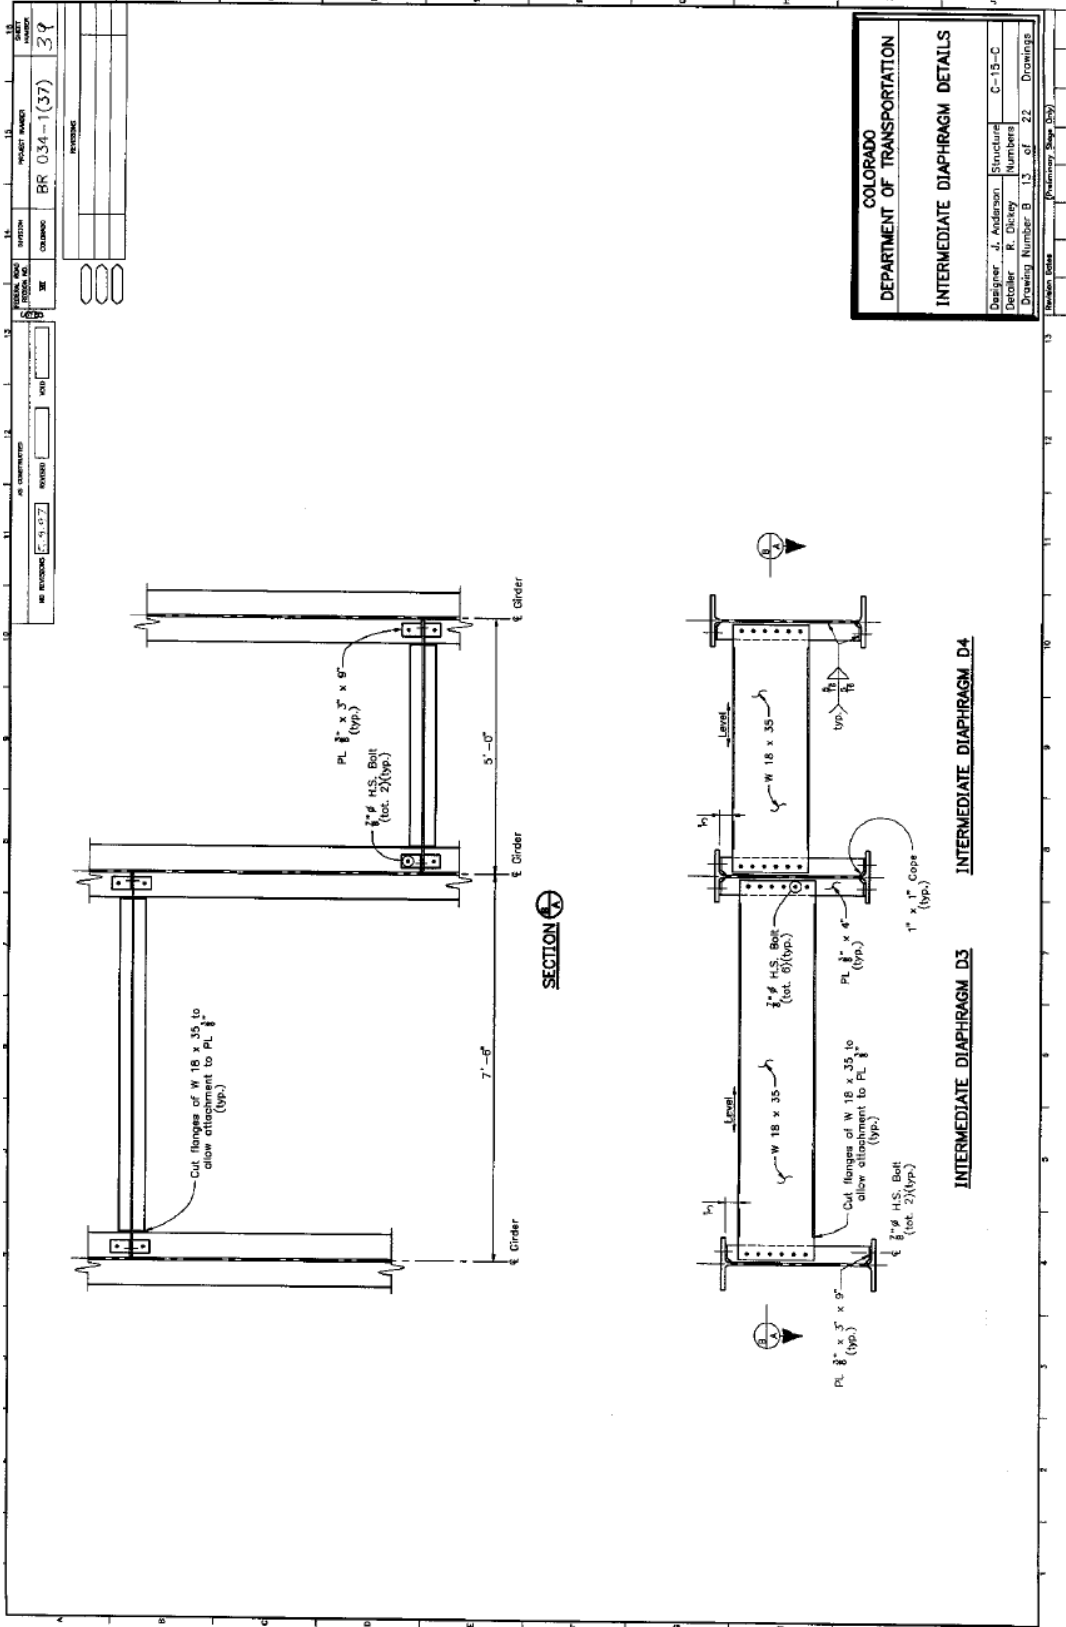

DESIGNER	DATE	PROJECT NUMBER	SCALE
J.A.A.	12/25	BR 034-1(37)	3/4"
DRAWN BY	DATE	PROJECT NUMBER	SCALE
R.B.	12/25	BR 034-1(37)	3/4"
CHECKED BY	DATE	PROJECT NUMBER	SCALE
R.B.	12/25	BR 034-1(37)	3/4"
APPROVED BY	DATE	PROJECT NUMBER	SCALE
R.B.	12/25	BR 034-1(37)	3/4"

COLORADO
DEPARTMENT OF TRANSPORTATION


INTERMEDIATE DIAPHRAGM DETAILS

Designer	J. Anderson	Structural Numbers	C-15-C
Detailer	R. Dickey	Drawing Number	B 13 of 22 Drawings

Revision Table
 (Primary Shop 189)


Checked	DATE	INITIALS
Drawn	DATE	INITIALS
Designed	DATE	INITIALS
Checked	DATE	INITIALS
Designed	DATE	INITIALS
Checked	DATE	INITIALS

PROJECT NUMBER: BR 034-1(37)
 DRAWING NUMBER: 40
 SHEET NUMBER: 14 of 22
 PROJECT TITLE: SUPERSTRUCTURE DETAILS

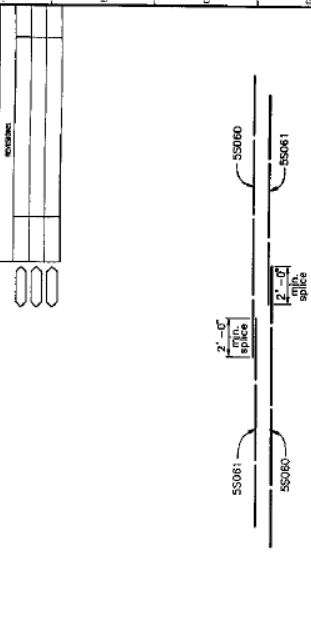


BOTTOM OF DECK LONGITUDINAL REINFORCING DETAIL
 Alternate longitudinal lines to stagger splices as shown.

PERMANENT STEEL DECK FORM DETAIL

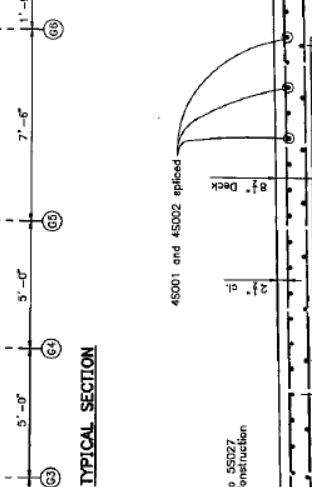

REINFORCING DETAIL

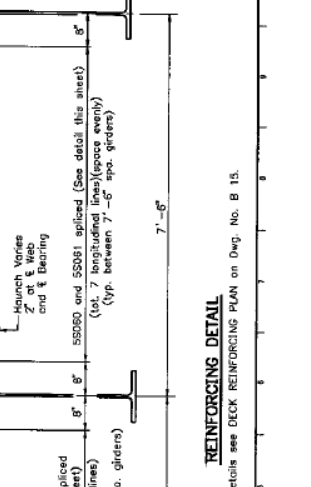

For additional details see DECK REINFORCING PLAN on Dwg. No. B 15.

COLORADO
DEPARTMENT OF TRANSPORTATION
SUPERSTRUCTURE DETAILS

Designer: J. Anderson
 Checker: R. Doney
 Structure Number: C-15-C
 Drawing Number: 14 of 22
 Revision:

NO.	DATE	BY	DESCRIPTION
1	1/25/85	W.A.D.	Checked by
2	2/20/85	M.A.D.	Drawn by
3	3/29/85	M.A.D.	Quantity by
4	7/29/85	R.A.T.	Checked by
5	7/29/85	R.A.T.	Checked by

C-15-AN Construction Drawings

GENERAL NOTES

WHERE INDICATED, BACKFILL SHALL BE AS SHOWN ON THE PLANS EXCEPT SHORING SHALL BE REQUIRED FOR EXCAVATION UNLESS NOTED OTHERWISE. TEMPORARY EXCAVATION SUPPORT SHALL BE PAID FOR BY ITEM 206 SHORING.

EXPANSION JOINT MATERIAL SHALL MEET AASHTO SPECIFICATION M21.

A COLORED STRUCTURAL CONCRETE STAIN FINISH WILL BE REQUIRED, AS SHOWN ON THE PLANS, ON EXPOSED CONCRETE SURFACES. THE COLOR SHALL BE BEIGE, EQUIVALENT TO FEDERAL STANDARD COLOR NO. 33445, AND IS TO BE SELECTED FROM TEST PANELS PROVIDED BY THE CONTRACTOR. STAIN SHALL EXTEND TO 1 FOOT BELOW TOP OF ASPHALT AND 6 INCHES BELOW TOP OF CURB.

LEVELING PADS ARE UNWARRANTED BEARINGS. THEY SHALL BE CUT OR MOULDED FROM ASPH/TO BE DESCRIBED IN TABLES 705-1 AND 705-2 WITH A DOWELBAR (GRADE 60) HARDNESS OF 60.

GRADE 60 REINFORCING STEEL IS REQUIRED.

ALL REINFORCING STEEL SHALL BE EPOXY COATED UNLESS OTHERWISE NOTED.

① INDICATES NON COATED REINFORCING STEEL.

ALL THE PROVISIONS FOR BRIDGE DECK CONCRETE SHALL ALSO APPLY TO APPROACH SLAB CONCRETE.

THE FOLLOWING TABLE GIVES THE MINIMUM LAP SPlice LENGTH FOR EPOXY COATED REINFORCING BARS PLACED IN ACCORDANCE WITH SUBSECTION 802.06. THESE SPlice LENGTHS SHALL BE INCREASED BY 25% FOR BARS SPACED AT LESS THAN 6" ON CENTER.

BAR SIZE	#4	#5	#6	#7	#8	#9	#10	#11
SPlice LENGTH FOR CLASS D CONCRETE	1'-3"	1'-7"	2'-0"	2'-4"	3'-0"	4'-0"	5'-11"	7'-3"

WHEN THE CONTRACTOR ELECTS TO SUBSTITUTE EPOXY COATED REINFORCEMENT FOR BLACK REINFORCING BARS, THE MINIMUM LAP SPlice SHALL BE AS DESCRIBED ABOVE.

THE FOLLOWING TABLE GIVES THE MINIMUM LAP SPlice LENGTH FOR BLACK REINFORCING BARS PLACED IN ACCORDANCE WITH SUBSECTION 802.06. THESE SPlice LENGTHS SHALL BE INCREASED BY 25% FOR BARS SPACED AT LESS THAN 6" ON CENTER.

BAR SIZE	#4	#5	#6	#7	#8	#9	#10	#11
SPlice LENGTH FOR CLASS D CONCRETE	1'-4"	1'-7"	1'-10"	2'-5"	3'-1"	3'-11"	4'-10"	

THE ABOVE SPlice LENGTHS MAY BE REDUCED BY 20% WHEN 3" OF CLEAR COVER EXISTS AND BAR SPACING IS 6" OR GREATER ON CENTER.

WHERE THE LAP LENGTH LISTED CANNOT BE ATTAINED, OR AS NOTED ON THE PLANS, A MECHANICAL COUPLER (SPliced) SHALL BE USED. MECHANICAL COUPLERS (SPiless) SHALL DEVELOP 100% OF THE YIELD STRENGTH OF THE REINFORCING BARS TO WHICH THEY ARE ATTACHED IN BOTH TENSION AND COMPRESSION. EPOXY COATING SHALL BE REMOVED PRIOR TO INSTALLATION OF MECHANICAL COUPLERS. THE CONTRACTOR SHALL BE RESPONSIBLE FOR THE INSTALLATION OF THE SAME SHALL BE INCLUDED IN THE COST OF THE WORK.

THE CONTRACTOR SHALL BE RESPONSIBLE FOR THE STABILITY OF THE STRUCTURE DURING CONSTRUCTION.

EQ = EQUALLY
 AH = HEAD
 HCL = HORIZONTAL CONTROL LINE
 HCV = HORIZONTAL CONTROL LINE
 BK = BACK FACE
 BF = BACK FACE
 C = CENTER LINE
 CLR = CLEAR STRUCTURE
 CLN = CONTINUOUS
 DWG = DRAWING
 ELEV = ELEVATION

GENERAL NOTES (CONT.)

FOR STRUCTURE NUMBER INSTALLATION, SEE STANDARD S-81412.

ALL CONCRETE IN CONTACT WITH SOIL SHALL MEET CLASS C SULFATE EXPOSURE.

STATISTICS, ELEVATIONS AND DIMENSIONS CONTAINED IN THESE PLANS ARE CALCULATED FROM A RECENT FIELD SURVEY. THE CONTRACTOR SHALL VERIFY ALL DIMENSIONAL DIMENSIONS IN THE FIELD BEFORE ORDERING OR FABRICATING ANY MATERIAL.

THE LOCATION OF THE FOUNDATIONS FOR THE EXISTING BRIDGE AS SHOWN IN THE PLANS WERE TAKEN FROM THE AS BUILT PLANS AND ARE APPROXIMATE.

THE INFORMATION SHOWN ON THESE PLANS CONCERNING THE TYPE AND LOCATION OF UNDERGROUND UTILITIES IS FOR INFORMATION ONLY. THE CONTRACTOR IS RESPONSIBLE FOR MAKING HIS OWN DETERMINATION AS TO THE TYPE AND LOCATION OF UNDERGROUND UTILITIES AS MAY BE NECESSARY TO AVOID DAMAGE THERE TO. THE CONTRACTOR SHALL CONTACT THE UTILITY NOTIFICATION CENTER OF COLORADO AT 1-800-455-2846 FOR A LIST OF UTILITIES AND NOT INCLUDING THE DATE OF NOTIFICATION PRIOR TO ANY EXCAVATION OR OTHER CONSTRUCTION.

CONSTRUCTION OPTION NOTES

THE CONTRACTOR HAS THE OPTION TO CONSTRUCT THE BRIDGE BY EITHER ALTERNATE 1 OR ALTERNATE 2 AS SHOWN IN THE PLANS:

ALTERNATE 1 - BRIDGE IS TO BE REMOVED AND RECONSTRUCTED IN TWO PHASES WHILE MAINTAINING TRAFFIC AS SHOWN IN THE PLANS.

ALTERNATE 2 - BRIDGE IS TO BE REPLACED IN A SINGLE PHASE WHILE MAINTAINING TRAFFIC ON A TEMPORARY BRIDGE AS SHOWN IN THE PLANS.

IF ALTERNATE 2 IS SELECTED, THE CONSTRUCTION JOINTS FOR PHASED BRIDGE CONSTRUCTION SHALL BE LOCATED AT THE APPROACH SLABS, PIERS AND DECK AND THEIR ASSOCIATED MECHANICAL COUPLERS MAY BE OMITTED.

epoxy coated rather than black bars.

GENERAL NOTES

WHERE INDICATED, BACKFILL SHALL BE AS SHOWN ON THE PLANS EXCEPT SHORING SHALL BE REQUIRED FOR EXCAVATION UNLESS NOTED OTHERWISE. TEMPORARY EXCAVATION SUPPORT SHALL BE PAID FOR BY ITEM 206 SHORING.

EXPANSION JOINT MATERIAL SHALL MEET AASHTO SPECIFICATION M21.

A COLORED STRUCTURAL CONCRETE STAIN FINISH WILL BE REQUIRED, AS SHOWN ON THE PLANS, ON EXPOSED CONCRETE SURFACES. THE COLOR SHALL BE BEIGE, EQUIVALENT TO FEDERAL STANDARD COLOR NO. 33445, AND IS TO BE SELECTED FROM TEST PANELS PROVIDED BY THE CONTRACTOR. STAIN SHALL EXTEND TO 1 FOOT BELOW TOP OF ASPHALT AND 6 INCHES BELOW TOP OF CURB.

LEVELING PADS ARE UNWARRANTED BEARINGS. THEY SHALL BE CUT OR MOULDED FROM ASPH/TO BE DESCRIBED IN TABLES 705-1 AND 705-2 WITH A DOWELBAR (GRADE 60) HARDNESS OF 60.

GRADE 60 REINFORCING STEEL IS REQUIRED.

ALL REINFORCING STEEL SHALL BE EPOXY COATED UNLESS OTHERWISE NOTED.

① INDICATES NON COATED REINFORCING STEEL.

ALL THE PROVISIONS FOR BRIDGE DECK CONCRETE SHALL ALSO APPLY TO APPROACH SLAB CONCRETE.

THE FOLLOWING TABLE GIVES THE MINIMUM LAP SPlice LENGTH FOR EPOXY COATED REINFORCING BARS PLACED IN ACCORDANCE WITH SUBSECTION 802.06. THESE SPlice LENGTHS SHALL BE INCREASED BY 25% FOR BARS SPACED AT LESS THAN 6" ON CENTER.

BAR SIZE	#4	#5	#6	#7	#8	#9	#10	#11
SPlice LENGTH FOR CLASS D CONCRETE	1'-3"	1'-7"	2'-0"	2'-4"	3'-0"	4'-0"	5'-11"	7'-3"

WHEN THE CONTRACTOR ELECTS TO SUBSTITUTE EPOXY COATED REINFORCEMENT FOR BLACK REINFORCING BARS, THE MINIMUM LAP SPlice SHALL BE AS DESCRIBED ABOVE.

THE FOLLOWING TABLE GIVES THE MINIMUM LAP SPlice LENGTH FOR BLACK REINFORCING BARS PLACED IN ACCORDANCE WITH SUBSECTION 802.06. THESE SPlice LENGTHS SHALL BE INCREASED BY 25% FOR BARS SPACED AT LESS THAN 6" ON CENTER.

BAR SIZE	#4	#5	#6	#7	#8	#9	#10	#11
SPlice LENGTH FOR CLASS D CONCRETE	1'-4"	1'-7"	1'-10"	2'-5"	3'-1"	3'-11"	4'-10"	

THE ABOVE SPlice LENGTHS MAY BE REDUCED BY 20% WHEN 3" OF CLEAR COVER EXISTS AND BAR SPACING IS 6" OR GREATER ON CENTER.

WHERE THE LAP LENGTH LISTED CANNOT BE ATTAINED, OR AS NOTED ON THE PLANS, A MECHANICAL COUPLER (SPliced) SHALL BE USED. MECHANICAL COUPLERS (SPiless) SHALL DEVELOP 100% OF THE YIELD STRENGTH OF THE REINFORCING BARS TO WHICH THEY ARE ATTACHED IN BOTH TENSION AND COMPRESSION. EPOXY COATING SHALL BE REMOVED PRIOR TO INSTALLATION OF MECHANICAL COUPLERS. THE CONTRACTOR SHALL BE RESPONSIBLE FOR THE INSTALLATION OF THE SAME SHALL BE INCLUDED IN THE COST OF THE WORK.

THE CONTRACTOR SHALL BE RESPONSIBLE FOR THE STABILITY OF THE STRUCTURE DURING CONSTRUCTION.

EQ = EQUALLY
 AH = HEAD
 HCL = HORIZONTAL CONTROL LINE
 HCV = HORIZONTAL CONTROL LINE
 BK = BACK FACE
 BF = BACK FACE
 C = CENTER LINE
 CLR = CLEAR STRUCTURE
 CLN = CONTINUOUS
 DWG = DRAWING
 ELEV = ELEVATION

INDEX OF DRAWINGS

- 01 GENERAL INFORMATION
- 02 GENERAL INFORMATION
- 03 GENERAL LAYOUT
- 04 CONSTRUCTION PHASING ALTERNATE 1 - SECTIONS
- 05 CONSTRUCTION PHASING ALTERNATE 1 - TEMP. BARRIER DETAILS
- 06 CONSTRUCTION PHASING ALTERNATE 2 - SECTIONS
- 07 CONSTRUCTION PHASING ALTERNATE 2 - PLAN
- 08 CONSTRUCTION PHASING ALTERNATE 2 - TEMP. BRIDGE DETAILS
- 09 BRIDGE HYDRAULIC INFORMATION (1 OF 2)
- 10 BRIDGE HYDRAULIC INFORMATION (2 OF 2)
- 11 CONSTRUCTION LAYOUT
- 12 APPROACH SLAB DETAILS
- 13 ABUTMENT 1 DETAILS
- 14 ABUTMENT 4 DETAILS
- 15 ABUTMENT DETAILS
- 16 PIER DETAILS (1 OF 2)
- 17 PIER DETAILS (2 OF 2)
- 18 BEARING DETAILS
- 19 BRIDGE DECK CONCRETE BOX GIRDER
- 20 SUPERSTRUCTURE DETAILS
- 21 BRIDGE RAIL TYPE IWM
- 22 BRIDGE EXPANSION DEVICE (D-2, INCH)
- 23 BRIDGE DRAIN DETAILS (2 OF 2)
- 24 MECHANICALLY STABILIZED BACKFILL
- 25 BRIDGE DECK ELEVATIONS (D OF 5)
- 26 BRIDGE DECK ELEVATIONS (D OF 5)
DESIGN DATA

ASHTO, FOURTH EDITION LRFD.

DESIGN METHOD: LOAD AND RESISTANCE FACTOR DESIGN

LIVE LOAD: HL-93 (DESIGN TRUCK OR TANDEN) AND DESIGN LANE (LOAD) DEAD LOAD: ASSUMES 38 LBS. PER SQ. FT. FOR BRIDGE DECK OVERLAY

REINFORCED CONCRETE: $f_c = 4,500$ psi
 $f_y = 60,000$ psi

REINFORCING STEEL: CLASS 87 CONCRETE: $f_c = 4,000$ psi
 $f_y = 60,000$ psi

PRECAST STRESSING CONCRETE: CLASS PS CONCRETE: $f_c =$ (SEE DETAILS)
 $f_s = 270,000$ psi

CONCRETE BOX GIRDER CONTINUOUS STRESSING OVER BIG THOMPSON RIVER

47'-6" ROADWAY OVERALL WIDTH 60'-0" SKIN, 1'-6" TYPE IWM BRIDGE RAIL

SECTION OF DETAIL IDENTIFICATION

CROSS REFERENCE DRAWING NUMBER

(IF BLANK REFERENCE IS TO SAME SHEET)

SECTION OR DETAIL IDENTIFICATION

GENERAL INFORMATION

Project No./Code: BR 0341-069

Structure Number: C-15-AN

Sheet Number: 35

Sheet Subst: BRIDGE

Sheet Sheets: 81 of 38

Designer: J. Simmons

Checker: S. Flordon

Scale: 1/32" = 1'-0"

Revision: 1/3/07




Void:

Colorado Department of Transportation

2207 East Highway 402
 Phone 970-662-1266 FAX: 970-669-0289

Region 4

DMM/MLR

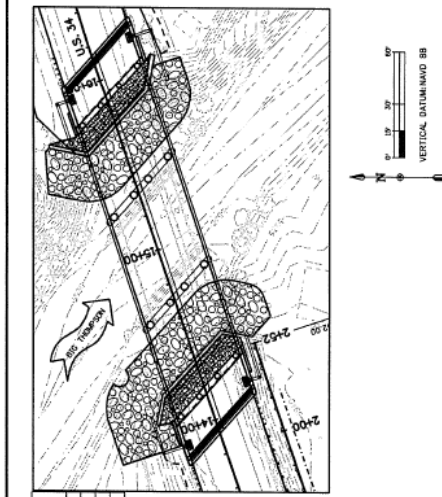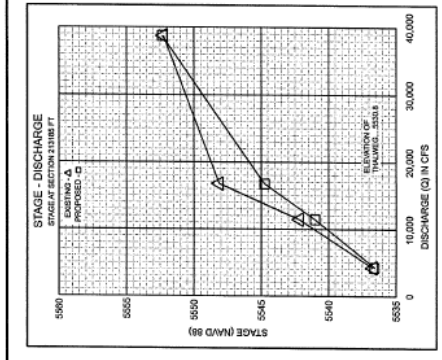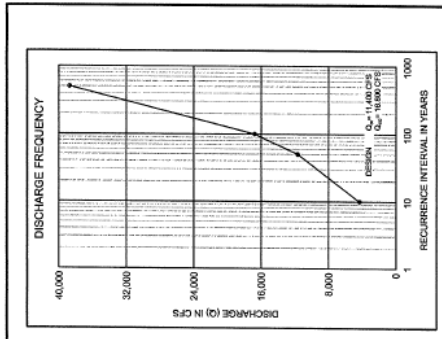

HYDRAULIC DATA TABLE


RECURRING INTERVAL (YRS)	Q AT OVERFLOW VELOCITY (CFS)	WETTED ROAD AREA (SQ FT)	WETTED ROAD SCOUR ELEV. (FT - NAVD83)	WETTED ROAD SCOUR ELEV. (FT - NAVD83)	EXISTING RIVER SCOUR ELEV. (FT - NAVD83)
10	4,200	0	11.03	5536.35	-
50	11,800	0	14.79	5541.01	-
100	16,800	0	14.28	5544.75	5512.3
500	24,940	14,154	14.42	5551.94	5512.3

HYDRAULIC DATA:
 DRAINAGE AREA = 300 SQ MILES
 AVERAGE CHANNEL SLOPE = 0.012 FT/FT
 CHANNEL = 0.035 - 0.04
 MANNING'S 'N' OVERBANK = 0.05 - 0.06

DESIGN FLOW = 16,800 CFS, 100-YEAR
 DEBRIS: BRUSH LOGS DICE
 SOURCE OF HYDROLOGY: FLOOD FREQUENCY RELATIONSHIP BASED ON THE COMPARISON OF 50-YR HYDRAULICS 100 FT UPSTREAM OF BOTH EXISTING AND PROPOSED STRUCTURES.

VELOCITY: EXISTING 10.17 FPS PROPOSED 14.26 FPS
 FRICTION: EXISTING 12.83 FPS PROPOSED 14.79 FPS
 CHANNEL STABILITY: EXISTING 0.0 FT PROPOSED 0.0 FT

GEOTECHNICAL DATA:
 BOTTOM MATERIAL: COHESIVE
 STREAM PLANFORM: STRAIGHT
 CHANNEL STABILITY: STABLE
 ICE: YES

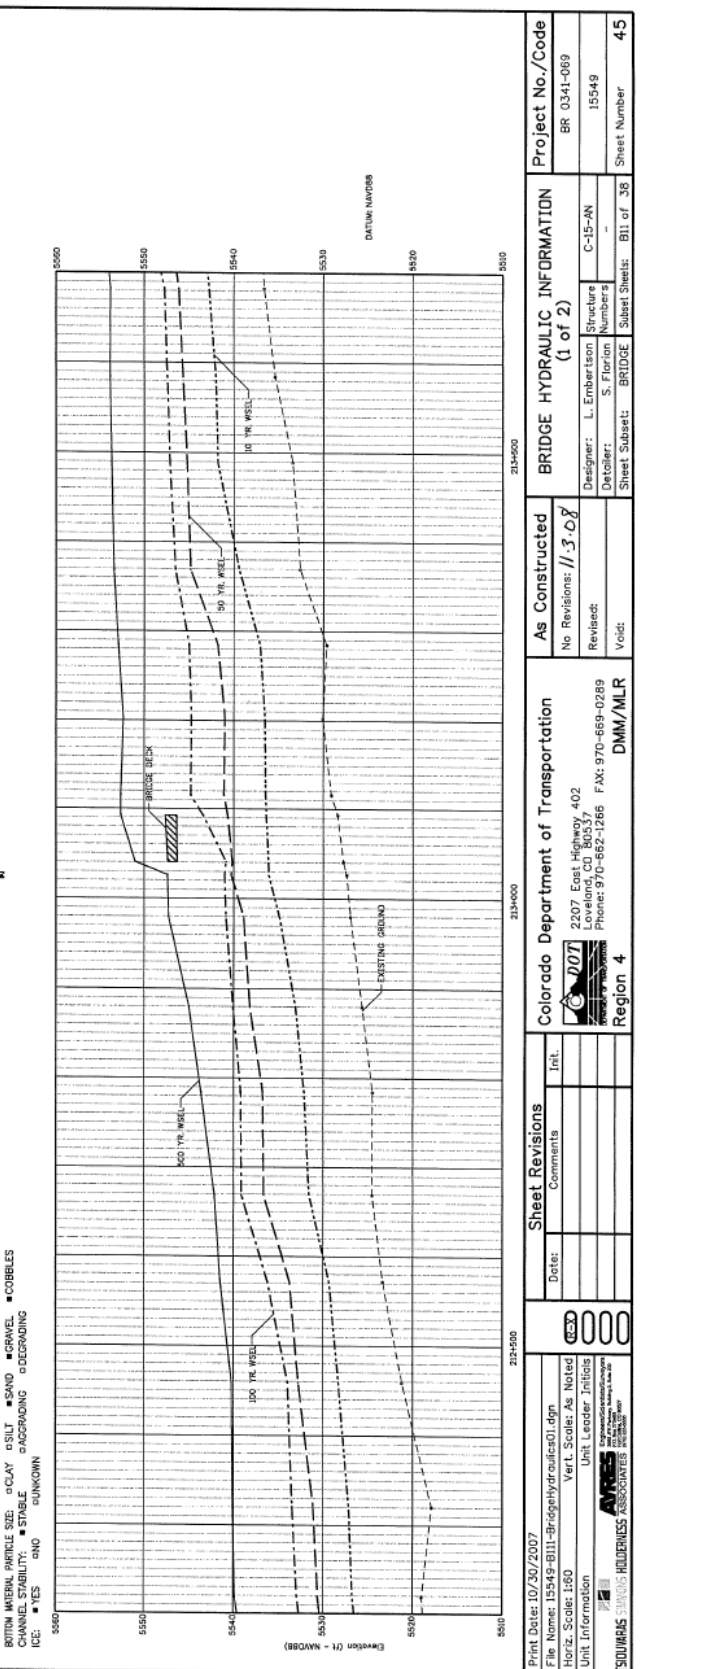



Print Date: 10/30/2007
 File Name: 15549-B111-bridgehydraulic01.dgn
 Horiz. Scale: 1:50
 Unit Information: Unit Leader: Initials

Colorado Department of Transportation
 2207 East Highway 402
 Loveland, CO 80537
 Phone: 970-682-1266 FAX: 970-669-0289
 DMM/MLR
 Region 4

As Constructed
 No Revisions: 11-3-08
 Revised: S. Florian
 Void:


BRIDGE HYDRAULIC INFORMATION
 (1 of 2)
 Designer: L. Emberton
 Detailer: S. Florian
 Sheet Subject: BRIDGE
 Subject Sheets: B11 of 36

Project No./Code
 BR 0341-069
 15549
 Sheet Number 45

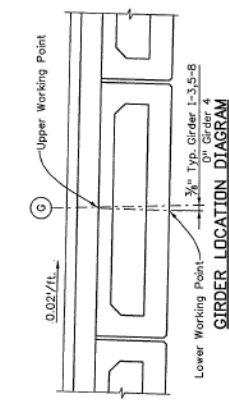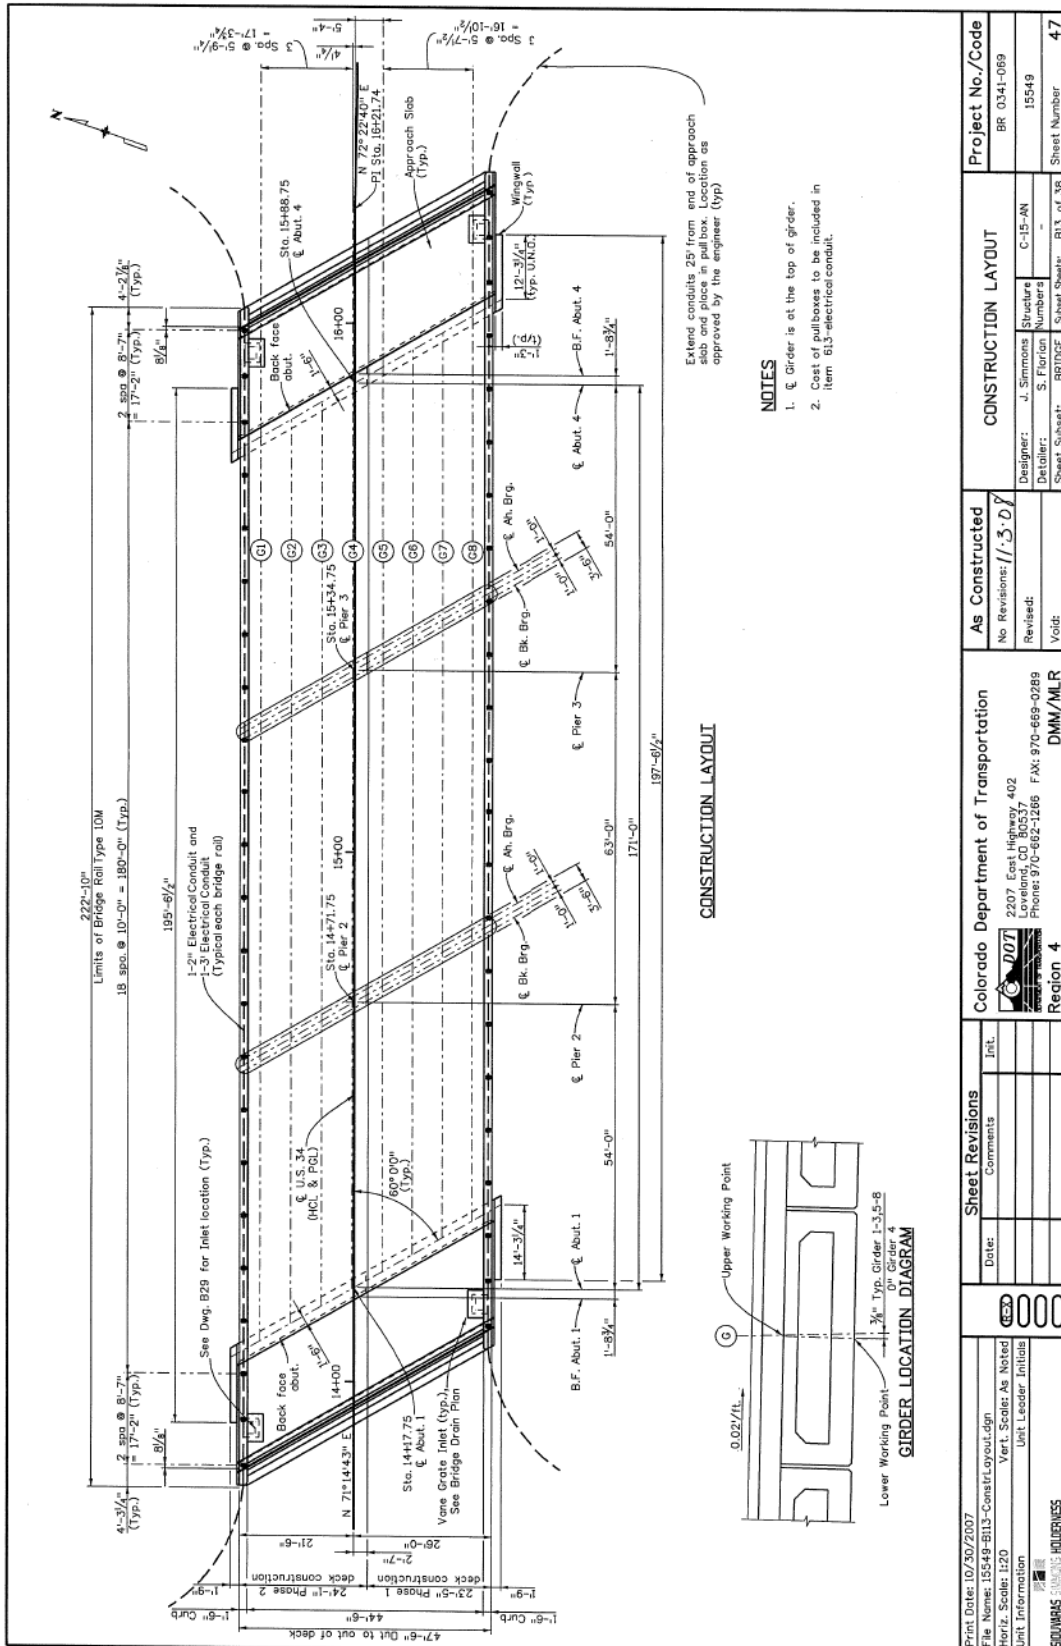

Print Date: 10/30/2007 File Name: 15549-B13-Const/Layout.dgn Horiz. Scale: 1/20 Unit Information: Vert. Scale: As Noted, Unit Leader Initials		Sheet Revisions Date: _____ Comments: _____ Int.: _____		Colorado Department of Transportation 2207 East Highway 402 Loveland, CO 80537 Phone: 970-602-1286 FAX: 970-669-0289 Region 4 DMM/MLR		As Constructed No Revisions: 1/3/07 Revised: _____ Void: _____		CONSTRUCTION LAYOUT Designer: J. Simmons Structure: C-15-AN Detailer: S. Florian Numbers: _____ Sheet Subset: BRIDGE Sub Sheet: B13 of 36		Project No./Code BR 0341-089 15549 Sheet Number: 47	
--------------------------------------------------------------------------------------------------------------------------------------------------------	--	-------------------------------------------------------------------------	--	----------------------------------------------------------------------------------------------------------------------------------------------------------	--	--------------------------------------------------------------------------------	--	--------------------------------------------------------------------------------------------------------------------------------------------------------------------	--	---------------------------------------------------------------------	--

Design	DATE	INITIALS	DATE	INITIALS	DATE	INITIALS		
Checked By	LT	08/07	Checked By	JMS	08/07	Checked By	LT	08/07
Designed By	JMS	07/07	Checked By	SG	08/07	Checked By	LT	08/07

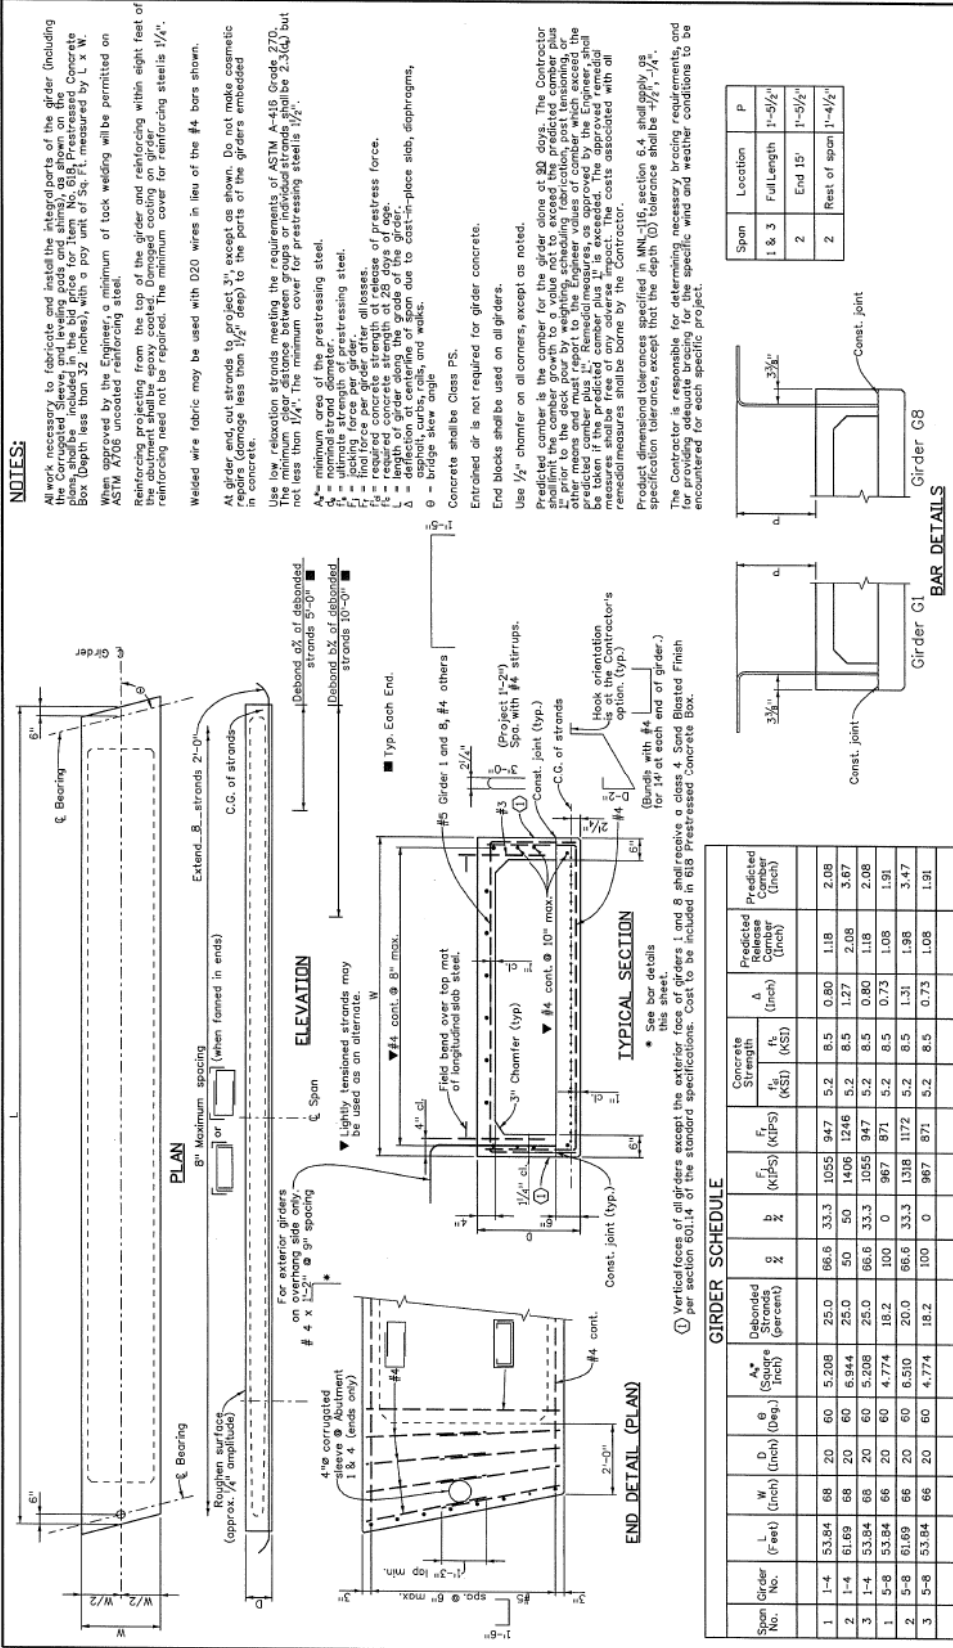


NOTES:
 All work necessary to fabricate and install the integral parts of the girder (including the Corrugated Sleeve and leveling pods and struts), as shown on the drawings, shall be included in the Bid. Concrete shall be placed in the Concrete Box (Depth less than 32 inches), with a pay unit of Sq.Ft. measured by L x W.
 When specified by the Engineer, a minimum of tack welding will be permitted on ASTM A706 uncoated reinforcing steel.
 Reinforcing projecting from the top of the girder and reinforcing within eight feet of the bottom of the girder shall be protected. The minimum cover for reinforcing steels is 1/4".
 Welded wire fabric may be used with D20 wires in lieu of the #4 bars shown.
 At girder end, cut strands to project 3", except as shown. Do not make cosmetic repairs (damage less than 1/2" deep) to the parts of the girders embedded in concrete.
 Use low relaxation strands meeting the requirements of ASTM A-416 Grade 270. The minimum clear distance between groups or individual strands shall be 2.3(d) but not less than 1/4". The minimum cover for prestressing steels is 1/2".
 A_p = minimum area of the prestressing steel.
 A_{ps} = ultimate strength of prestressing steel.
 F_{ps} = locking force per girder.
 F_{pi} = initial force per girder after all losses.
 f_{ps} = required concrete strength at 28 days of age.
 L = length of girder along the grade of the girder.
 Δ = depth of curb, rails, and walks.
 θ = bridge skew angle.
 Concrete shall be Class PS.
 Entrained air is not required for girder concrete.
 End blocks shall be used on all girders.
 Use 1/2" chamfer on all corners, except as noted.
 Predicted camber is the camber for the girder alone at 30 days. The Contractor shall be responsible for determining necessary bracing requirements, and prior to the deck pour by weighing, scheduling fabrication, post tensioning, or other means and must report to the Engineer values of camber which exceed the predicted camber plus 1/4". The Contractor shall be responsible for all measures shall be free of any adverse impact. The costs associated with all remedial measures shall be borne by the Contractor.
 Product dimensional tolerances specified in MN-116, section 5.4 shall apply as specification tolerance, except that the depth (D) tolerance shall be +1/2", -1/4".
 The Contractor is responsible for determining necessary bracing requirements, and for providing adequate bracing for the specific wind and weather conditions to be encountered for each specific project.

Design	DATE	INITIAL	DATE	INITIAL	DATE	INITIAL	DATE
Checked by	LIT	08/07	Checked by	MS	08/07	Checked by	MS
Checked by	SK	08/07	Checked by	MS	08/07	Checked by	MS
Checked by	SK	08/07	Checked by	MS	08/07	Checked by	MS


File Name: 15549-g122-B-616-9X.dgn		Print Date: 10/30/2007	
Horiz. Scale: 1:1		Vert. Scale: As Noted	
Unit Information		Unit Leader: Initials	
TSOUVARIS		TSOUVARIS	
Date:		Date:	
Comments		Comments	
AS Constructed // 3.08.08		As Constructed	
Revised:		Revised:	
Void:		Void:	
No Revisions: 1/3.08.08		No Revisions: 1/3.08.08	
Designer: C. Kline		Designer: C. Kline	
Detailer: P. Hernandez		Detailer: P. Hernandez	
Structure Numbers: 15549		Structure Numbers: 15549	
Sheet Subst: BRIDGE		Sheet Subst: BRIDGE	
Subst Sheets: B22 of 38		Subst Sheets: B22 of 38	
Project No./Code		Project No./Code	
BR 0341-069		BR 0341-069	
PRESTRESSED CONCRETE BOX GIRDER		PRESTRESSED CONCRETE BOX GIRDER	

Span No.	Girder No.	L (Feet)	W (Inch)	D (Inch)	θ (Square Inch)	A _p * (Square Inch)	Debonded Strands (percent)	g	b	F (KIPS)	f _{ps} (KSI)	f _c (KSI)	Concrete Strength (KSI)	Δ (Inch)	Predicted Release Camber (Inch)	Predicted Camber (Inch)
1	1-4	53.84	68	20	60	5.208	25.0	66.8	33.3	1055	947	5.2	8.5	0.80	1.18	2.08
2	1-4	61.69	68	20	60	6.944	25.0	50	1406	1246	5.2	8.5	1.27	2.08	3.67	2.08
3	1-4	53.84	68	20	60	5.208	25.0	66.8	33.3	1055	947	5.2	8.5	0.80	1.18	2.08
1	5-8	53.84	66	20	60	4.774	18.2	100	0	987	871	5.2	8.5	0.73	1.05	1.91
2	5-8	61.69	66	20	60	6.510	20.0	66.8	33.3	1318	1172	5.2	8.5	1.31	1.98	3.47
3	5-8	53.84	66	20	60	4.774	18.2	100	0	987	871	5.2	8.5	0.73	1.05	1.91


Span	Location	P
1 & 3	Full Length	1'-5 1/2"
2	End 15'	1'-5 1/2"
2	Rest of span	1'-4 1/2"

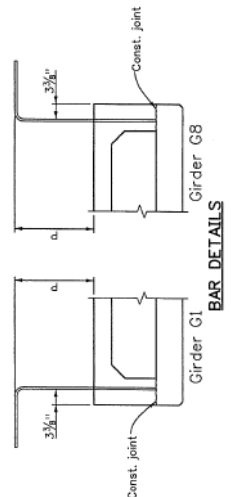

Checked By	DATE	Checked By	DATE	Checked By	DATE	Checked By	DATE
Checked by LIT	02/07	Checked by CJK	02/07	Checked by CJK	02/07	Checked by CJK	02/07
Checked by LIT	02/07	Checked by CJK	02/07	Checked by CJK	02/07	Checked by CJK	02/07

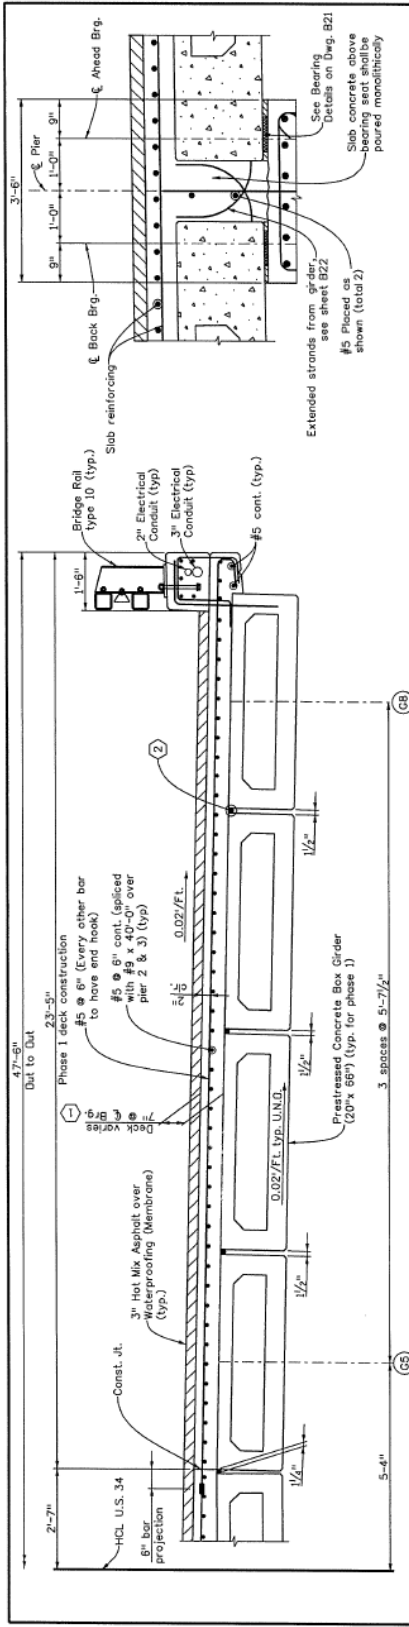

PIER DIAPHRAGM SECTION

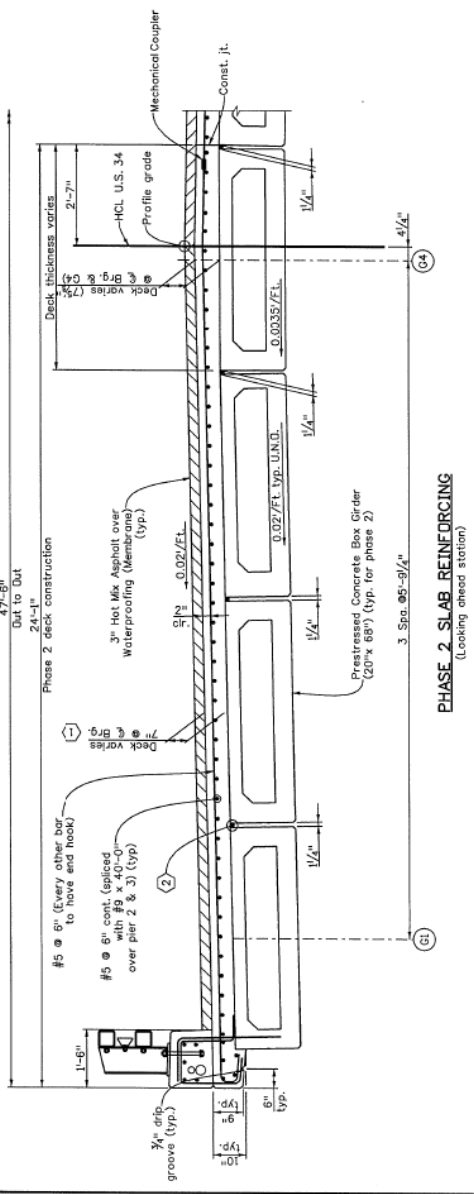

KEY NOTES

- See Deck Reinforcing plan on Dwg. B24 for deck thickness detail.
 - Setdapp prior to placement of deck concrete.
- NOTES**
- Dimensions to ϵ girder are measured at top of girder.
 - Deck shall be Concrete Class D (Bridge).
 - See "Deck Pier", Dwg. No. B24, for additional information.
 - Ends of Pier diaphragm shall be flush with edges of girders G1 & G8
 - Deck and Pier diaphragm shall be placed monolithically.

Print Date: 10/30/2007		Colorado Department of Transportation		As Constructed		Project No./Code	
File Name: 15549-9123-SuperDetails.dgn		2207 East Highway, 402		No Revisions: 11, 3, 0, 8		BR 0341-069	
Map: S001: 11		Phone: 970-662-4266		Revised:		C-15-AN	
Unit Information		Region 4		Void:		15549	
SCS/MARS STAINLESS HOLDINGS		DMM/MLR		Designer: C. Kline		Structure Numbers	
				Detailer: P. Hernandez		Sheet Number	
				Sheet Subject: BRIDGE		Sheet 823 of 38	
						57	

C-16-DI Construction Drawings

GENERAL NOTES

1. ALL STRUCTURAL STEEL SHALL BE A36 UNLESS OTHERWISE SPECIFIED.

2. ALL STRUCTURAL STEEL SHALL BE A572 UNLESS OTHERWISE SPECIFIED.

3. ALL STRUCTURAL STEEL SHALL BE A572 UNLESS OTHERWISE SPECIFIED.

4. ALL STRUCTURAL STEEL SHALL BE A572 UNLESS OTHERWISE SPECIFIED.

5. ALL STRUCTURAL STEEL SHALL BE A572 UNLESS OTHERWISE SPECIFIED.

6. ALL STRUCTURAL STEEL SHALL BE A572 UNLESS OTHERWISE SPECIFIED.

7. ALL STRUCTURAL STEEL SHALL BE A572 UNLESS OTHERWISE SPECIFIED.

8. ALL STRUCTURAL STEEL SHALL BE A572 UNLESS OTHERWISE SPECIFIED.

9. ALL STRUCTURAL STEEL SHALL BE A572 UNLESS OTHERWISE SPECIFIED.




10. ALL STRUCTURAL STEEL SHALL BE A572 UNLESS OTHERWISE SPECIFIED.

INDEX OF DRAWINGS

NO.	DESCRIPTION	DATE	BY	CHKD.
1	GENERAL INFORMATION - SUMMARY OF QUANTITIES			
2	GENERAL LAYOUT			
3	BRIDGE WEARABLE INFORMATION			
4	BRIDGE DECK ELEVATIONS			
5	BRIDGE DECK ELEVATIONS			
6	BRIDGE DECK ELEVATIONS			
7	BRIDGE DECK ELEVATIONS			
8	CONSTRUCTION LAYOUT			
9	FOUNDATION LAYOUT			
10	FOUNDATION DETAILS			
11	FOUNDATION DETAILS			
BRIDGE HYDRAULIC INFORMATION

PROJECT NO.	DATE	SCALE
FR70 108 (0) 2.3		
NO REVISIONS	AS CONSTRUCTED	VOID

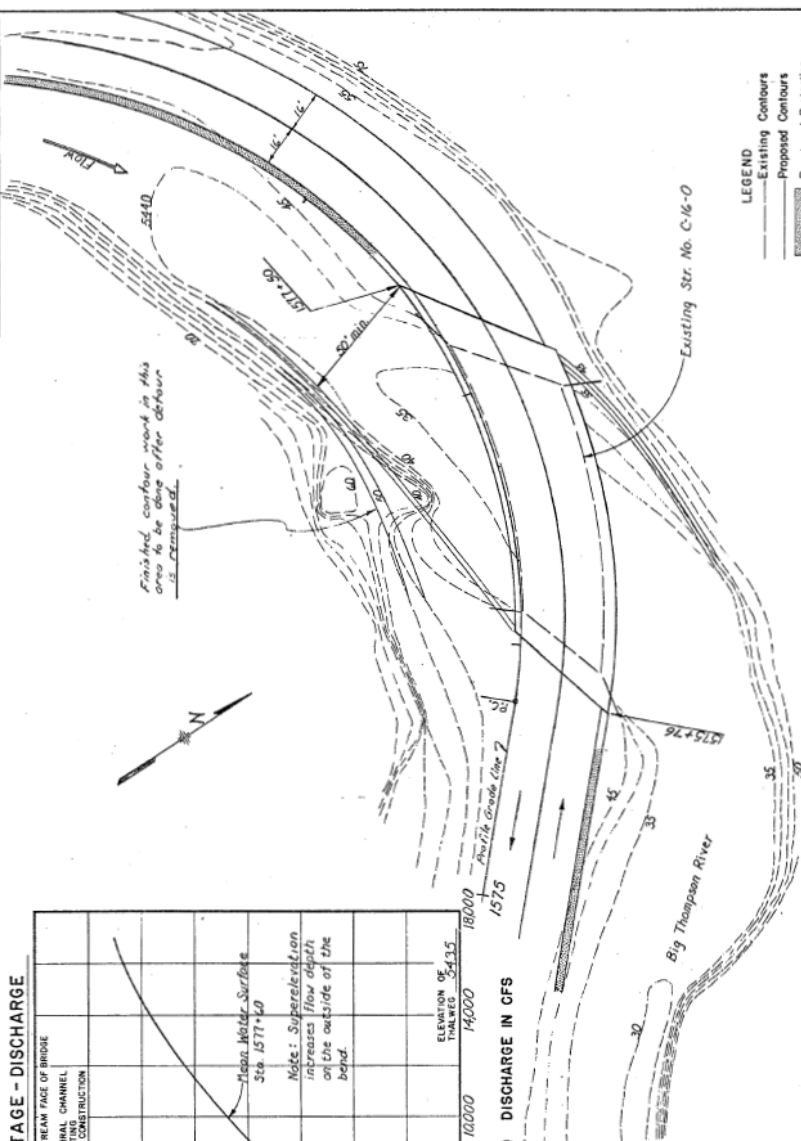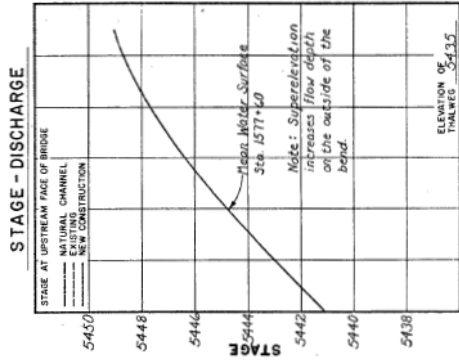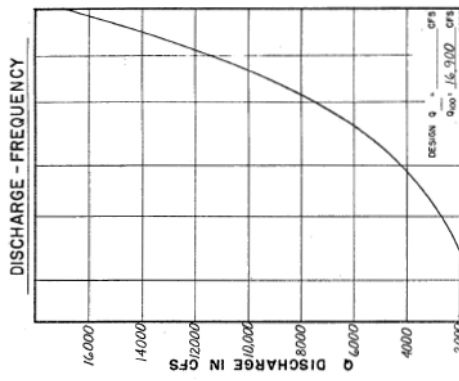

Q DISCHARGE IN CFS

RECURRENT INTERVAL IN YEARS

Drainage Area 30.3 Sq. Mi.

CHANNEL DESCRIPTION

Bottom Material — Cohesive Non Cohesive

Bottom Material Size — Clay Silt Sand Gravel

Cobbles Other Boulders

Stream Form — Straight Meandering Braided

Manning's "n" for Design — Channel .033 Overbank

Debris — Brush Trees/Logs Ice Other

COMPARISON OF HYDRAULICS

	Velocity - fps	Froude No.	Max. Backwater
Natural Channel			
Existing			
Proposed	<u>2.5</u>	<u>1.2</u>	<u>0</u> ft

*At proposed bridge location during design discharge

COMMENTS

Since a retaining wall is proposed along the shoulder, a comparison of natural and existing channel hydraulics is of no value. Flow is supercritical.

LEGEND

Existing Contours
Proposed Contours
Retainment Protection
Abutment
Wall

DEPARTMENT OF HIGHWAYS
STATE OF COLORADO

BRIDGE HYDRAULIC INFORMATION
Big Thompson River


Drawn by [Name] Approved by [Name]
Scale 1" = 100' Date Sept. 8, 1971

STRUCTURE NO. C-16-02

NO REVISIONS	AS CONSTRUCTED	REVISION	NO.	DATE

DESIGNER	DATE	SCALE	SHEET NO.	TOTAL SHEETS
ERFD 165 (10)			28	

REVISIONS

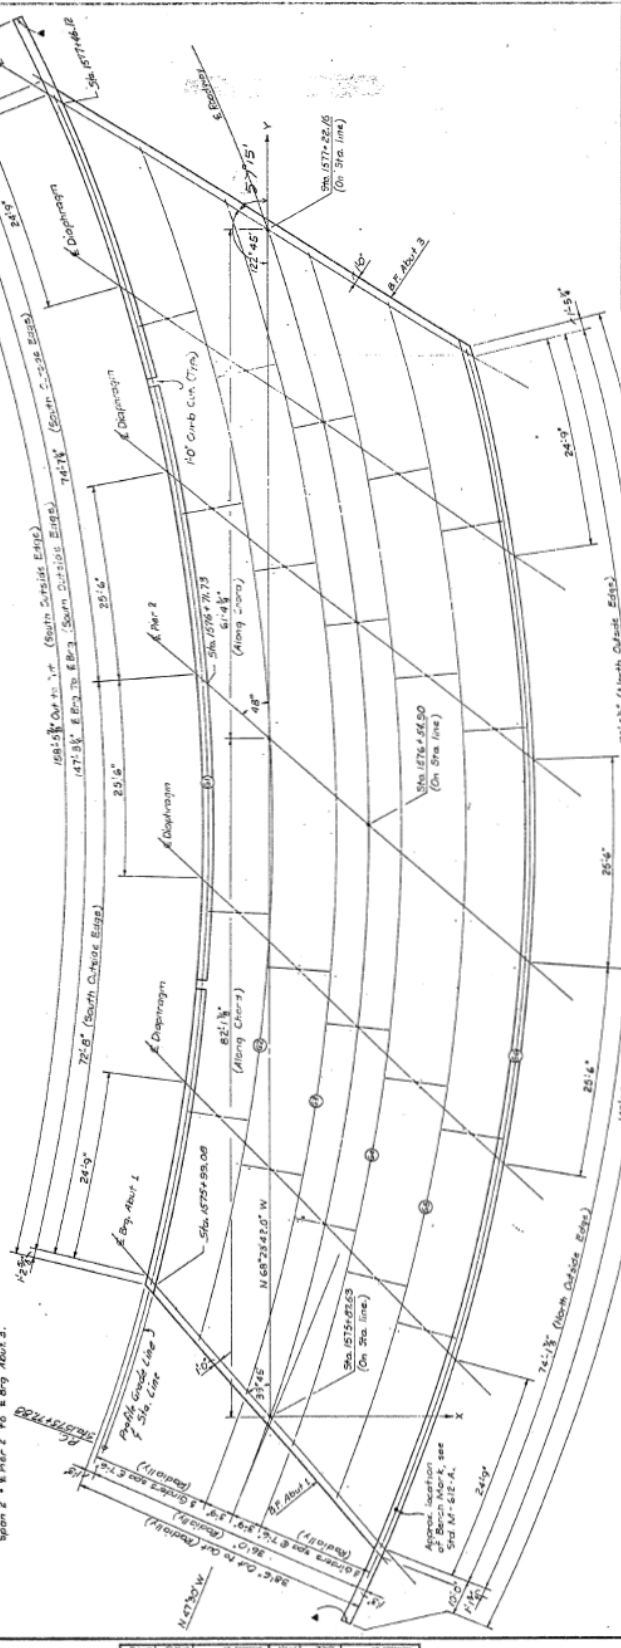

DIVISION OF HIGHWAYS

CONSTRUCTION LAYOUT

Project No.	165 (10)
Sheet No.	28
Scale	1" = 40'
Author	ERFD
Checked	ERFD
Approved	ERFD

Line	Station	Radius	Chord	Angle	Area
1	1574+82.63	72.54	72.54	90°	2531.5
2	1575+00.00	72.54	72.54	90°	2531.5
3	1575+17.37	72.54	72.54	90°	2531.5
4	1575+34.73	72.54	72.54	90°	2531.5
5	1575+52.10	72.54	72.54	90°	2531.5
6	1575+69.46	72.54	72.54	90°	2531.5
7	1575+86.83	72.54	72.54	90°	2531.5
8	1576+04.19	72.54	72.54	90°	2531.5
9	1576+21.56	72.54	72.54	90°	2531.5
10	1576+38.92	72.54	72.54	90°	2531.5
11	1576+56.29	72.54	72.54	90°	2531.5
12	1576+73.65	72.54	72.54	90°	2531.5
13	1576+91.02	72.54	72.54	90°	2531.5
14	1577+08.38	72.54	72.54	90°	2531.5
15	1577+25.75	72.54	72.54	90°	2531.5
16	1577+43.11	72.54	72.54	90°	2531.5
17	1577+60.48	72.54	72.54	90°	2531.5
18	1577+77.84	72.54	72.54	90°	2531.5
19	1577+95.21	72.54	72.54	90°	2531.5
20	1578+12.57	72.54	72.54	90°	2531.5



Span 1 - E. Brg. Abut. 1 to E. Pier 2.
 Span 2 - E. Pier 2 to E. Brg. Abut. 3.

For details on X.Y. construction, see Erection Draw. No. E.5-1.
 For dimension details, see Draw. No. E.5-2.
 For curb surf details, see Draw. No. E.5-3.
 For details of construction to precast panel wall, see Draw. No. E.5-4.

Station	Left	Right
1574+82.63	1574+82.63	1574+82.63
1575+00.00	1575+00.00	1575+00.00
1575+17.37	1575+17.37	1575+17.37
1575+34.73	1575+34.73	1575+34.73
1575+52.10	1575+52.10	1575+52.10
1575+69.46	1575+69.46	1575+69.46
1575+86.83	1575+86.83	1575+86.83
1576+04.19	1576+04.19	1576+04.19
1576+21.56	1576+21.56	1576+21.56
1576+38.92	1576+38.92	1576+38.92
1576+56.29	1576+56.29	1576+56.29
1576+73.65	1576+73.65	1576+73.65
1576+91.02	1576+91.02	1576+91.02
1577+08.38	1577+08.38	1577+08.38
1577+25.75	1577+25.75	1577+25.75
1577+43.11	1577+43.11	1577+43.11
1577+60.48	1577+60.48	1577+60.48
1577+77.84	1577+77.84	1577+77.84
1577+95.21	1577+95.21	1577+95.21
1578+12.57	1578+12.57	1578+12.57

DESIGN NO.	38
DATE	
REVISED	
BY	
CHECKED	
APPROVED	


NO REVISIONS	2
NO REVISIONS	2
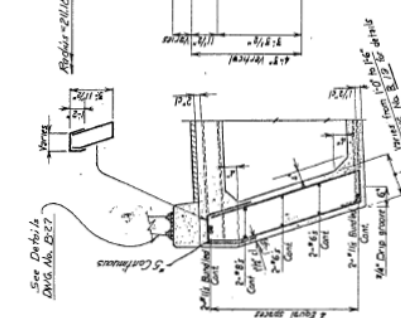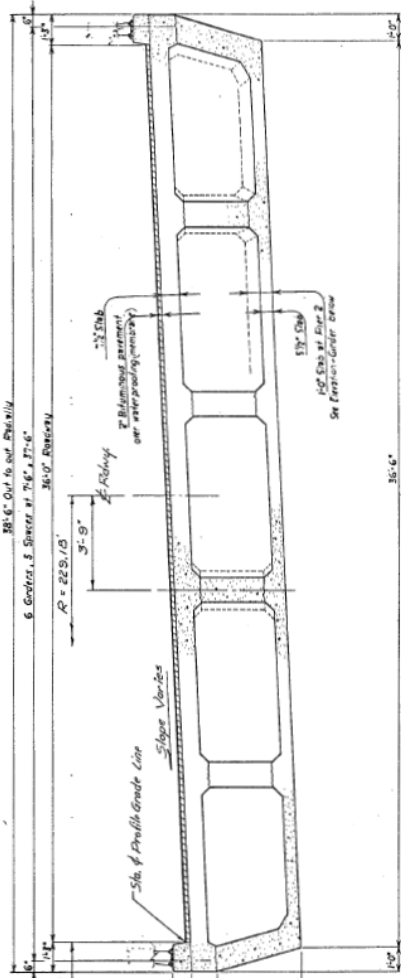

TYPICAL SECTION THRU INTERIOR GIRDER


TYPICAL SECTION THRU SUPERSTRUCTURE

TYPICAL SECTION THRU EXTREME GIRDER

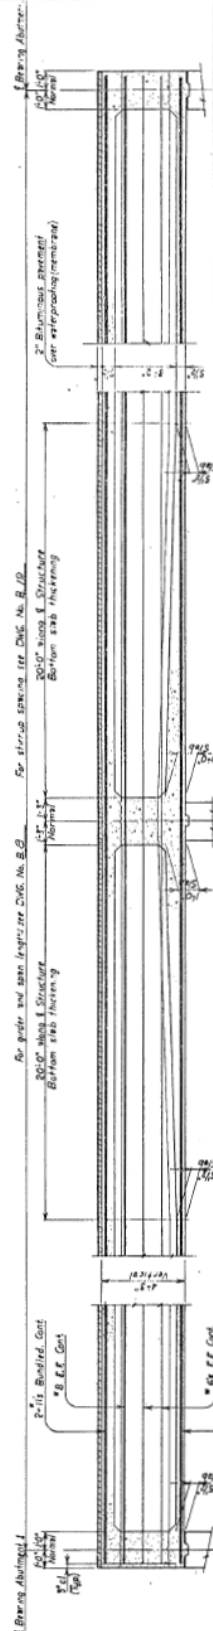

DIVISION OF HIGHWAYS	
SUPERSTRUCTURE DETAILS	
Diagrams of Girders	Revisions C-15-67
Diagrams of Abutments	Revisions
Diagrams of Piers	Revisions
Diagrams of Deck	Revisions
Diagrams of Other	Revisions

1.0	0.00	0.01	0.02	0.03	0.04	0.05	0.06	0.07	0.08	0.09	0.10	0.11	0.12	0.13	0.14	0.15	0.16	0.17	0.18	0.19	0.20	
Symmetrical about P. Pier 2																						

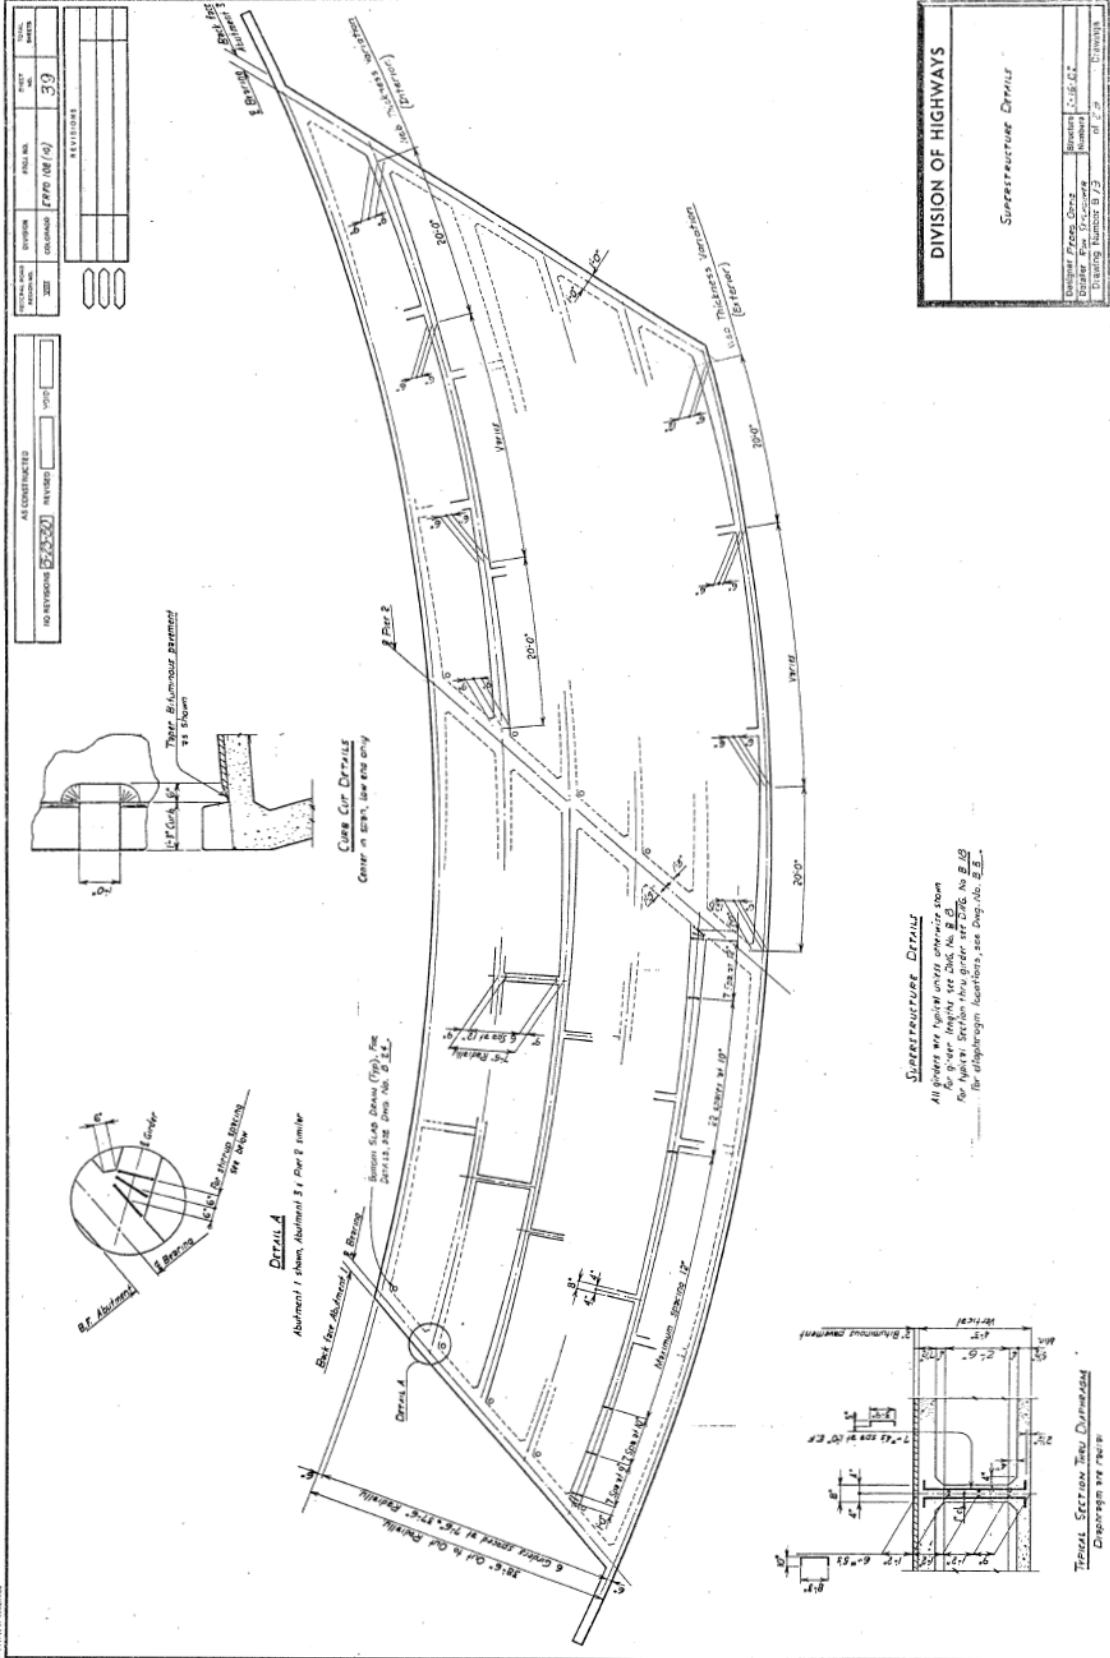

NO REVISIONS	AS CONSTRUCTED	DATE	BY
5/23/20			

REVISIONS	NO.	DATE	BY
39			

DIVISION OF HIGHWAYS	
SUPERSTRUCTURE DETAILS	
Designer: Frank G. ...	Checked: C. B. ...
Draftsman: ...	Number: ...
Drawing Number: B 23	of 23

SUPERSTRUCTURE DETAILS
 All girders are light weight composite beam
 for 9' clear height see Det. No. B 2
 for typical section thru girder see Det. No. B 10
 for diaphragm connections, see Det. No. B 11.

NO.	DATE	BY	REVISION
1	5/23/20

APPENDIX B. LOGNORMAL PARAMETERS FOR NEGATIVE MOMENT FRAGILITIES

Table 1. Lognormal parameters for negative moment fragilities

Bridge	Girder location	Parameters	
		λ	ξ
C-15-AM	Exterior	-1.029	0.794
	Interior	-0.903	0.781
C-15-AL	Exterior	-0.985	0.518
	Interior	-0.877	0.495
C-15-O	Exterior	-2.812	1.254
	Interior	-2.785	1.252
C-15-U	Exterior	4.765	2.586
	Interior	6.509	2.655
C-15-Y	Exterior	-1.393	0.427
	Interior	-1.365	0.415
C-15-C	Exterior	-3.016	2.068
	Interior	-3.003	2.083
C-15-AN	Exterior	-3.905	5.273
	Interior	-4.401	5.871
C-16-DI	Exterior	-6.141	3.161
	Interior	-5.967	3.148